CF *THIS PERMIT VOIDS PREVIOUS PERMITS ISSUED ON LOTS 21 AND 22.

IREDELL COUNTY HEALTH DEPARTMENT

STATESVILLE 704-878-5305 MOORESVILLE 704-664-5281

IMPROVEMENT PERMIT / AUTHORIZATION TO CONSTRUCT / OPERATION PERMIT / EXISTING SYSTEM INSPECTION

PERMIT# 139846 PIN# 4741-87-4426 DATE 12-19-06

OWNER OR APPLICANT WILLIAM BRENSTER CO. PHONE: Business 704-895-0556 Home

ADDRESS P.O. BOX 99 DAVIDSON, NC 28036

LOCATION I-77 S., (R) AMITY HILL RD., (L) MURDOCK RD. (L) HOOVER RD, (L) MARTHAS VINEYARD, (R) PAINTED BUNTING, LOT ON LEFT.

SUBDIVISION MARTHAS VINEYARD BLOCK / SECTION 2 LOT 21+22 LOT AREA 1.92 ACRES SITE CLASS. PS DESIGN FLOW 360 GPD L.T.A.R. 0.225 GPD/FT²

Septic Tank: 1,000 Gallons; STB 10/0 Date 11-7-06
Pump Tank: 1,000 Gallons; PT 11 Date 3-20-06
Pump Make: Gould Model URCSR1HH Serial No: [redacted]
Nitrification Field: No Fields 1 Square Feet EQ to 1,600 Linear Feet 400'
No Lines 5@80' Trench Width 36" Max Trench Bottom Depth 36"

☒ New System ☐ Repair ☐ Expansion System Type: I II (III) IV V VI
System Description: 25% REDUCTION, PUMP
Repair System Description: 25% REDUC, LOW PRESSURE
Maintenance Agreement Required: ☐ Yes ☒ No

☒ House/Mod. Home No. Bedrooms 3
☐ Mobile Home No. Persons
☐ Business No. Employees
☐ Other


Water Supply: ☒ Individual WELL ☐ Public ☐ Community

Gravel Depth N/A ☐ Gravity ☒ Pressure ☐ Slab ☒ Crawl Space ☐ Basement w/plumbing ☐ Basement wo/plumbing

Comments:/Conditions: (1) SEE ATTACHED PUMP AND PRESSURE MANIFOLD INFO SHEETS. (2) KEEP WELL 100' OR GREATER FROM SEPTIC OR REPAIR AREA.

Comments:/Conditions: Pump tank has Rugged Septic tank has Rugged Gilbert tuf-tite lids

INITIAL SITE SKETCH

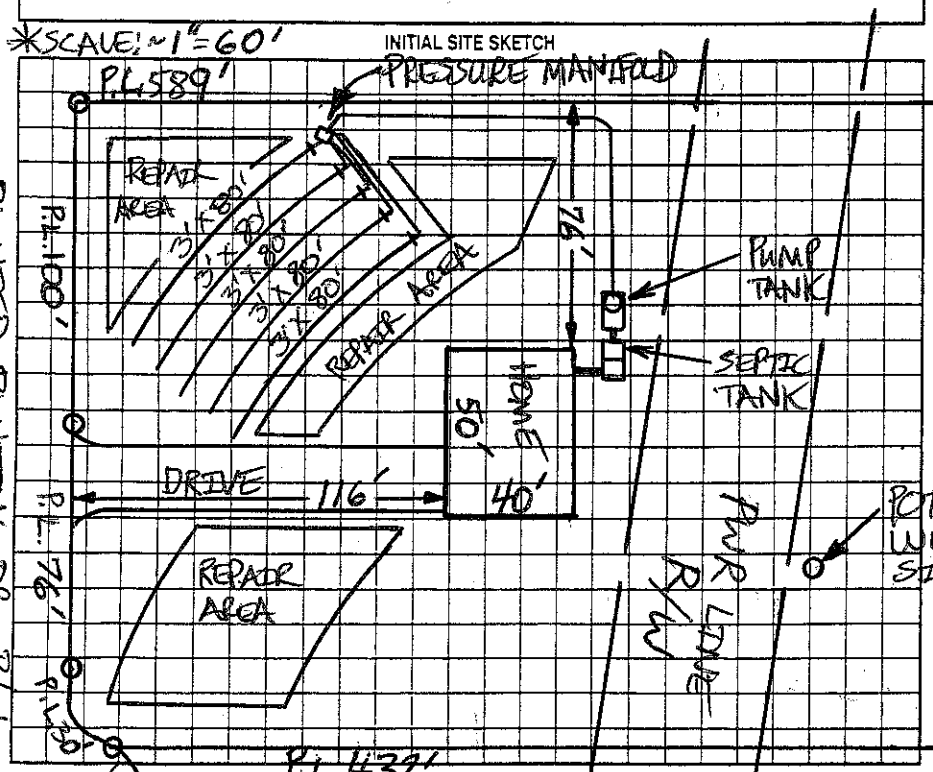

AS BUILT SKETCH

Permit can be suspended or revoked if any false information is supplied toward securing the permit/any unauthorized changes are made to the site/any unauthorized changes are made in the installation of the system. Improvement Permit with plat valid without expiration ☐ Improvement Permit with site plan valid for sixty months ☒ Authorization to Construct is valid for a period equal to that of Improvement Permit – not to exceed sixty months.

Signed: [signature] date 1-5-06 Installed by: A-1 Backhoe

Improvement Permit by: STEVE HEDRICK date 12-19-06 Operation Permit by: [signature] date 29 May 07

Authorization to Construct by: STEVE HEDRICK date 12-19-06 Existing System Inspection by: date

HEALTH DEPT. COPY: WHITE OWNER COPY (FINAL): YELLOW OWNER COPY (INITIAL): PINK