704-664-4533

IREDELL COUNTY HEALTH DEPARTMENT

THIS PERMIT VOIDS PREVIOUS ISSUED 8-3-2001

STATESVILLE 704-878-5305 MOORESVILLE 704-664-5281

IMPROVEMENT PERMIT / AUTHORIZATION TO CONSTRUCT / OPERATION PERMIT / EXISTING SYSTEM INSPECTION

PERMIT# 100702 PIN# 4741-87-5927 DATE 9-2-04

OWNER OR CONTRACTOR WILLIAM BREWSTER, Co. PHONE: Business 704-895-0556 Home 704-400-5066

ADDRESS P.O. Box 99 DAVIDSON NC 28036

LOCATION US21 S, TL MURDOCK RD, TR HOOVER RD, TL MARTHA'S VINEYARD, TR PAINTED BUNTING, TL SCARLETT TANAGER, END ON Right


SUBDIVISION MARTHA'S VINEYARD BLOCK / SECTION II LOT 54 LOT AREA 1.288 Acres SITE CLASS. PS DESIGN FLOW 360 L.T.A.R. 0.30 GPD/FT²

Septic Tank: 1000 Gallons; STB 1012 Date 12-3-04	☑ New System ☐ Repair System Type: I, II, III, IV, V, VI	☑ House/Mod. Home No. Bedrooms 3	Water Supply: ☑ Individual ☐ Public ☐ Community
Pump Tank: 1000 Gallons; PT 17 Date 6-19-04	System Description: 50% REDUCTION, PUMP	☐ Mobile Home No. Bathrooms	
Pump Make: GOULDS Model WE05M1H Serial No. K046779	Repair System Description: 50% REDUCTION, LOW PRESSURE	☐ Business No. Employees	
Nitrification Field: No Fields 1 Square Feet 1200 Linear Feet 200	Maintenance Agreement Required: ☐ Yes ☑ No	☑ Other	
No Lines FOUR Trench Width 24" Max Trench Bottom Depth 36" ~~Gravel~~ Depth SAND 24"	☐ Slab ☑ Crawl Space ☐ Basement w/plumbing ☐ Basement wo/plumbing		WELL


Comments:/Conditions: INSTALL 50% REDUCTION SYSTEM USING 48 PPBPS PANELS. KEEP SYSTEM MINIMUM 100' FROM WELL. SEE ATTACHED SHEETS FOR PUMP & PRESSURE MANIFOLD REQUIREMENTS.

Comments:/Conditions: ZABEL FILTER & MARKER
* V / INLES & TANKS LL 12-6-04
NEED TANK APPROVAL FOR CHANGE
DEL TO TANKS 105'

INITIAL SITE SKETCH

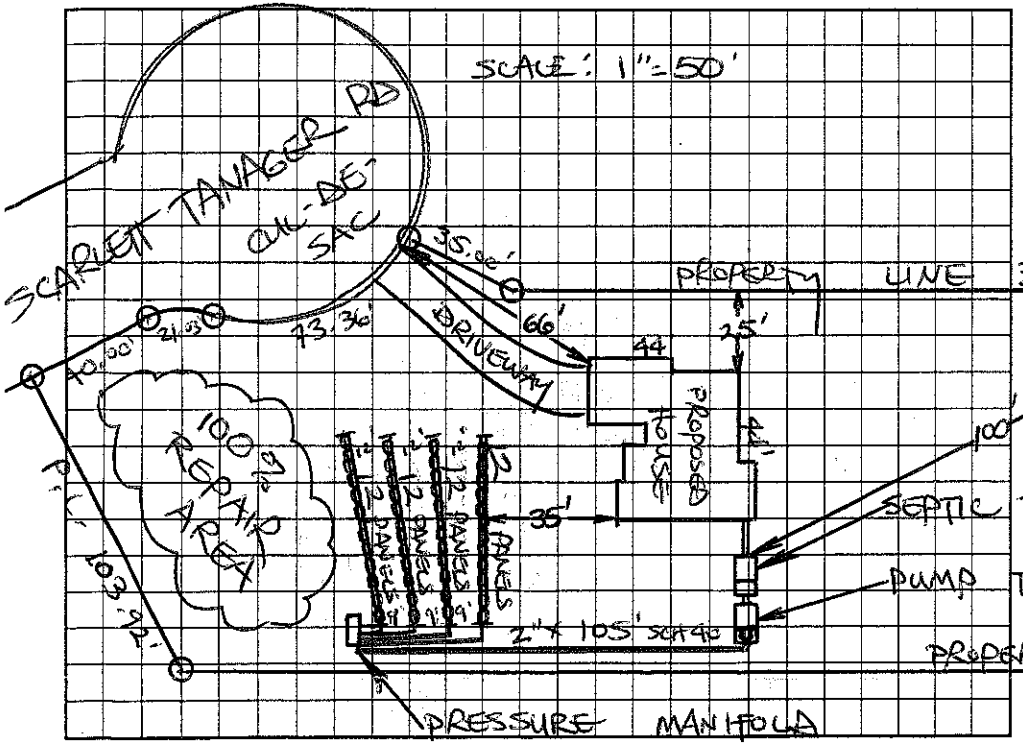

AS BUILT SKETCH

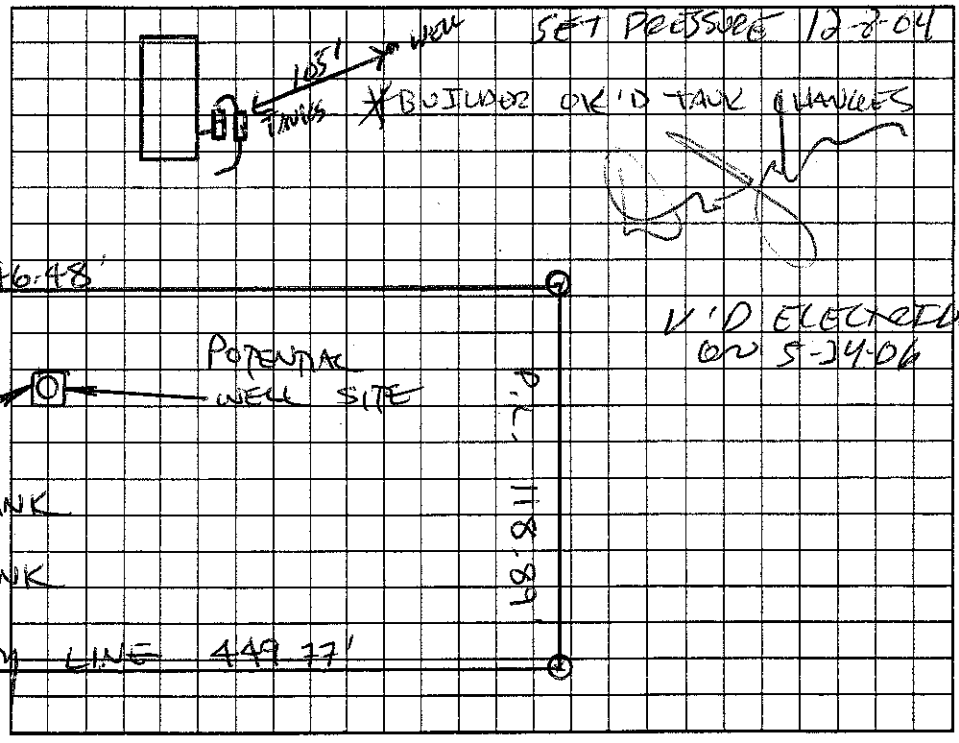

Permit can be suspended or revoked if any false information is supplied toward securing the permit/any unauthorized changes are made to the site/any unauthorized changes are made in the installation of the system. Improvement Permit with plat valid without expiration. Improvement Permit with site plan valid for sixty months. Authorization to Construct is valid for a period equal to that of Improvement Permit – not to exceed sixty months.

Signed: [signature] date 9-7-04 Installed by: A-1 BACKHOE

Improvement Permit by: STEVE HEDRICK date 9-2-04 Operation Permit by: [signature] date 5-24-06

Authorization to Construct by: STEVE HEDRICK date 9-2-04 Existing System Inspection by: _____ date _____

HEALTH DEPT. COPY: WHITE OWNER COPY (FINAL): YELLOW OWNER COPY (INITIAL): PINK