IREDELL COUNTY HEALTH DEPARTMENT

THIS PERMIT VOIDS PREVIOUS ISSUED 3-6-2007

STATESVILLE 704-878-5305 (CV) MOORESVILLE 704-664-5281

IMPROVEMENT PERMIT / AUTHORIZATION TO CONSTRUCT / OPERATION PERMIT / EXISTING SYSTEM INSPECTION

PERMIT# 14178 PIN# 4741-87-6989 DATE 6-9-2007

OWNER OR APPLICANT WILLIAM BREWSTER CO, INC PHONE: Business 704-895-0556 Home

ADDRESS P.O. BOX 99 DAVIDSON NC 28036

LOCATION HOOVER ROAD TO MARTHA'S VINEYARD TR' PAINTED BUNTING, TL SCARLET TANAGER, LOT AT END

SUBDIVISION MARTHA'S VINEYARD BLOCK / SECTION LOT 53' LOT AREA 1.50 ACRES SITE CLASS. PS DESIGN FLOW 480 L.T.A.R. 0.25 GPD/FT²

Septic Tank: 1000 Gallons; STB 1012 Date 2-11-07

Pump Tank: Gallons; PT Date

Pump Make: Model EQ-PD Serial No.

Nitrification Field: No Fields 1 Square Feet 1920 Linear Feet 480

No Lines FIVE Trench Width 36" Max Trench Bottom Depth 36" Gravel Depth N/A ☑ Gravity ☐ Pressure

☑ New System ☐ Repair ☐ Expansion System Type: I II III IV V VI

System Description: 25% REDUCTION, GRAVITY

Repair System Description: 50% REDUCTION, LOW PRESSURE

Maintenance Agreement Required: ☐ Yes ☑ No

☑ House/Mod. Home No. Bedrooms 4

☐ Mobile Home No. Persons

☐ Business No. Employees

☐ Other


☐ Slab ☑ Crawl Space ☐ Basement w/plumbing ☐ Basement wo/plumbing

Water Supply: ☑ Individual ☐ Public ☐ Community WELL


Comments/Conditions: ① INSTALL 25% REDUCTION SYSTEM ON CONTOUR AS FLAGGED ② KEEP SYSTEM MAXIMUM FEASIBLE DISTANCE FROM WELLS NOT LESS THAN 50 FEET.

Comments/Conditions: SEPTIC TANK WITH MARKER INSTALLED USING "TUFFTITE" EFFLUENT FILTER

INITIAL SITE SKETCH

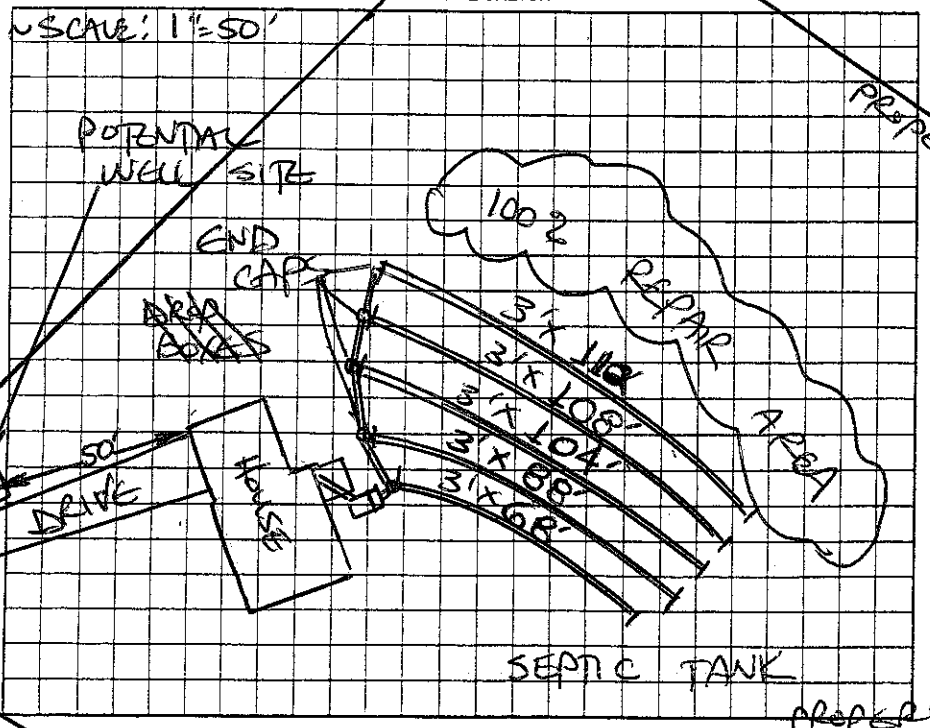

AS BUILT SKETCH

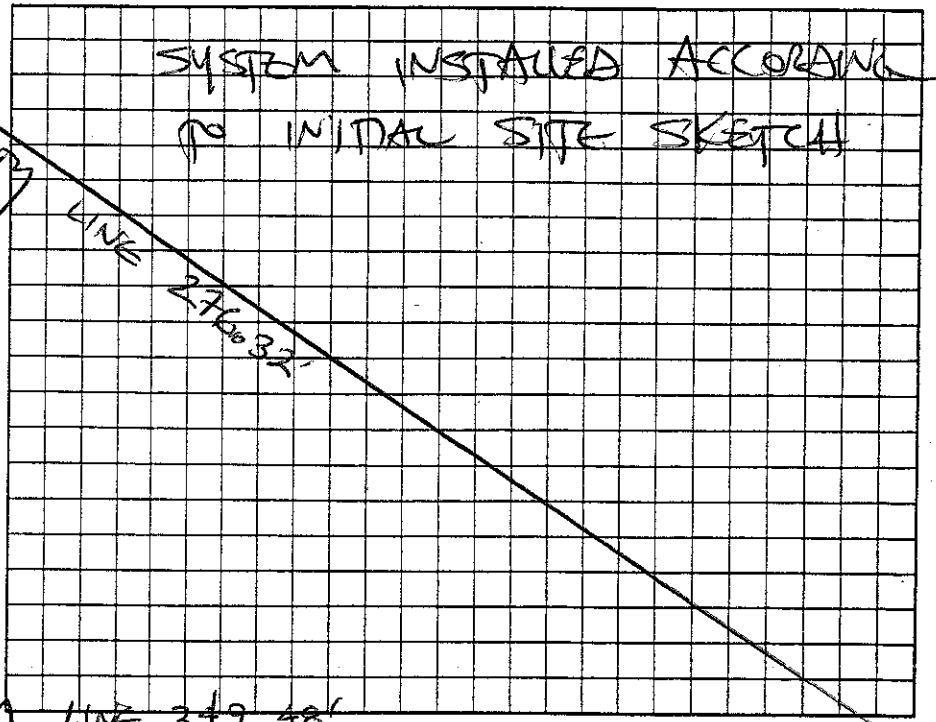

Permit can be suspended or revoked if any false information is supplied toward securing the permit/any unauthorized changes are made to the site/any unauthorized changes are made in the installation of the system. Improvement Permit with plat valid without expiration ☐ Improvement Permit with site plan valid for sixty months ☑ Authorization to Construct is valid for a period equal to that of Improvement Permit – not to exceed sixty months.

Signed: Dennis Gallihue date 6-11-07 Installed by: A-1 BACKHOE

Improvement Permit by: STEVE HEDRICK date 6-9-07 Operation Permit by: STEVE HEDRICK date 6-19-07

Authorization to Construct by: STEVE HEDRICK date 6-9-07 Existing System Inspection by: date

HEALTH DEPT. COPY: WHITE OWNER COPY (FINAL): YELLOW OWNER COPY (INITIAL): PINK