IREDELL COUNTY HEALTH DEPARTMENT

STATESVILLE 704-878-5305 MOORESVILLE 704-664-5281

IMPROVEMENT PERMIT / AUTHORIZATION TO CONSTRUCT / OPERATION PERMIT / EXISTING SYSTEM INSPECTION

CI

PERMIT# 100604 PIN# ~~4744-75-8148-PF~~ 4941-88-0244 DATE 7/25/01

OWNER OR CONTRACTOR WILLIAM BREWSTER PHONE: Business 845-0556 Home

ADDRESS PO BOX 99 DAVIDSON NC 28036

LOCATION 21S - TL MURDOCK - TR HOOVER - TL MARTHAS VINEYARD - TR PAINTED BUNTING - ON LEFT

SUBDIVISION MARTHAS VINEYARD BLOCK / SECTION II LOT 13 LOT AREA .8AC SITE CLASS. PS DESIGN FLOW 360GD L.T.A.R. .36GD/FT²

Septic Tank: 1000 Gallons; STB 1012 Date 7-26-04
Pump Tank: Gallons; PT Date
Pump Make: Model Serial No.
Nitrification Field: No Fields 1 Square Feet 1200 Linear Feet 400
No Lines 5@80' Trench Width 36" Max Trench Bottom Depth 36"

☑ New System ☐ Repair System Type: I, II, III, IV, V, VI
System Description: GRAVITY CONVENTIONAL
Repair System Description: INNOVATIVE
Maintenance Agreement Required: ☐ Yes ☑ No

☑ House/Mod. Home No. Bedrooms 3
☐ Mobile Home No. Bathrooms 3
☐ Business No. Employees
☐ Other


Gravel Depth 12" ☐ Slab ☑ Crawl Space ☐ Basement w/plumbing ☐ Basement wo/plumbing

Water Supply: ☑ Individual ☐ Public ☐ Community


Comments:/Conditions:

Comments:/Conditions: ① KEEP FILL TO TANK WITH STUBOUT OR PUMP WILL BE REQUIRED ② APPROVED 46'x36' HOUSE PLAN FOR THE AC

INITIAL SITE SKETCH 1"=50'

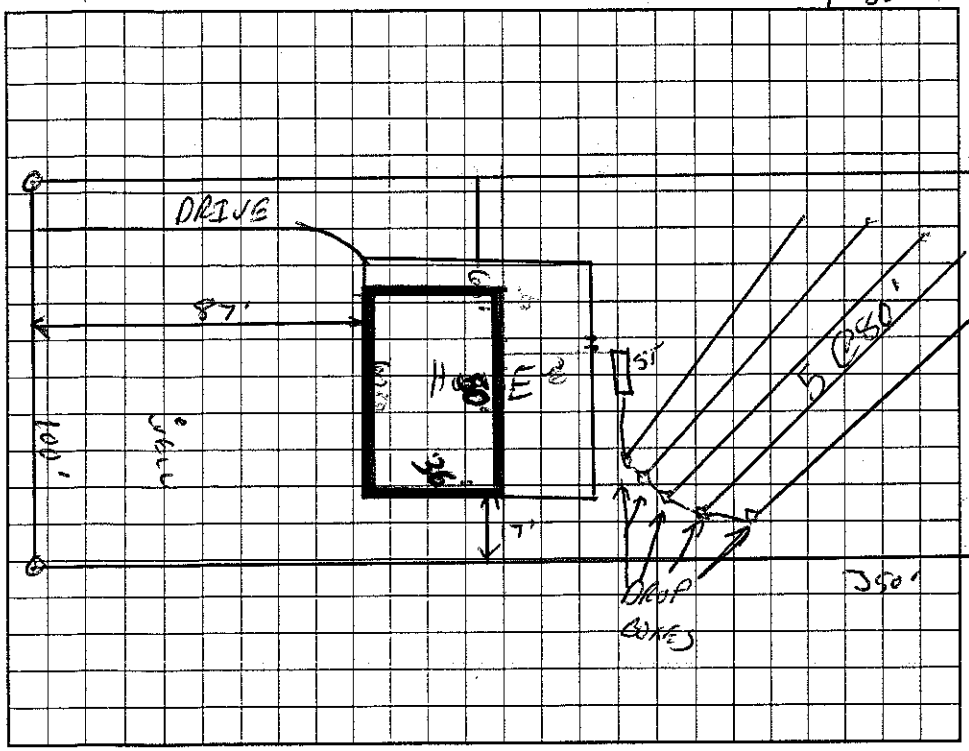

AS BUILT SKETCH

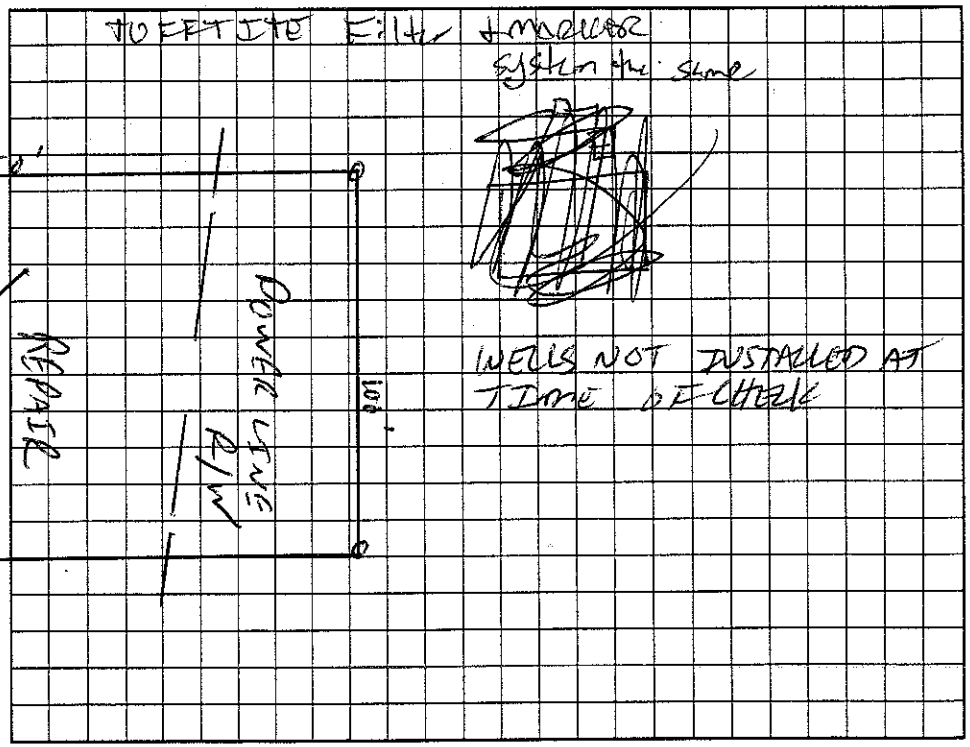

Permit can be suspended or revoked if any false information is supplied toward securing the permit/any unauthorized changes are made to the site/any unauthorized changes are made in the installation of the system. Improvement Permit with plat valid without expiration. Improvement Permit with site plan valid for sixty months. Authorization to Construct is valid for a period equal to that of Improvement Permit – not to exceed sixty months.

Signed: date 10/8/01 Installed by: A-1 BACKHOE

Improvement Permit by: RS date 7/25/01 Operation Permit by: RS date 2-23-05

Authorization to Construct by: date 12/29/04 Existing System Inspection by: date

HEALTH DEPT. COPY: WHITE OWNER COPY (FINAL): YELLOW OWNER COPY (INITIAL): PINK