IREDELL COUNTY HEALTH DEPARTMENT

STATESVILLE 704-878-5305 MOORESVILLE 704-664-5281

IMPROVEMENT PERMIT / AUTHORIZATION TO CONSTRUCT / OPERATION PERMIT / EXISTING SYSTEM INSPECTION

PERMIT# 100689 PIN# 4741-88-2739 DATE 7-26-05

OWNER OR CONTRACTOR William BREWSTER PHONE: Business 704-845-0556 EXT 206 Home

ADDRESS PO BOX 99 DAVIDSON, NC 28036

LOCATION 215 (E) MOORESVILLE (R) HOOVER (L) MARTHA VINEYARD (R) PARTED BUTTS (L) SCARLET LOT # 46 ON LEFT

SUBDIVISION MARTHA VINEYARD BLOCK / SECTION II LOT 46 LOT AREA 2.16AC SITE CLASS. PS DESIGN FLOW 420 TANKSIZE L.T.A.R. .3

Septic Tank: 1000 Gallons; STB 1012 Date 7-27-05

Pump Tank: 1000 Gallons; PT 14 Date 7-27-05

Pump Make Model Serial No.

Nitrification Field: No Fields 1 Square Feet EQ=1600 Linear Feet 272'

No Lines 8x34' Trench Width 24" Max Trench Bottom Depth 36" Gravel Depth N/A

☒ New System ☐ Repair System Type: I, II, (III) IV, V, VI

System Description: PUMP 5040 REDUCT

Repair System Description: LP 5040 REDUCT

Maintenance Agreement Required: ☐ Yes ☒ No

☒ House/Mod. Home No. Bedrooms 4

☐ Mobile Home No. Bathrooms 2½

☐ Business No. Employees

☐ Other


☐ Slab ☒ Crawl Space ☐ Basement w/plumbing ☐ Basement wo/plumbing

Water Supply: ☐ Individual ☐ Public ☐ Community


Comments/Conditions: (1) WELL STAYED IN SAME LOCATION AS BRADY FREEMAN HAD PREVIOUSLY DRAWN IT & TANKS SLID DOWN THE HILL 20' (2) PREVIOUS SOIL WORK WAS DONE BY BRADY FREEMAN, RS & PROGRAM SPECIALIST II. ONE NEW HOLE WAS DUG DUE TO SYSTEM SLIDING DOWN HILL.

Comments/Conditions: (3) THIS PERMIT IS A REDRAW & VOIDS OUT PREVIOUSLY ISSUED PERMIT DATED 7-31-01. (4) INSTALL LINES ON CONTOURS & MAINTAIN SETBACKS (5) INSTALL 8 LINES / 34' LONG / SPLIT FED DOWN THE MIDDLE USING A PRESSURE MANIFOLD.

INITIAL SITE SKETCH

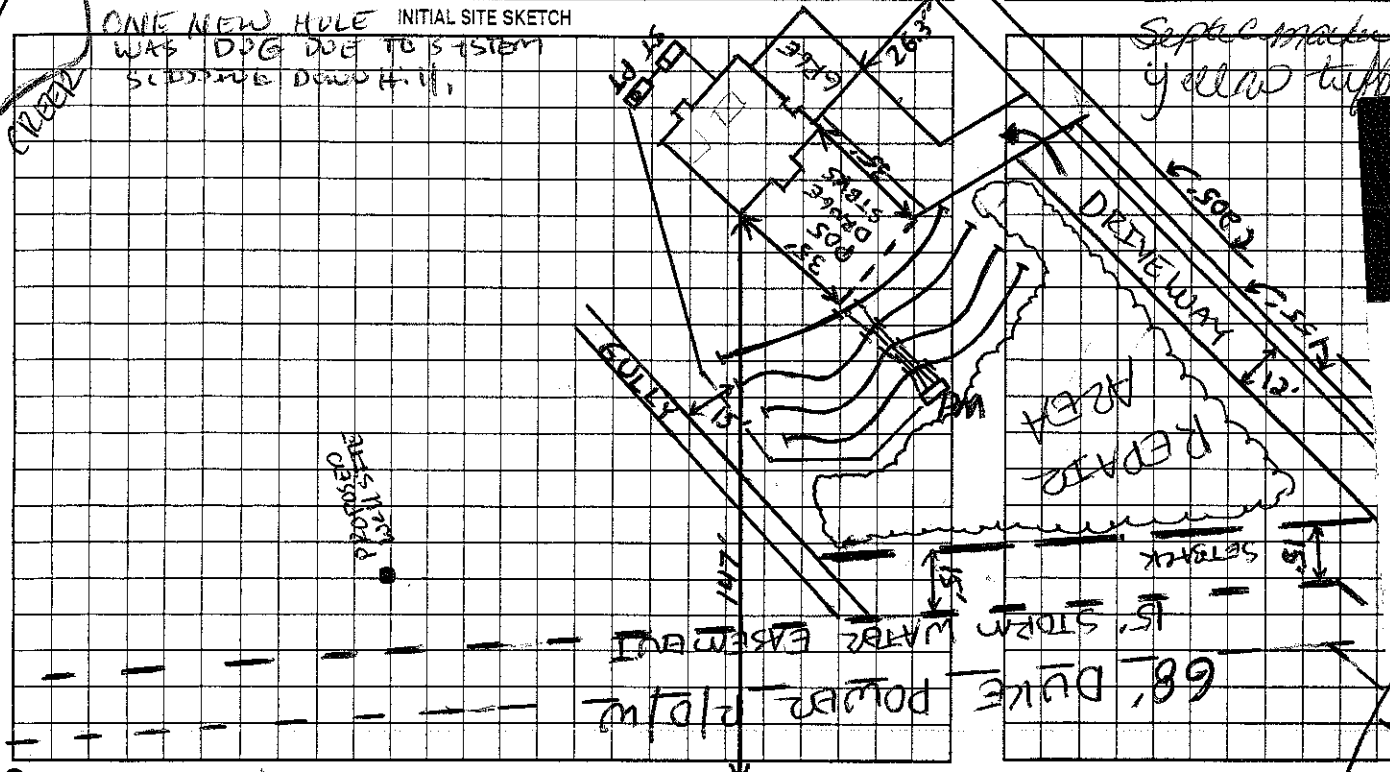

AS BUILT SKETCH

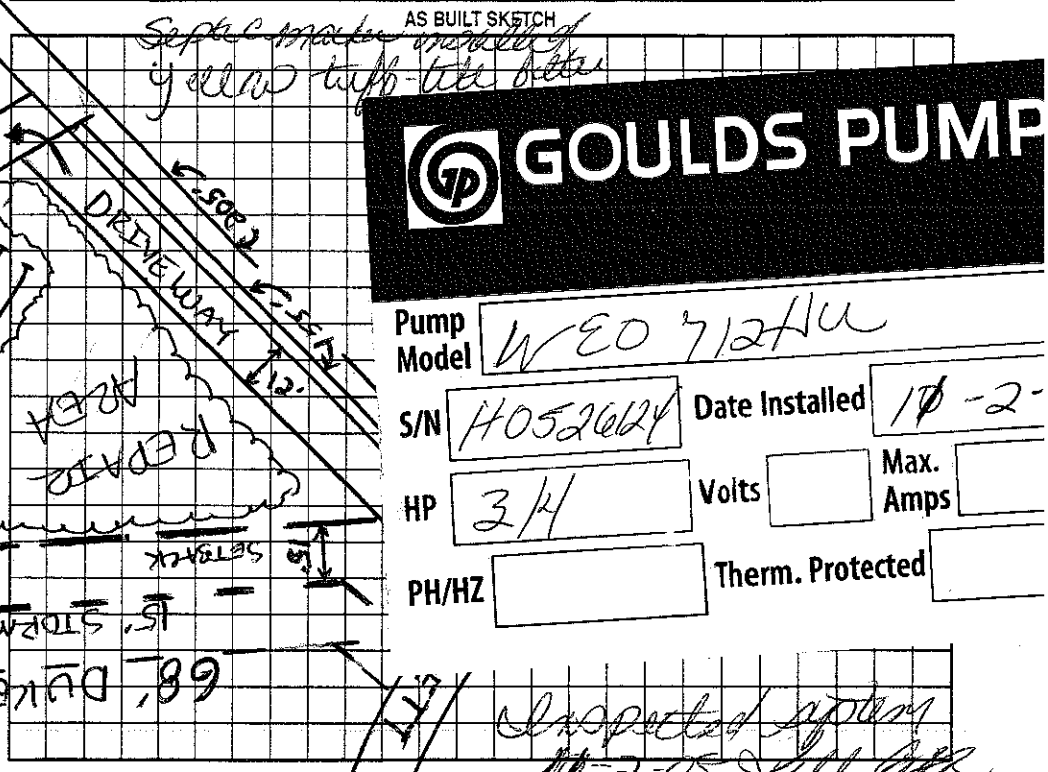

GOULDS PUMP

Pump Model WEO 712HC

S/N H0526624 Date Installed 10-2-

HP 3/4 Volts Max. Amps

PH/HZ Therm. Protected

Permit can be suspended or revoked if any false information is supplied toward securing the permit/any unauthorized changes are made to the site/any unauthorized changes are made in the installation of the system. Improvement Permit with plat valid without expiration. Improvement Permit with site plan valid for sixty months. Authorization to Construct is valid for a period equal to that of Improvement Permit – not to exceed sixty months.

Signed: Angie Blount date 8/3/05 Installed by: A-1 Backhoe

Improvement Permit by: [signature] date 7-26-05 Operation Permit by: [signature] date 12-27-05

Authorization to Construct by: [signature] date 7-26-05 Existing System Inspection by: date

HEALTH DEPT. COPY: WHITE OWNER COPY (FINAL): YELLOW OWNER COPY (INITIAL): PINK