IREDELL COUNTY HEALTH DEPARTMENT

STATESVILLE 704-878-5305 CI MOORESVILLE 704-664-5281

IMPROVEMENT PERMIT / AUTHORIZATION TO CONSTRUCT / OPERATION PERMIT / EXISTING SYSTEM INSPECTION

PERMIT# 100690 PIN# 4741-78-8448-AT 88-3676 DATE 7/31/01

OWNER OR CONTRACTOR WILLIAM BREWSTER PHONE: Business 895-0556 Home

ADDRESS PO BOX 94 DAVIDSON NC 28036

LOCATION 215-TL MURDOCK-TR HOOVER-TL MARTHAS VINEYARD-TR PAINTED BUNTING-TL SCARLETT TANAGER-ON LT

SUBDIVISION MARTHAS VINEYARD BLOCK / SECTION 2 LOT 47 LOT AREA .98 AC SITE CLASS. BS DESIGN FLOW 360GPD L.T.A.R. .36GPD/FT²

Septic Tank: 1000 Gallons; STB 10/2 Date 4-20-03
Pump Tank: 1000 Gallons; PT 17 Date 4-8-02
Pump Make: Gould Model WE03111M Serial No. G0361398
Nitrification Field: No Fields 1 Square Feet 900 Linear Feet 300
No Lines 4@75' Trench Width 36" Max Trench Bottom Depth 36" Gravel Depth N/A

☑ New System ☐ Repair System Type: I, II, III, IV, V, VI
System Description: Pump 25% REDUCTION
Repair System Description: SAME
Maintenance Agreement Required: ☐ Yes ☑ No

☑ House/Mod. Home No. Bedrooms 3
☐ Mobile Home No. Bathrooms 3
☐ Business No. Employees
☐ Other


Water Supply: ☑ Individual ☐ Public ☐ Community

☐ Slab ☐ Crawl Space ☑ Basement w/plumbing ☐ Basement wo/plumbing

Comments:/Conditions:


Comments:/Conditions: TUFF-TITE Filter + ST marker Installed ST+PT- Inspected, okay 10/24/03
Lines okay, pressure check okay 10/29/03 1/21/04

INITIAL SITE SKETCH 1"=50'

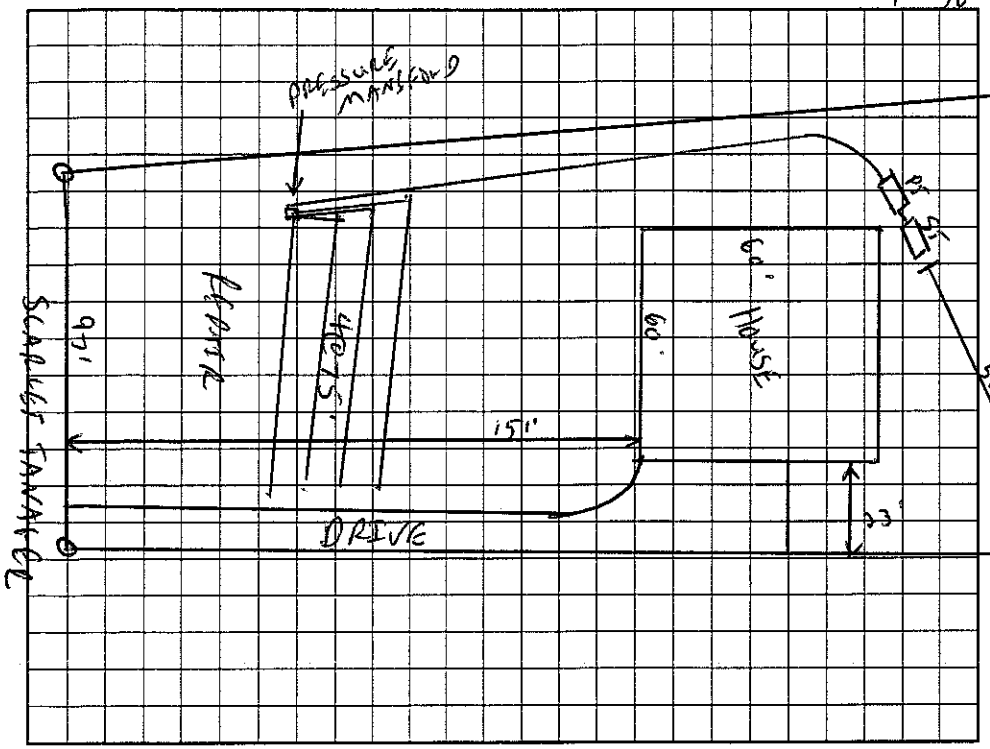

PL to PM - 25FT AS BUILT SKETCH Elec. Fire + Alarm okay

Lines moved uphill.

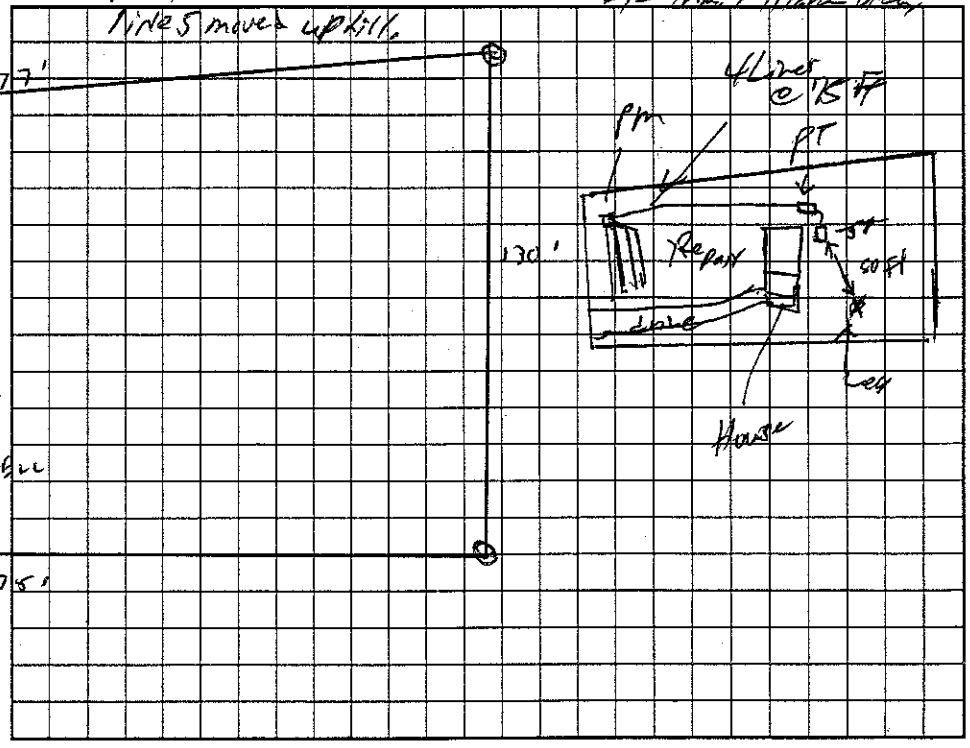

Permit can be suspended or revoked if any false information is supplied toward securing the permit/any unauthorized changes are made to the site/any unauthorized changes are made in the installation of the system. Improvement Permit with plat valid without expiration. Improvement Permit with site plan valid for sixty months. Authorization to Construct is valid for a period equal to that of Improvement Permit – not to exceed sixty months.

Signed: [signature] date 10/8/01 Installed by: A-1 Backhoe

Improvement Permit by: [signature] REHS date 7/31/01 Operation Permit by: William O. Johnson date 1/21/04

Authorization to Construct by: [signature] date 07/25/03 Existing System Inspection by: date

HEALTH DEPT. COPY: WHITE OWNER COPY (FINAL): YELLOW OWNER COPY (INITIAL): PINK