IREDELL COUNTY HEALTH DEPARTMENT - *ENVIRONMENTAL HEALTH* ☐ STATESVILLE OFFICE 704-878-5305 ☐ MOORESVILLE OFFICE 704-664-5281

IMPROVEMENT PERMIT / AUTHORIZATION TO CONSTRUCT / OPERATION PERMIT / EXISTING SYSTEM INSPECTION (a)

PERMIT # 167803 PIN # 4741-88-3676 DATE July 19, 2011

OWNER Joshua A. Eudy APPLICANT: - PHONE: Home/Cell # 704-773-4426 Business #

SITE ADDRESS 123 Scarlet Tanager Road OWNER / APPLICANT ADDRESS same

SITE DIRECTIONS Hoover Road to Marma's Vineyard Drive, TR Painted Bunting TL Scarlet Tanager 3rd on (L)

SUBDIVISION Marma's Vineyard BLOCK / SECTION 2 LOT # 47 LOT AREA 0.978 Acre DESIGN FLOW 360 L.T.A.R. 0.3 (EX)

Septic Tank 1000 Gallons: STB Date

Pump Tank 1000 Gallons: P T Date

Pump Make Model Serial #

No. Nitrification Fields: 1 No. Lines 4 Linear Feet 300

Trench Width 36" Max. Trench Bottom Depth 36" Gravel Depth N/A

☐ New System ☐ Repair ☐ Expansion System Type I II (III) V V VI

System Description: 25% Reduction, Press. Manifold

Repair System Description: 25% Reduction, Press. Manifold

Maintenance Agreement Required ☐ YES ☒ NO

☐ GRAVITY ☒ PRESSURE

☒ Residence No. Bedrooms 3

☐ Business No. Persons

☐ Other No. Employees

☐ Slab ☐ Crawl Space


☒ Basement w/plumbing ☐ Basement w/o plumbing

Water Supply: ☐ Private Well ☐ Public ☐ Community


Comments / Conditions

(1) Septic Tank is located less than 5' from deck post (2) Keep swimming pool minimum 15 feet (fifteen feet) from septic system.

INITIAL SITE SKETCH

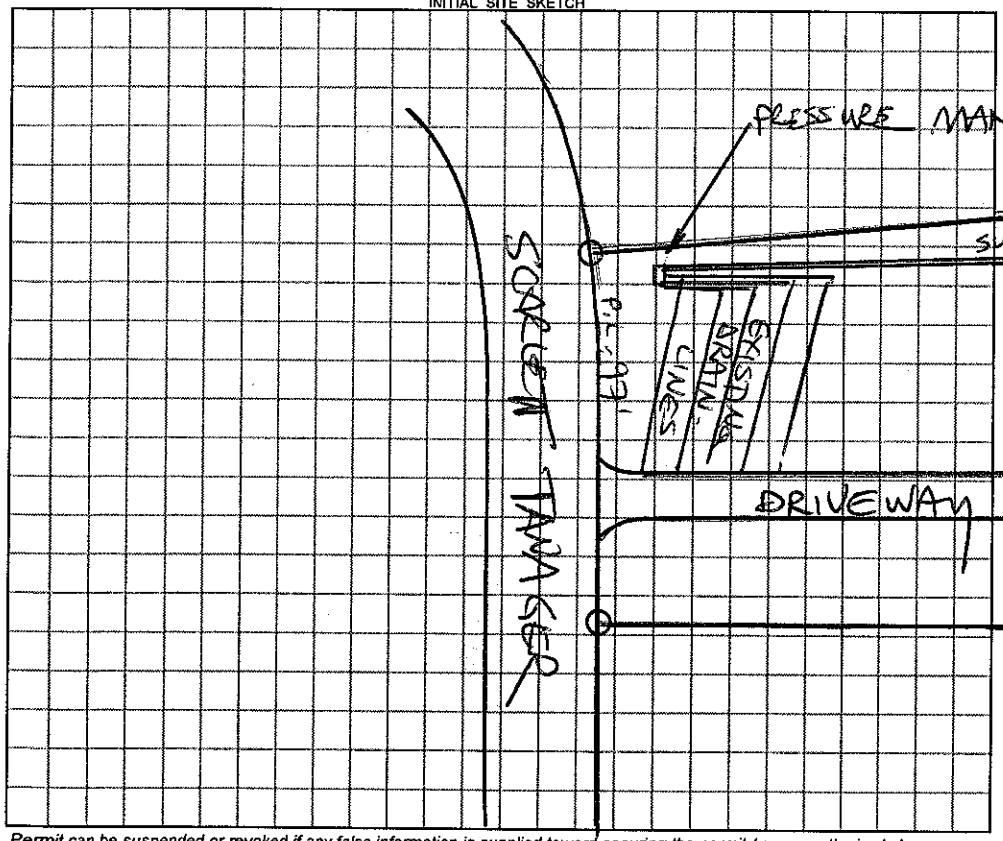

AS BUILT SKETCH

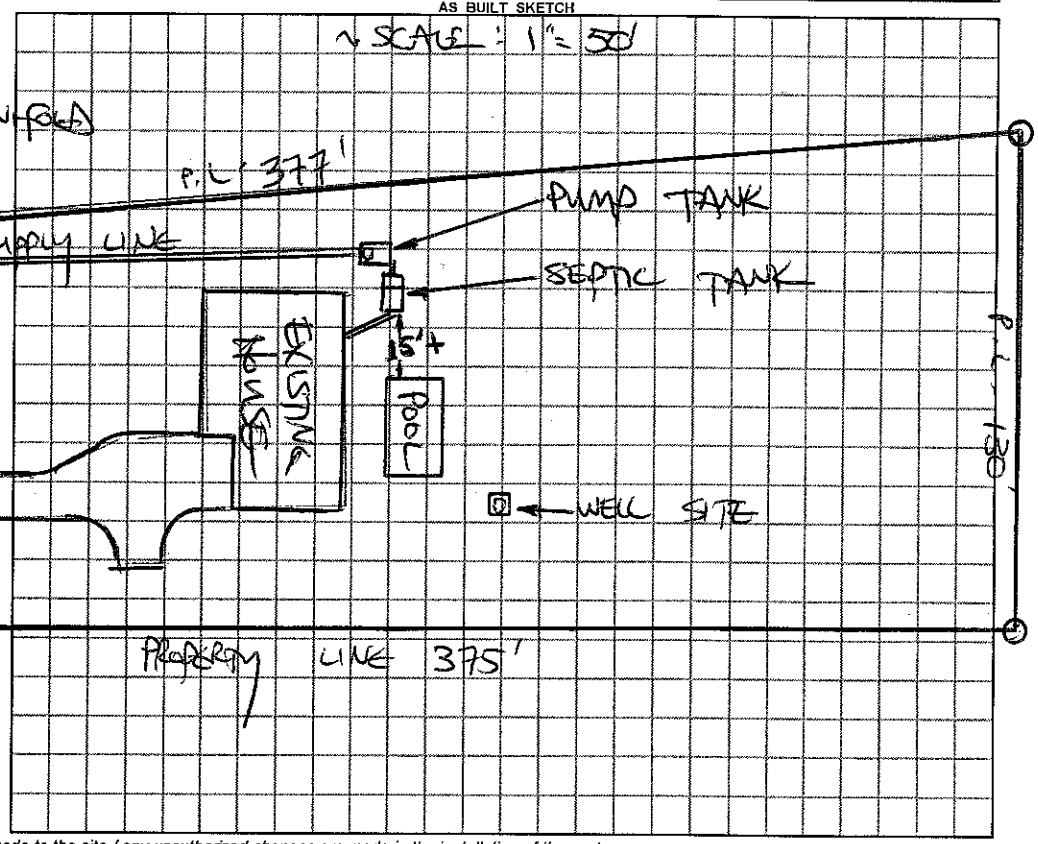

Permit can be suspended or revoked if any false information is supplied toward securing the permit / any unauthorized changes are made to the site / any unauthorized changes are made in the installation of the system.

☐ ***IMPROVEMENT PERMIT*** with plat valid without expiration. ☐ ***IMPROVEMENT PERMIT*** with plat valid without expiration. site plan valid 60 mo. ☐ ***AUTHORIZATION TO CONSTRUCT*** valid for period equal to IMPROVEMENT PERMIT–not to exceed 60 mo.

Owner / Applicant Signature: [signature] Date 7/21/11

IMPROVEMENT PERMIT by: REHS Date

AUTHORIZATION TO CONSTRUCT by: REHS Date

YOU SHOULD CONTACT A LOCATOR SERVICE PRIOR TO ANY EXCAVATION

Installed by:

OPERATION PERMIT by: REHS Date

Existing System Inspected by: R. Strue Hedrick REHS Date 7-19-2011

White Copy – Environmental Health YELLOW COPY (Final) Owner / Applicant PINK COPY (Initial) Owner / Applicant