IREDELL COUNTY HEALTH DEPARTMENT

CT 3 BEDROOM ASPEN LICE 4C PLANS D

STATESVILLE 704-878-5305 MOORESVILLE 704-664-5281

IMPROVEMENT PERMIT / AUTHORIZATION TO CONSTRUCT / OPERATION PERMIT / EXISTING SYSTEM INSPECTION

PERMIT# 100692 PIN# 4741884548 DATE 2-28-05

OWNER OR CONTRACTOR William Brewster Co. PHONE: Business 895-0556 Home

ADDRESS P.O. Box 99 Davidson, NC 28036

LOCATION US 21 South TL Murdock TR Hoover TL Martha's Vineyard TR Painted Bunting TL Scarlet Tanager on left

SUBDIVISION Martha's Vineyard BLOCK / SECTION II LOT 48 LOT AREA .86 Acre SITE CLASS. PS DESIGN FLOW 450 gpd L.T.A.R. .3

Septic Tank: 1000 Gallons; STB 1012 Date 1-22-05

Pump Tank: 1000 Gallons; PT 17 Date 4-17-05

Pump Make: Gouds Model WE0712 Serial No. 505741781

Nitrification Field: No Fields 1 Square Feet 200' Linear Feet 400'

No Lines 5@80' Trench Width 36" Max Trench Bottom Depth 36" Gravel Depth N/A

[X] New System [ ] Repair System Type: I, II, III, IV, V, VI

System Description: Pump-PM-25% Reduction

Repair System Description: Pump-LP-Panel Blk

Maintenance Agreement Required: [ ] Yes [X] No Not Initially

[X] House/Mod. Home [ ] Mobile Home [ ] Business [ ] Other

No. Bedrooms 4 No. Bathrooms 3 No. Employees


[ ] Slab [X] Crawl Space [ ] Basement w/plumbing [ ] Basement wo/plumbing

Water Supply: [X] Individual [ ] Public [ ] Community

Comments/Conditions: Keep Septic System at least 10' From PL, 50' From well & 15' from Cut > 2ft. (Supply line 5ft from PL)


Comments/Conditions: Note: Very tight to get 25% Reduction for Drainfield; must hug PL with driveway. Install Drainlines on Contour.

INITIAL SITE SKETCH Scale 1" = 50'

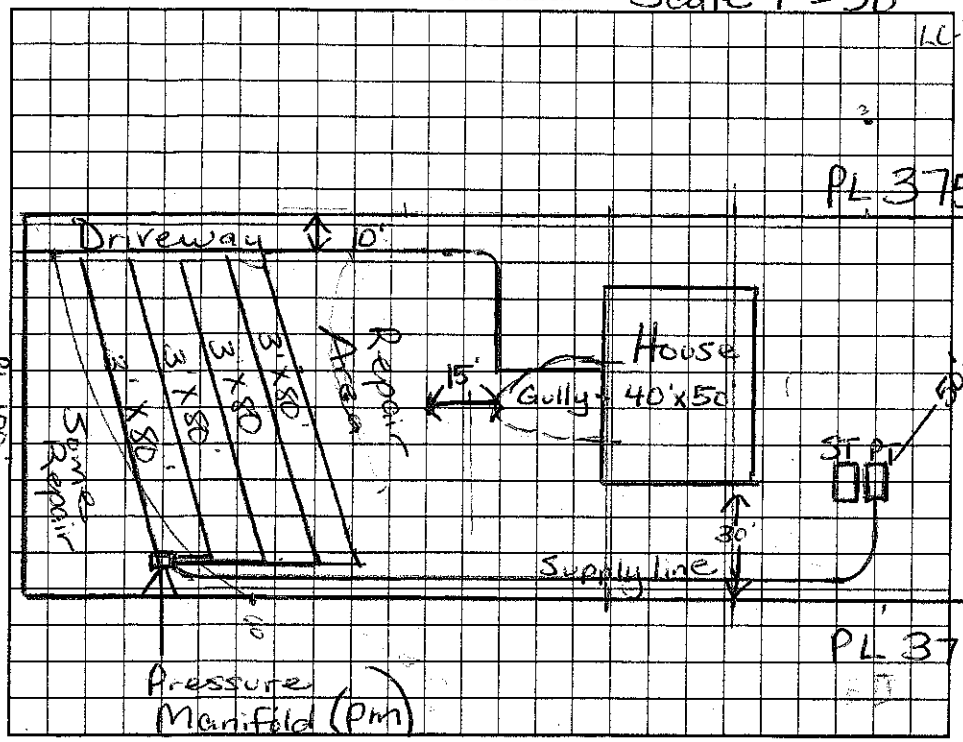

KEEP DRIVEWAY OFF AS BUILT SKETCH OF SYSTEM & REPAIR


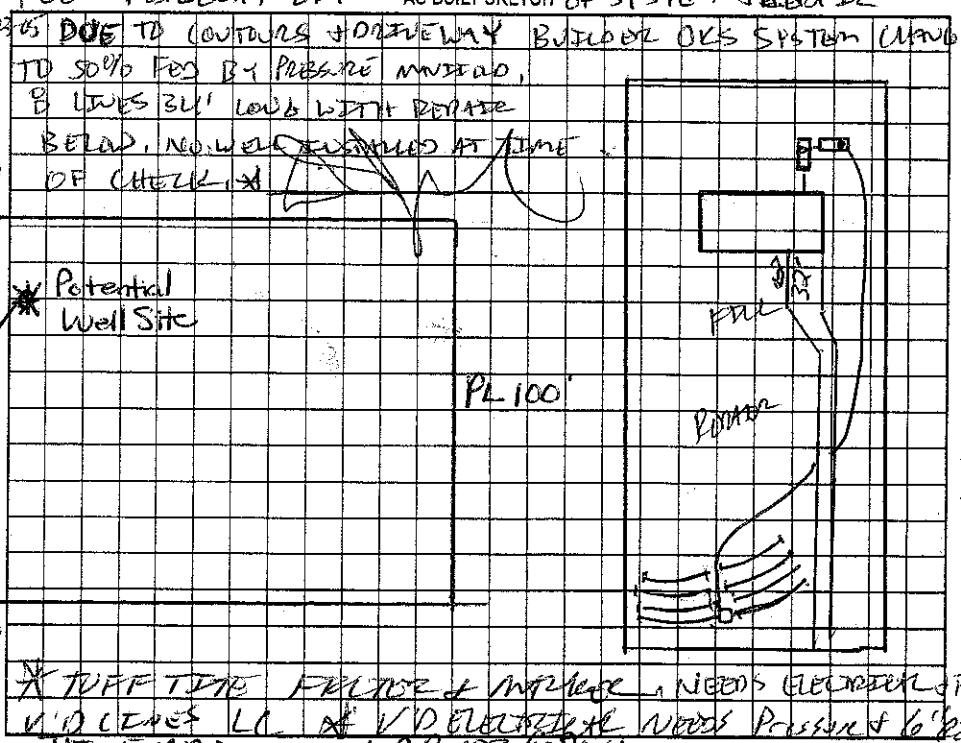

STAFF TIME FAILURE & INSPECTION, NEEDS ELECTRICAL & PUMP; V/D CLOSE LC & V/D ELECTRICAL NEEDS PRESSURE & 6" RISER

JAIME V/D PRESSURE V/D RISER 6-20-06

Permit can be suspended or revoked if any false information is supplied toward securing the permit/any unauthorized changes are made to the site/any unauthorized changes are made in the installation of the system. Improvement Permit with plat valid without expiration. Improvement Permit with site plan valid for sixty months. Authorization to Construct is valid for a period equal to that of Improvement Permit – not to exceed sixty months.

Signed: Angel Blount date 3/1/05 Installed by: AI RAMIREZ

Improvement Permit by: Maria H. Dotson RS date 2/28/05 Operation Permit by: date 6-20-06

Authorization to Construct by: Maria H. Dotson RS date 2/28/05 Existing System Inspection by: date

HEALTH DEPT. COPY: WHITE OWNER COPY (FINAL): YELLOW OWNER COPY (INITIAL): PINK