IREDELL COUNTY HEALTH DEPARTMENT

STATESVILLE 704-878-5305 MOORESVILLE 704-664-5281

IMPROVEMENT PERMIT / AUTHORIZATION TO CONSTRUCT / OPERATION PERMIT / EXISTING SYSTEM INSPECTION

PERMIT# 100694 PIN# ~~4741788145 PT~~ 4741-88-5419 DATE 7/31/01

OWNER OR CONTRACTOR WILLIAM BREWSTER PHONE: Business 895-0556 Home

ADDRESS PO BOX 99 DAVIDSON NC 28036

LOCATION 21 S-TL MURDOCK-TR HOOVER-TL MARTHAS VINEYARD-TR PAVED BUNTING-TL SCARLETT-ON LT

SUBDIVISION MARTHAS VINEYARD BLOCK / SECTION 2 LOT ~~50~~ 49 LOT AREA .86AC SITE CLASS. PS DESIGN FLOW 360GPD L.T.A.R. .36/FT²

Septic Tank: 1000 Gallons; STB 1012 Date 3-4-03

Pump Tank: 1000 Gallons; PT Date 6-26-03

Pump Make: Gould's Model WE0511H Serial No. G036393

Nitrification Field: No Fields 1 Square Feet 900 Linear Feet 300

No Lines 4@75' Trench Width 36" Max Trench Bottom Depth 36" Gravel Depth N/A

☑ New System ☐ Repair System Type: I, II, III, IV, V, VI

System Description: PUMP 25% REDUCTION

Repair System Description: PANEL

Maintenance Agreement Required: ☐ Yes ☑ No

☐ Slab ☑ Crawl Space ☑ Basement w/plumbing ☐ Basement wo/plumbing

☑ House/Mod. Home No. Bedrooms 3

☐ Mobile Home No. Bathrooms 2

☐ Business No. Employees

☐ Other


Water Supply: ☑ Individual ☐ Public ☐ Community

Comments:/Conditions:


DRIVE MUST BE LOCATED AS SHOWN, ADJACENT TO SIDE PROPERTY LINE.

Comments:/Conditions: - TUFF Tite Filter + S.T. marker Installed
- Installed 300 SF of Infiltrators
- Electrical + Alarm Okay, Pressure Check Okay
10/27/03 CWG

INITIAL SITE SKETCH 1"=50'

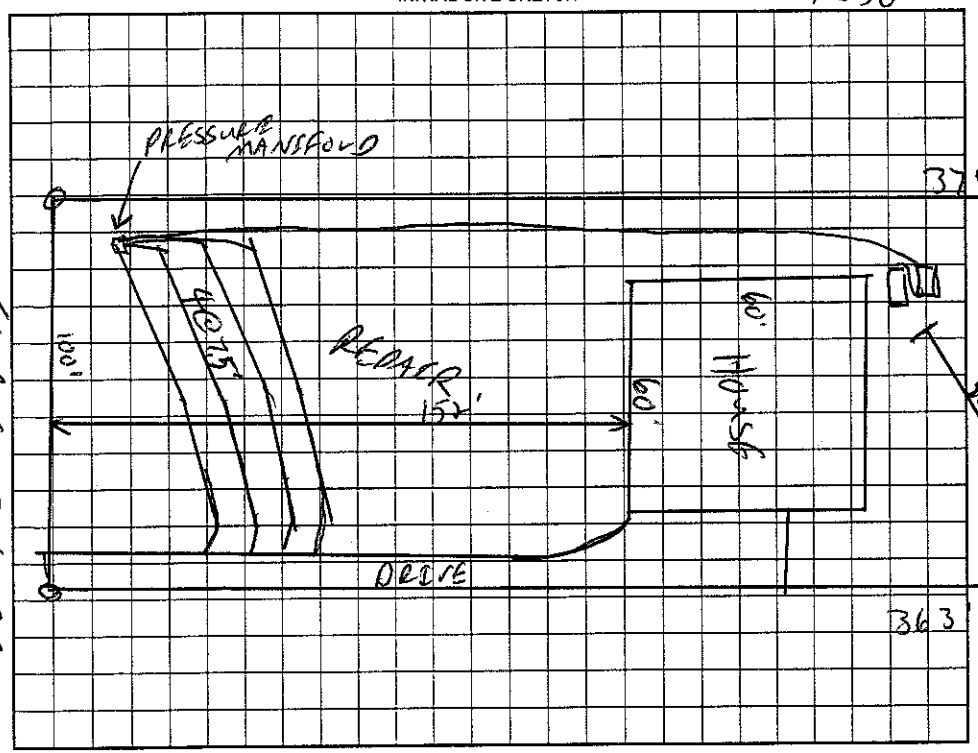

AS BUILT SKETCH

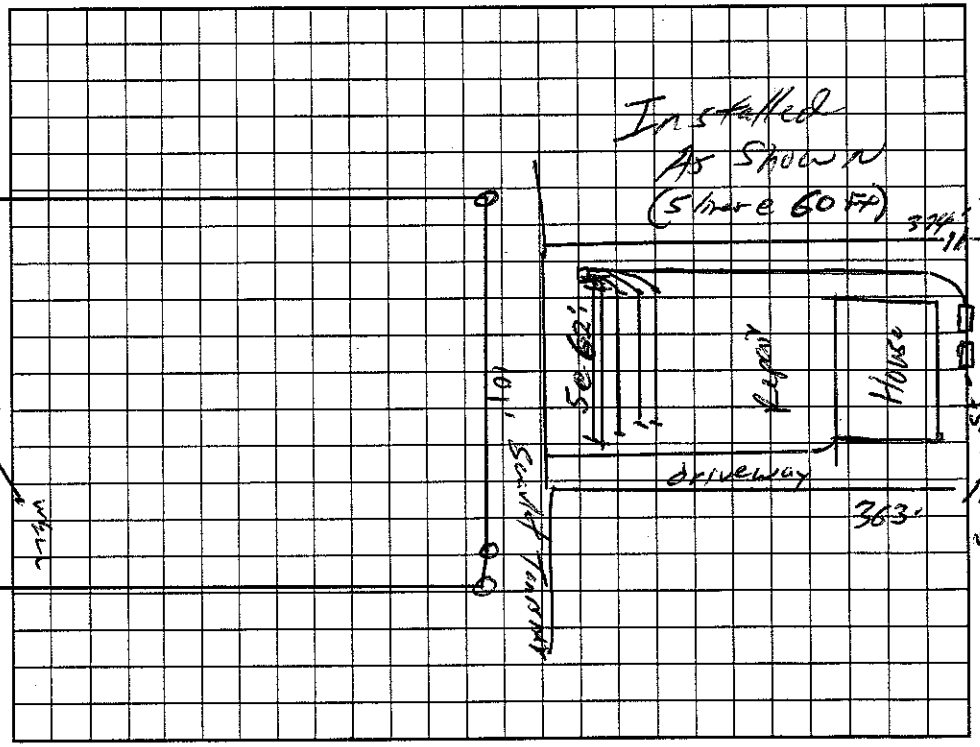

Permit can be suspended or revoked if any false information is supplied toward securing the permit/any unauthorized changes are made to the site/any unauthorized changes are made in the installation of the system. Improvement Permit with plat valid without expiration. Improvement Permit with site plan valid for sixty months. Authorization to Construct is valid for a period equal to that of Improvement Permit – not to exceed sixty months.

Signed: _____ date _____

Improvement Permit by: _____ RS date 7/31/01

Authorization to Construct by: _____ date 06/26/03

Installed by: A-1 Backhoe 10/7/03

Operation Permit by: _____ date 10/27/03

Existing System Inspection by: _____ date _____

HEALTH DEPT. COPY: WHITE OWNER COPY (FINAL): YELLOW OWNER COPY (INITIAL): PINK