IREDELL COUNTY HEALTH DEPARTMENT

L/O

704-426-9782 Todd

STATESVILLE 704-878-5305 MOORESVILLE 704-664-5281

IMPROVEMENT PERMIT / AUTHORIZATION TO CONSTRUCT / OPERATION PERMIT / EXISTING SYSTEM INSPECTION

PERMIT# 100697 PIN# 4741-88-5484 DATE 2-10-06

OWNER OR CONTRACTOR William Burnstein PHONE: Business 704-895-0556 Home

ADDRESS Box 99 Davidson NC 28034

LOCATION 215 E Mudock Rd Hoover - TL Martha's Vineyard RD Painted RD Scarlett on Left

SUBDIVISION Martha's Vineyard BLOCK / SECTION LOT 50 LOT AREA 1.85 SITE CLASS. 2S DESIGN FLOW 480 L.T.A.R. 12

Septic Tank: 1000 Gallons; STB 1012 Date 1-1-06

Pump Tank: 1000 Gallons; PT 17 Date 3-19-07

Pump Make: Zoeller Model WE/1512HH Serial No. WE/1512HH

Nitrification Field: No. Fields ___ Square Feet 1600 Linear Feet 267

No Lines 10.5 Trench Width 36 Max Trench Bottom Depth 36 Gravel Depth NA

☐ New System ☐ Repair System Type: I, II, III, IV, V, VI

System Description: 1 PPanel 300

Repair System Description: 1 PPanel 300

Maintenance Agreement Required: ☐ Yes ☒ No

☒ House/Mod. Home No. Bedrooms 4

☐ Mobile Home No. Bathrooms ___

☐ Business No. Employees ___

☐ Other ___


☐ Slab ☐ Crawl Space ☒ Basement w/plumbing ☐ Basement wo/plumbing

Water Supply: ☒ Individual ☐ Public ☐ Community

Comments/Conditions:

50% Reductions lines 67' each
Located on Contour
Maintain all setbacks


INITIAL SITE SKETCH

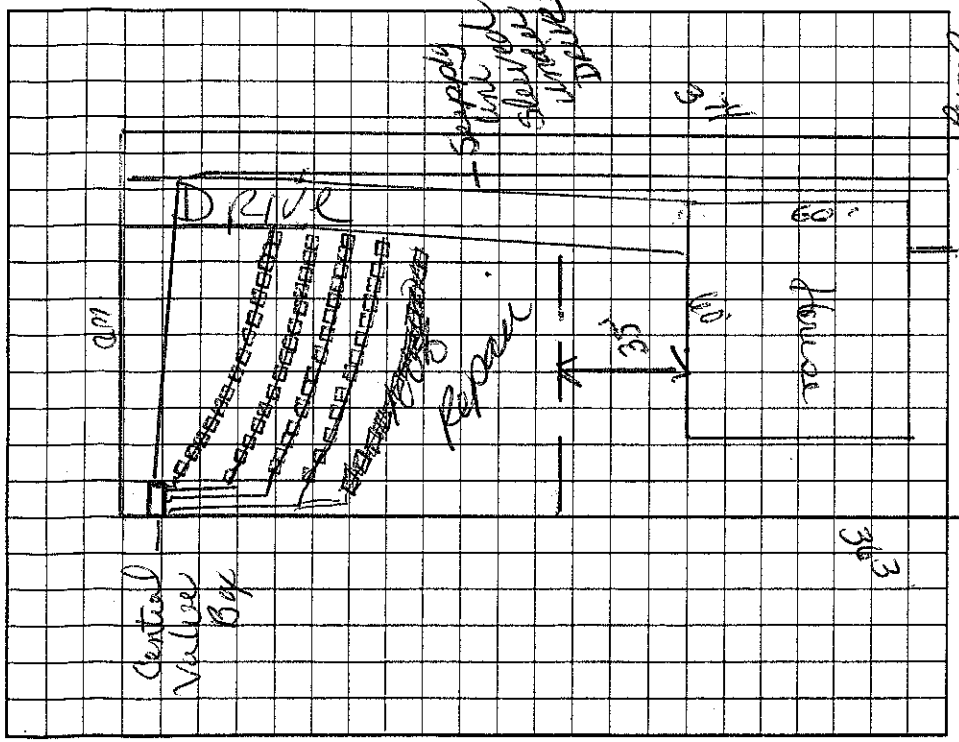

Comments/Conditions:

Supply line sleeved under driveway
Insure that Bonus Room has non-egress windows or permit will be void

AS BUILT SKETCH

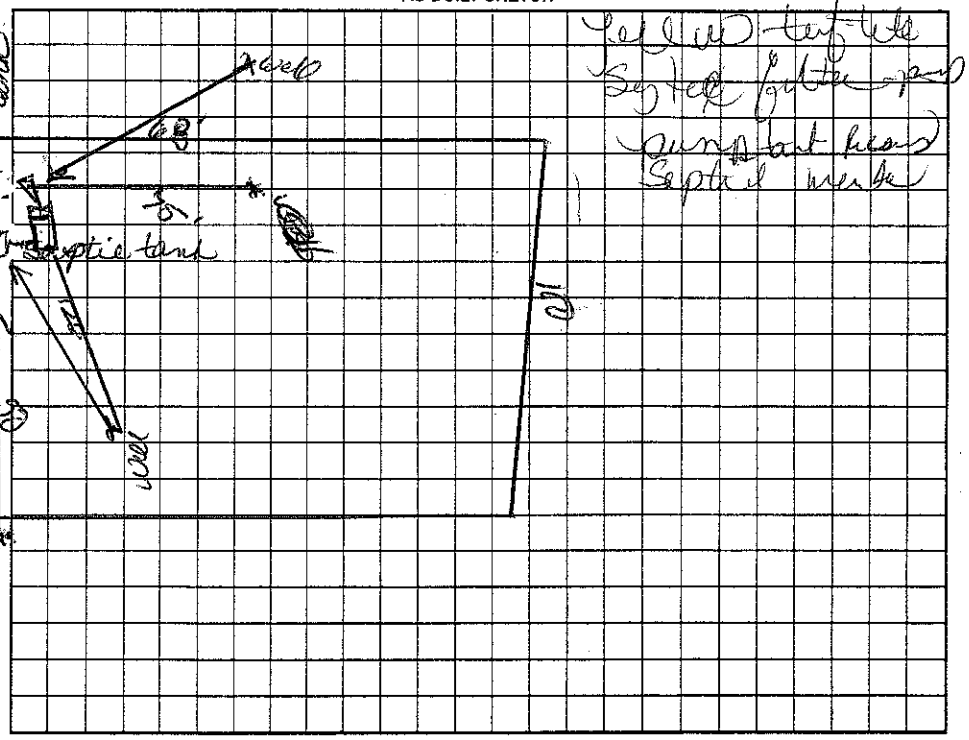

Permit can be suspended or revoked if any false information is supplied toward securing the permit/any unauthorized changes are made to the site/any unauthorized changes are made in the installation of the system. Improvement Permit with plat valid without expiration. Improvement Permit with site plan valid for sixty months. Authorization to Construct is valid for a period equal to that of Improvement Permit – not to exceed sixty months.

Signed: [signature] date 5/5/06 Installed by: A-1 Backhoe

Improvement Permit by: [signature] date 2-10-06 Operation Permit by: [signature] date 10-24-07

Authorization to Construct by: [signature] date 2-10-06 Existing System Inspection by: ___ date ___

HEALTH DEPT. COPY: WHITE OWNER COPY (FINAL): YELLOW OWNER COPY (INITIAL): PINK