IREDELL COUNTY HEALTH DEPARTMENT L/O

704-426-9782 Fred

STATESVILLE 704-878-5305 MOORESVILLE 704-664-5281

IMPROVEMENT PERMIT / AUTHORIZATION TO CONSTRUCT / OPERATION PERMIT / EXISTING SYSTEM INSPECTION

PERMIT# 100697 PIN# 4741-88-5484

OWNER OR CONTRACTOR William Bowsfen DATE 2-10-06

ADDRESS Box 99 Davidson NC 28036 PHONE: Business 704-895-0556 Home

LOCATION 21S to C Murdock (L) Hoover - R Marthas Vineyard (L) Painted (L) Scarlett on left

SUBDIVISION Marthas Vineyard BLOCK / SECTION LOT 50 LOT AREA .83 SITE CLASS. PS DESIGN FLOW 480 L.T.A.R. .12

Septic Tank: 1000 Gallons; STB 1012 Date 11-1-06

Pump Tank: 1000 Gallons; PT 17 Date 3-19-07

Pump Make: Goulds Model WE1512HH Serial No. 1PWE1512HH

Nitrification Field: No Fields Square Feet 1600 Linear Feet 267

No Lines 4 3 Trench Width 36 Max Trench Bottom Depth 36" Gravel Depth NA

☐ New System ☐ Repair System Type: I, II, III, (IV), V, VI

System Description: LP panel 50%

Repair System Description: LP panel 50%

Maintenance Agreement Required: ☐ Yes ☑ No

☑ House/Mod. Home No. Bedrooms 4

☐ Mobile Home No. Bathrooms

☐ Business No. Employees

☐ Other

☐ Slab ☐ Crawl Space ☑ Basement w/plumbing ☐ Basement wo/plumbing

Water Supply: ☑ Individual ☐ Public ☐ Community


Comments:/Conditions:

$50% Reduction lines 67' each
Install on Contour
Maintain all setbacks


Comments/Conditions:

#supply line sleeved under drive
#Ensure that Bonus Room has non-egress windows or permit will be void

INITIAL SITE SKETCH

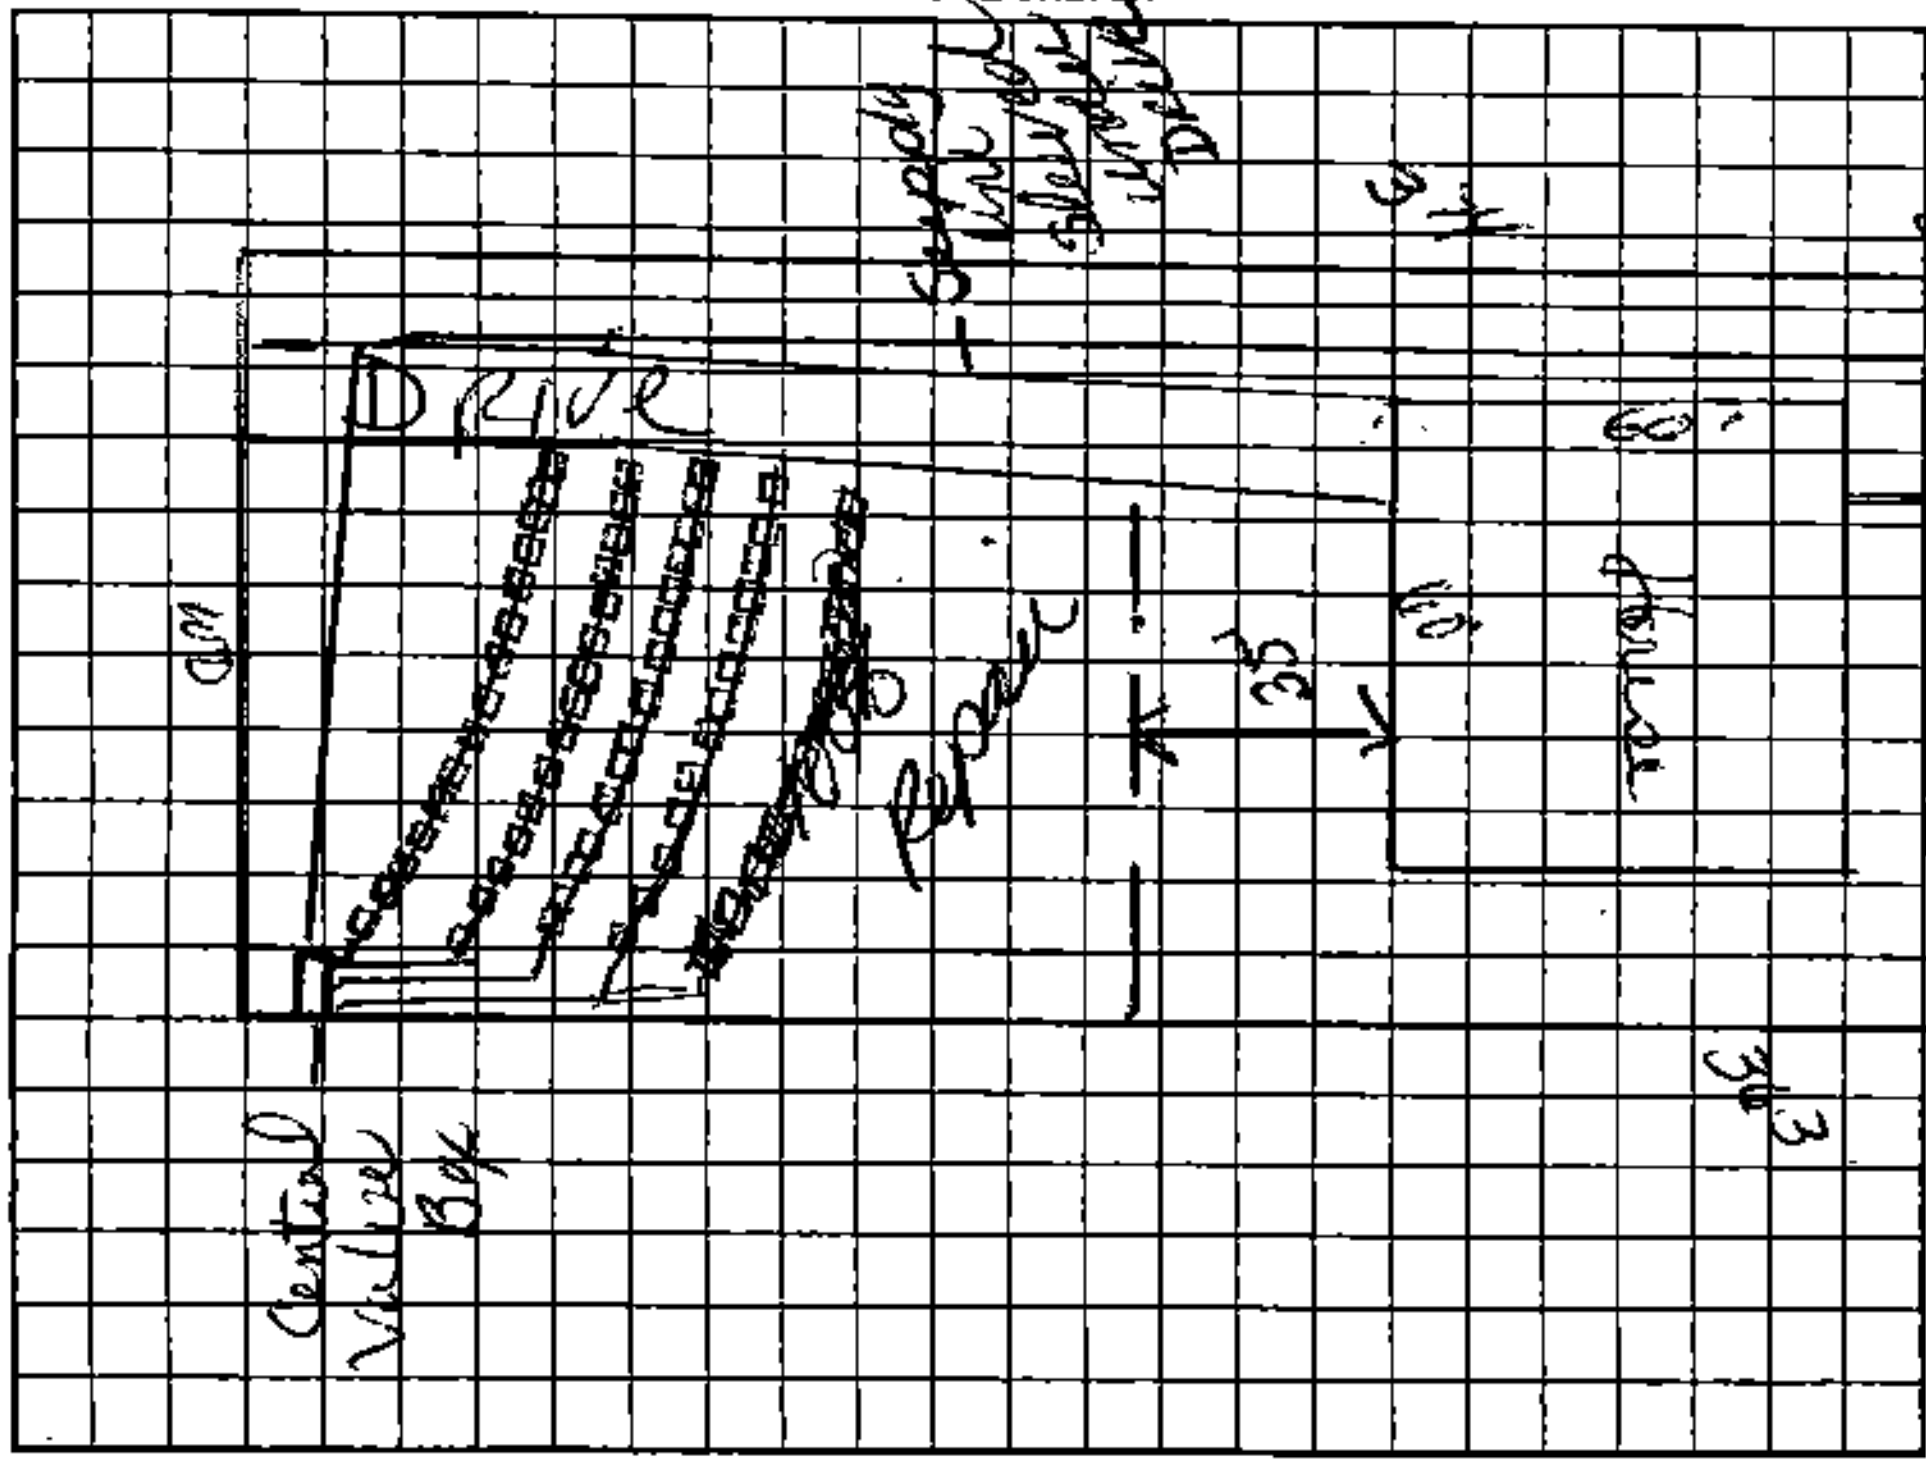

AS BUILT SKETCH

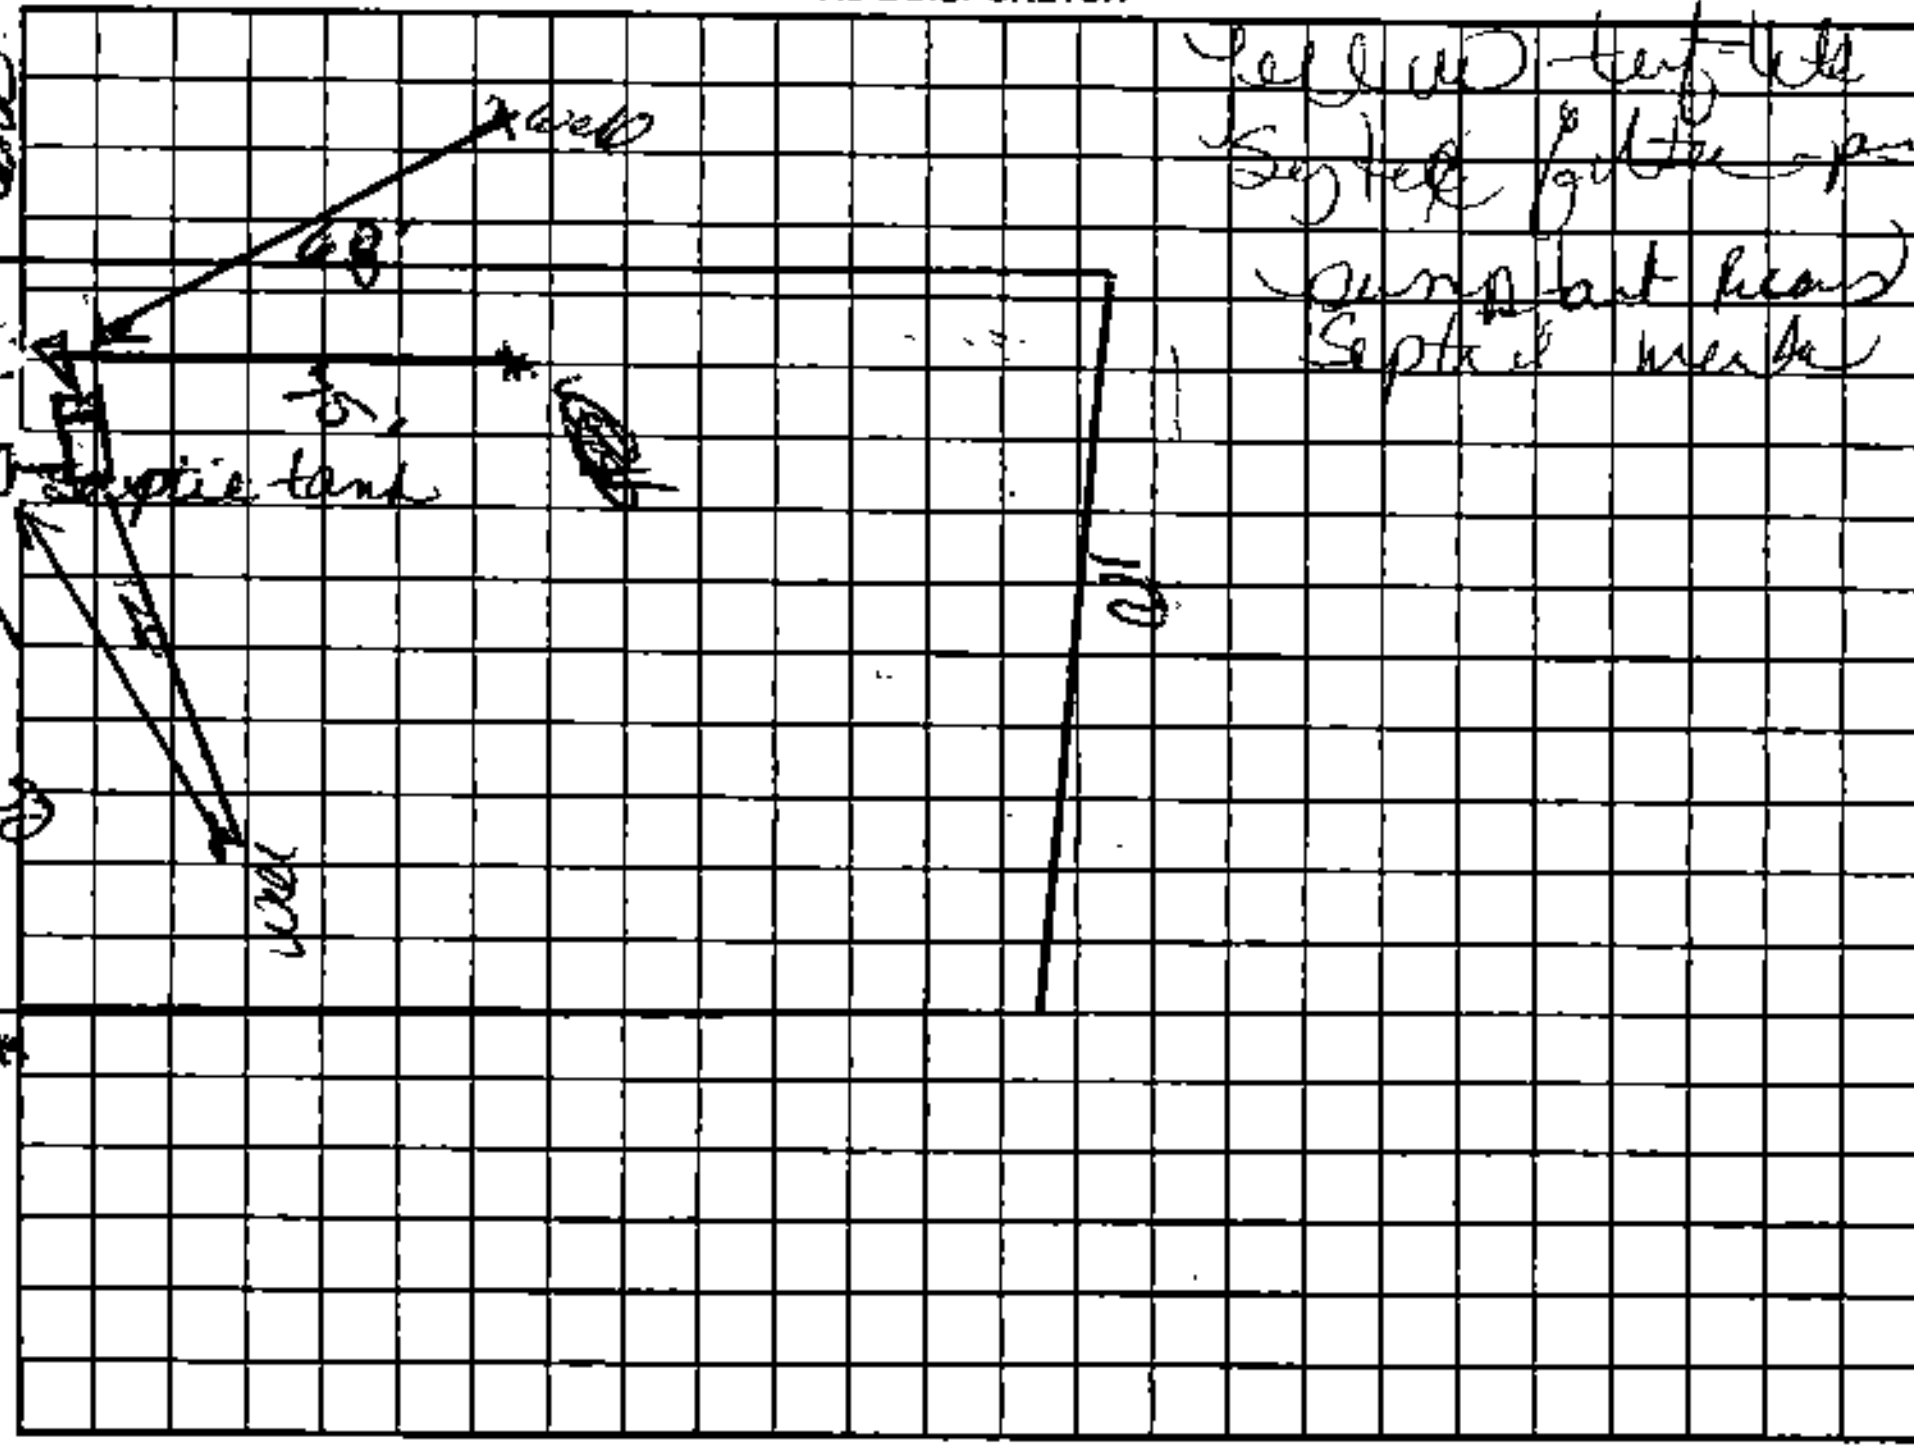

Permit can be suspended or revoked if any false information is supplied toward securing the permit/any unauthorized changes are made to the site/any unauthorized changes are made in the installation of the system. Improvement Permit with plat valid without expiration. Improvement Permit with site plan valid for sixty months. Authorization to Construct is valid for a period equal to that of Improvement Permit – not to exceed sixty months.

Signed: Angie Blount date 5/5/06 Installed by: A-1 Backhoe

Improvement Permit by: [signature] date 2-10-06 Operation Permit by: [signature] date 10-24-07

Authorization to Construct by: [signature] date 2-10-06 Existing System Inspection by: date

HEALTH DEPT. COPY: WHITE OWNER COPY (FINAL): YELLOW OWNER COPY (INITIAL): PINK