* THIS PERMIT REPLACES VOID PERMIT ISSUED 11/07/03. REVOKED

IREDELL COUNTY HEALTH DEPARTMENT

STATESVILLE 704-878-5305 MOORESVILLE 704-664-5281

IMPROVEMENT PERMIT / AUTHORIZATION TO CONSTRUCT / OPERATION PERMIT / EXISTING SYSTEM INSPECTION

PERMIT# 100698 PIN# ~~4744-78-8148~~ 4741-88-6356 DATE 02/21/03

OWNER OR CONTRACTOR WILLIAM BRENSTER PHONE: Business 704-895-0556 ~~Home~~ BILL BONDURANT 704-664-7166

ADDRESS P.O. BOX 99 DAVIDSON, NC 28036

LOCATION 21 SOUTH, (L) MURDOCK RD., (R) HOOVER, (L) MARTHAS VINEYARD, (R) PAINTED BUNTING, (L) SCARLETT, @ END ON LEFT.

SUBDIVISION MARTHAS VINEYARD BLOCK / SECTION 2 LOT 51 LOT AREA 0.804 ACRES SITE CLASS PS DESIGN FLOW 480 GPD L.T.A.R. 0.30 GPD/FT²

Septic Tank: 1,000 Gallons; STB 794 Date 01/12/03
Pump Tank: 1,000 Gallons; PT 27 Date 12/21/02
Pump Make: GOULDS Model ½ HP Serial No. WE0511H
Nitrification Field: No Fields 1 Square Feet EQ to 1,600 Linear Feet 270
No Lines 6 @ 45' Trench Width 24" Max Trench Bottom Depth 36"

[X] New System [ ] Repair System Type: I, II, (III), IV, V, VI
System Description: 50% REDUCTION, PUMP
Repair System Description: 50% REDUCTION, LOW PRESSURE
Maintenance Agreement Required: [ ] Yes [X] No

[X] House/Mod. Home [ ] Mobile Home [ ] Business [ ] Other
No. Bedrooms 4 No. Bathrooms 2½ No. Employees

[ ] Slab [ ] Crawl Space [ ] Basement w/plumbing [ ] Basement wo/plumbing


Water Supply: [X] Individual [ ] Public [ ] Community WELL

Comments/Conditions:

Comments/Conditions: - SEPTIC TANK INSTALLED USING ZABEL FILTER & RISERS.

* SYSTEM INSTALLED DURING PERIOD OF WET SOIL CONDITIONS.

INITIAL SITE SKETCH

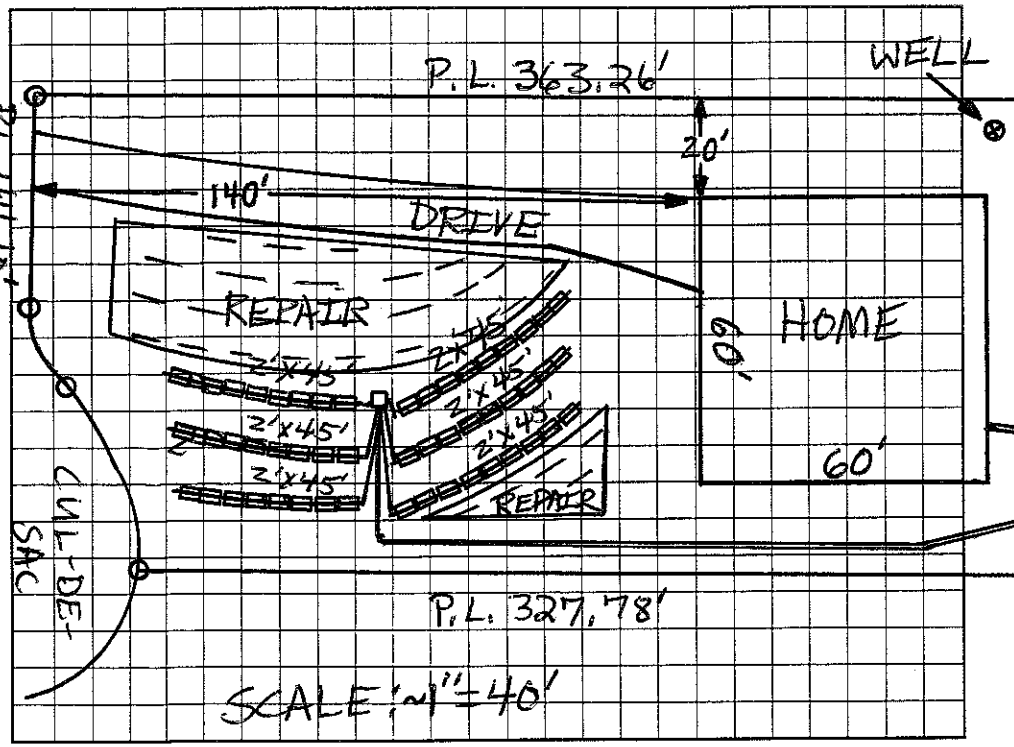

AS BUILT SKETCH

* SYSTEM INSTALLED AS SHOWN IN INITIAL SITE SKETCH.

Permit can be suspended or revoked if any false information is supplied toward securing the permit/any unauthorized changes are made to the site/any unauthorized changes are made in the installation of the system. Improvement Permit with plat valid without expiration. Improvement Permit ~~with site plan~~ valid for sixty months. Authorization to Construct is valid for a period equal to that of Improvement Permit – not to exceed sixty months.

Signed: [signature] date 2/26/03 Installed by: F. J. ERVIN 02/20/03

Improvement Permit by: Patrick Mitchell date 02/24/03 Operation Permit by: Patrick Mitchell date 03/11/03

Authorization to Construct by: Patrick Mitchell date 02/27/03 Existing System Inspection by: _____ date _____

HEALTH DEPT. COPY: WHITE OWNER COPY (FINAL): YELLOW OWNER COPY (INITIAL): PINK