THIS PERMIT VOIDS PREVIOUS ISSUED 3-6-2007

# IREDELL COUNTY HEALTH DEPARTMENT

STATESVILLE 704-878-5305 MOORESVILLE 704-664-5281

## IMPROVEMENT PERMIT / AUTHORIZATION TO CONSTRUCT / OPERATION PERMIT / EXISTING SYSTEM INSPECTION

PERMIT# 141173 PIN# 4741-88-7244 DATE 6-9-2007

OWNER OR APPLICANT WILLIAM BREWSTER CO. INC PHONE: Business 704-895-0556 Home

ADDRESS P.O. BOX 99 DAVIDSON NC 28036

LOCATION HOOVER ROAD @ MARTHA'S VINEYARD, T/R PAINTED BUNTING, TL SCARLET TANAGER TO END ON LEFT

SUBDIVISION MARTHA'S VINEYARD BLOCK / SECTION 2 LOT 52 LOT AREA 1.427 ACRES SITE CLASS. PS DESIGN FLOW 480 L.T.A.R. 0.25 GPD/FT²

Septic Tank: 1000 Gallons; STB 1012 Date 2-14-07

Pump Tank: _____ Gallons; PT _____ Date _____

Pump Make: _____ Model _____ Serial No. _____

Nitrification Field: No Fields 1 Square Feet EQ.1 1920 Linear Feet 480

No Lines FOUR Trench Width 36" Max Trench Bottom Depth 36"

☑ New System ☐ Repair ☐ Expansion System Type: I II III IV V VI

System Description: 25% REDUCTION, GRAVITY

Repair System Description: 50% REDUCTION, LOW PRESSURE

Maintenance Agreement Required: ☐ Yes ☑ No

☑ House/Mod. Home ☐ Mobile Home ☐ Business ☐ Other

No. Bedrooms 4 No. Persons ____ No. Employees ____


Water Supply: ☑ Individual ☐ Public ☐ Community WELL

Gravel Depth N/A ☑ Gravity ☐ Pressure ☐ Slab ☑ Crawl Space ☐ Basement w/plumbing ☐ Basement wo/plumbing


Comments/Conditions: ① INSTALL 25% REDUCTION SYSTEM ON CONTOUR AS FLAGGED ② KEEP SYSTEM MAXIMUM FEASIBLE DISTANCE FROM WELL (75') AS SHOWN

Comments/Conditions: SEPTIC TANK WITH RISERS INSTALLED USING "TUFTITE" FILTER

INITIAL SITE SKETCH

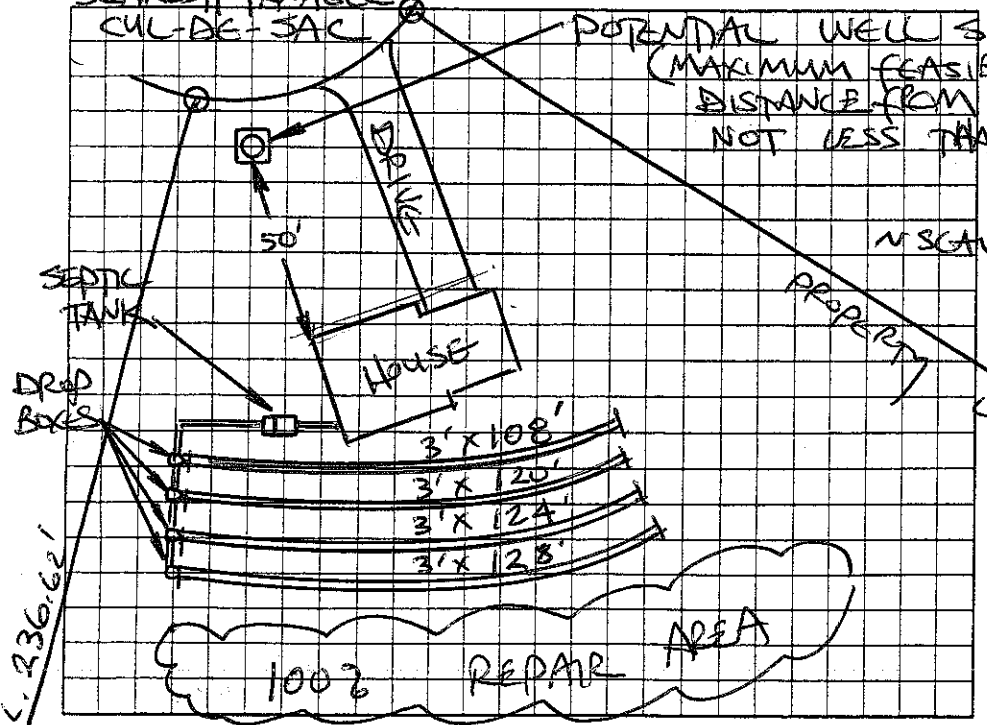


AS BUILT SKETCH

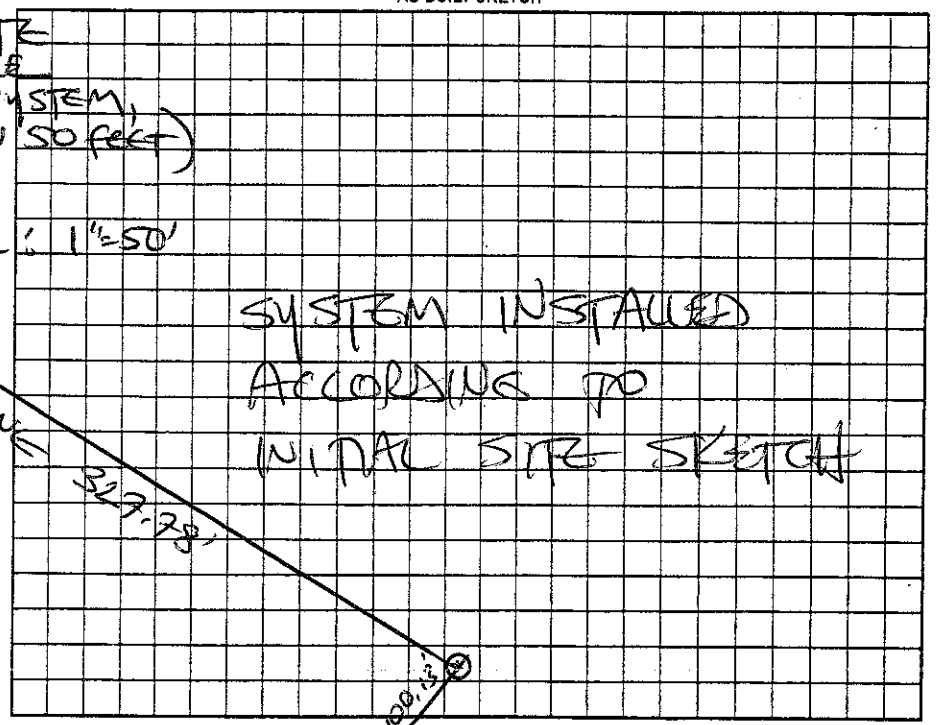


Permit can be suspended or revoked if any false information is supplied toward securing the permit/any unauthorized changes are made to the site/any unauthorized changes are made in the installation of the system. Improvement Permit with plat valid without expiration ☑ Improvement Permit with site plan valid for sixty months ☐ Authorization to Construct is valid for a period equal to that of Improvement Permit – not to exceed sixty months.

Signed: Dennis Galliher date 6-11-07

Improvement Permit by: STEVE HEDRICK date 6-9-07

Authorization to Construct by: STEVE HEDRICK date 6-9-07

Installed by: A-1 BACKHOE

Operation Permit by: STEVE HEDRICK date 6-20-07

Existing System Inspection by: _____ date _____

HEALTH DEPT. COPY: WHITE OWNER COPY (FINAL): YELLOW OWNER COPY (INITIAL): PINK