IREDELL COUNTY HEALTH DEPARTMENT

STATESVILLE 704-878-5305 MOORESVILLE 704-664-5281

IMPROVEMENT PERMIT / AUTHORIZATION TO CONSTRUCT / OPERATION PERMIT / EXISTING SYSTEM INSPECTION

PERMIT# 9218 | PIN# 4741 90 8392 DATE 10-10-00

OWNER OR CONTRACTOR Doris Myers PHONE: Business Home 528 3743

ADDRESS 169 Houston Rd Troutman, N.C.

LOCATION 21S TO Oswalt Amity Cross I-77 1st Drive on Rt.

SUBDIVISION BLOCK / SECTION LOT LOT AREA 7.26 acres SITE CLASS PS DESIGN FLOW 480 L.T.A.R. .32

Septic Tank: 1000 Gallons; STB 744 Date 10/16/00
Pump Tank: Gallons; PT Date
Pump Make: Model Serial No.
Nitrification Field: No Fields 1 Square Feet 1500 Linear Feet 500
No Lines 5 Trench Width 36" Max Trench Bottom Depth 36" Gravel Depth 12"

☑ New System ☐ Repair System Type: I (II) III. IV. V. VI
System Description: Conv. Gravity
Repair System Description: " "
Maintenance Agreement Required: ☐ Yes ☑ No


☐ House/Mod. Home No. Bedrooms 4
☑ Mobile Home No. Bathrooms 2
☐ Business No. Employees
☐ Other
☐ Slab ☑ Crawl Space ☐ Basement w/plumbing ☐ Basement wo/plumbing

Water Supply: ☑ Individual ☐ Public ☐ Community


Comments:/Conditions: Keep Drain lines 9' apart on Center

Comments:/Conditions: Filter Installed

INITIAL SITE SKETCH

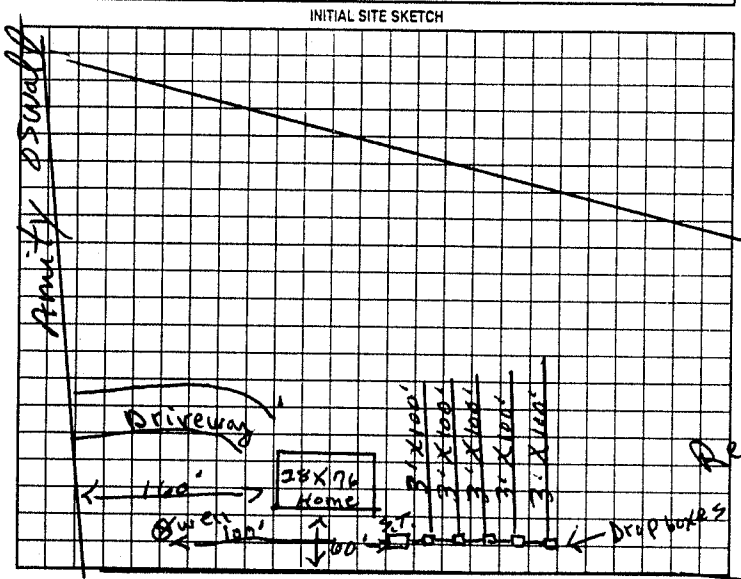

AS BUILT SKETCH

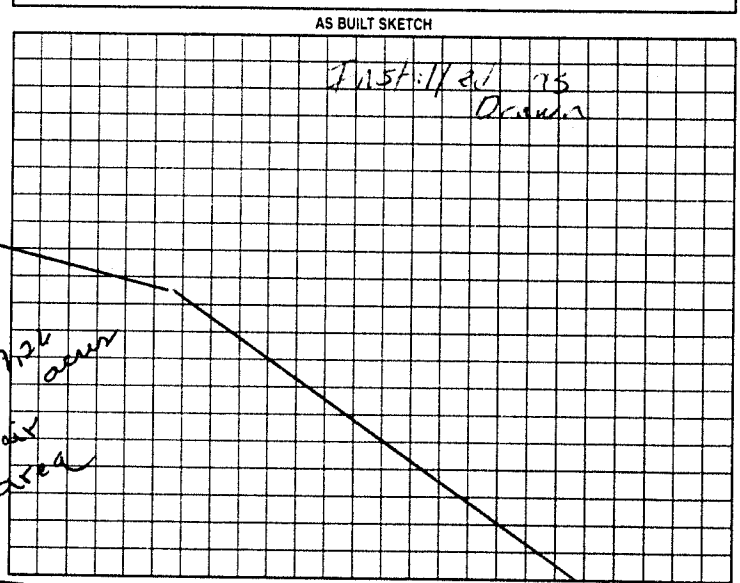

Permit can be suspended or revoked if any false information is supplied toward securing the permit/any unauthorized changes are made to the site/any unauthorized changes are made in the installation of the system. Improvement Permit with plat valid without expiration. Improvement Permit with site plan valid for sixty months. Authorization to Construct is valid for a period equal to that of Improvement Permit – not to exceed sixty months.

Signed: Doris C. Myers I-77 date 10-10-00 Installed by: Tucker Grading

Improvement Permit by: P.C. Moore date 10-10-00 Operation Permit by: [illegible] LST date 12/13/00

Authorization to Construct by: P.C. Moore date 10-10-00 Existing System Inspection by: date

HEALTH DEPT. COPY WHITE OWNER COPY (FINAL) YELLOW OWNER COPY (INITIAL) PINK