IREDELL COUNTY HEALTH DEPARTMENT

STATESVILLE 704-878-5305 MOORESVILLE 704-664-5281

IMPROVEMENT PERMIT / AUTHORIZATION TO CONSTRUCT / OPERATION PERMIT / EXISTING SYSTEM INSPECTION

PERMIT# 100920 PIN# 4741917380 DATE 7/3/01

OWNER OR CONTRACTOR Oakwood Homes / Rachel Sherrill PHONE: Business 704-528-4516 Home

ADDRESS 1642 Charlotte Hwy Troutman NC 28166

LOCATION Oswalt Amity, TL Clarks Oaks, on corner

SUBDIVISION BLOCK / SECTION LOT LOT AREA SITE CLASS. PS DESIGN FLOW 240 L.T.A.R. 0.3

Septic Tank: 1000 Gallons; STB 1012 Date 2-19-02

Pump Tank: Gallons; PT Date

Pump Make: Model Serial No.

Nitrification Field No. Fields Square Feet 800 Linear Feet 267

No Lines 4 ~~10~~ Trench Width 36" Max Trench Bottom Depth 36" Gravel Depth 12"

☒ New System ☐ Repair System Type: I, II, III, IV, V, VI

System Description: Gravity Conventional

Repair System Description: Gravity 25% Red.

Maintenance Agreement Required: ☐ Yes ☒ No

☐ House/Mod. Home ☒ Mobile Home ☐ Business ☐ Other

No. Bedrooms 2 No. Bathrooms 1 No. Employees


☐ Slab ☒ Crawl Space ☐ Basement w/plumbing ☐ Basement wo/plumbing

Water Supply: ☒ Individual ☐ Public ☐ Community

Comments/Conditions:

Comments/Conditions:

INITIAL SITE SKETCH

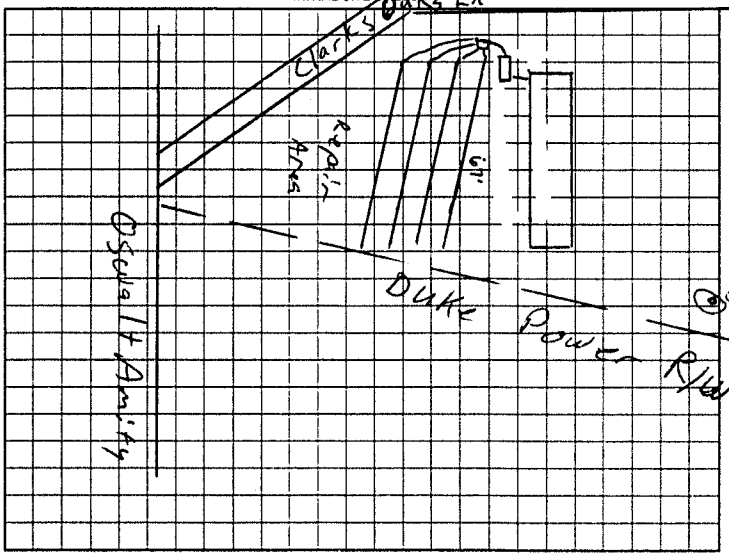

AS BUILT SKETCH

INSTALLED AS SHOWN. WELL NOT INSTALLED AT TIME OF CHECK. BOX WITH SPEED LEVELERS POLY LOK FILTER ARMADOR

Permit can be suspended or revoked if any false information is supplied toward securing the permit/any unauthorized changes are made to the site/any unauthorized changes are made in the installation of the system. Improvement Permit with plat valid without expiration. Improvement Permit with site plan valid for sixty months. Authorization to Construct is valid for a period equal to that of Improvement Permit – not to exceed sixty months.

Signed: WM Cyburn date 9/25/2001 Installed by: A-1 Backhoe

Improvement Permit by: [signature] RSE date 7/3/01 Operation Permit by: [signature] RS date 06-25-02

Authorization to Construct by: [signature] RSE date 7/3/01 Existing System Inspection by: date

HEALTH DEPT. COPY: WHITE OWNER COPY (FINAL): YELLOW OWNER COPY (INITIAL): PINK