IREDELL COUNTY HEALTH DEPARTMENT

STATESVILLE 704-878-5305 MOORESVILLE 704-664-5281

IMPROVEMENT PERMIT / CERTIFICATE OF COMPLETION / OPERATION PERMIT / EXISTING SYSTEM INSPECTION

PROPERTY DESCRIPTION NO. D68910 DATE 8-18-97 TAX MAP NO. 4741929175 Watershed: ☐ Yes ☐ No

OWNER OR CONTRACTOR Timothy Barnett PHONE: Business _____ Home 528-9911

ADDRESS 141 Emmanuel Rd Statesville Troutman

LOCATION ~~Old~~ 215 TL Ostwalt Rd to TL Emmanuel lot on left

SUBDIVISION _____ BLOCK / SECTION _____ LOT _____ LOT AREA 1.84ac SITE CLASS. _____ DESIGN FLOW 360 L.T.A.R. 0.3

Septic Tank: 1000 Gallons; STB _____ Date _____

Pump Tank: _____ Gallons; PT _____ Date _____

Pump Make: _____ Model _____ Serial No. _____

Nitrification Field: No Fields 1 Square Feet _____ Linear Feet 150

No Lines 1 Trench Width 36in Max Trench Bottom Depth 36in Gravel Depth 12in

☒ New System ☐ Repair System Type: I, II, III, IV, V, VI

System Description: Gravity Conventional

Repair System Description: _____

Maintenance Agreement Required: ☐ Yes ☒ No

☐ House/Mod. Home No. Bedrooms 3

☒ Mobile Home No. Bathrooms 2

☐ Business No. Employees _____

☐ Other _____


☐ Slab ☒ Crawl Space ☐ Basement w/plumbing ☐ Basement wo/plumbing

Water Supply: ☒ Individual ☐ Community ☐ Public


Comments: Check tank and sanitary T replace if needed,

Comments:

INITIAL SITE SKETCH

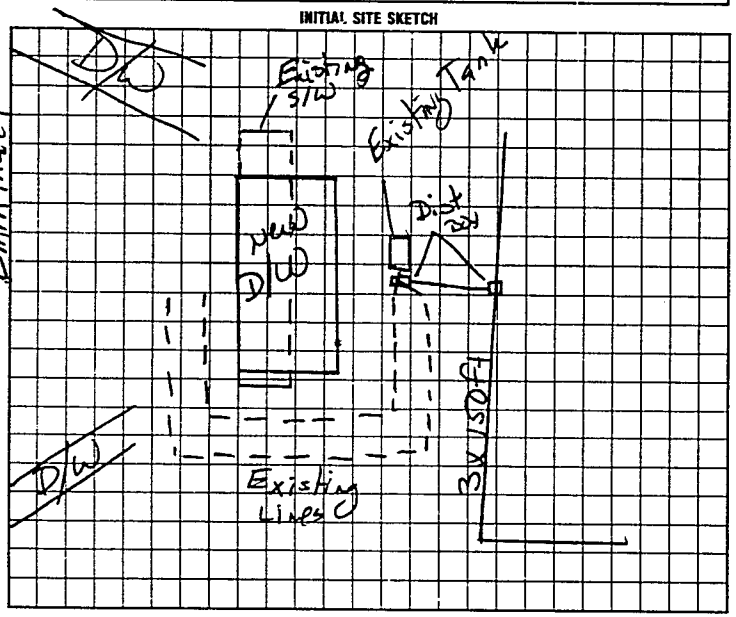

AS BUILT SKETCH

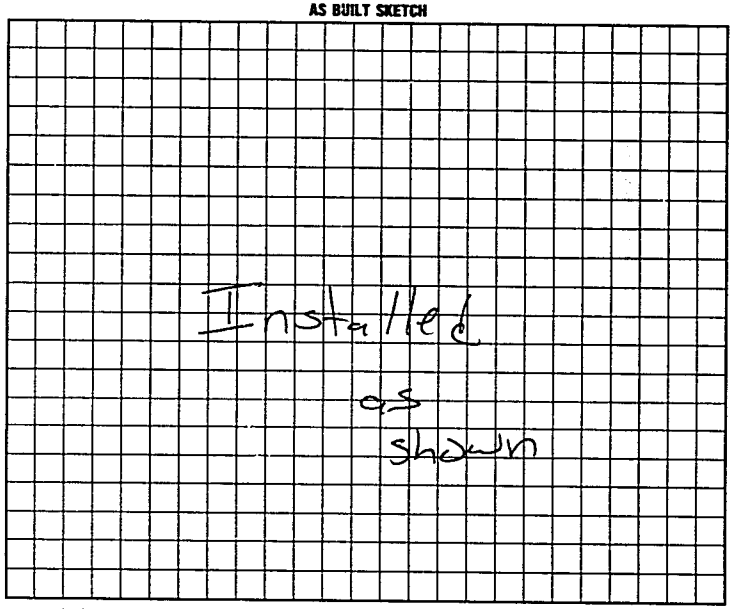

I understand that this permit can be suspended or revoked if any false information is supplied toward securing the permit/any unauthorized changes are made to the site/any unauthorized changes are made in the installation of the system. Improvement Permit is valid for 60 months from date of issuance.

Signed: Timothy Wayne Barnett

Improvement Permit by: Mary C Ostwalt RS date 8-18-97

~~Existing System Inspection by~~: Mary C Ostwalt RS date 8-18-97

Installed by: Timothy Barnett

Certificate of Completion by: _____ date _____

Operation Permit by: Mary C Ostwalt RS date 9-9-97

HEALTH DEPT COPY WHITE INSPECTION COPY (FINAL) GREEN OWNER COPY (FINAL) YELLOW INSPECTION COPY (INITIAL) PINK OWNER COPY (INITIAL) GOLD

0 0 3 0 5 2