IREDELL COUNTY HEALTH DEPARTMENT

STATESVILLE 704-878-5305 MOORESVILLE 704-664-5281

IMPROVEMENT PERMIT / AUTHORIZATION TO CONSTRUCT / OPERATION PERMIT / EXISTING SYSTEM INSPECTION

PERMIT# 89686 PIN# 4741966146 DATE June 14 2000

OWNER OR CONTRACTOR James W. VANhoy PHONE: Business _____ Home 528 9277

ADDRESS 255 Pear Tree Rd Troutman

LOCATION Pilch Rd To Pear Tree Tr. end on left Inside # 255

SUBDIVISION VANhoy Est BLOCK / SECTION _____ LOT 1 LOT AREA 1.77 SITE CLASS PS DESIGN FLOW 360 L.T.A.R. .35

Septic Tank: 1000 Gallons; STB 1012 Date 8/3/00
Pump Tank: _____ Gallons; PT _____ Date _____
Pump Make: _____ Model _____ Serial No. _____
Nitrification Field: No Fields 1 Square Feet 1088 Linear Feet 345
No Lines 3 Trench Width 36" Max Trench Bottom Depth 36-40 Gravel Depth 12"

☒ New System ☐ Repair System Type I II III IV V VI
System Description: Conv. GRAVITY
Repair System Description: SAME Pump Possible
Maintenance Agreement Required: ☐ Yes ☒ No

☒ House/Mod. Home No. Bedrooms 3
☐ Mobile Home No. Bathrooms 2½
☐ Business No. Employees ____
☐ Other _____


☐ Slab ☐ Crawl Space ☒ Basement w/plumbing ☐ Basement wo/plumbing

Water Supply: ☒ Individual ☐ Public ☐ Community WELL


Comments/Conditions: INSTALL on contour Landscape To Provide DRAINAGE May Use ~~DryBox~~ Distribution Box w/Spreader Valve Basement plumbing Will use grinder/lift pump Not To Scale

Comments/Conditions: Filter installed

PERMIT SITE SKETCH

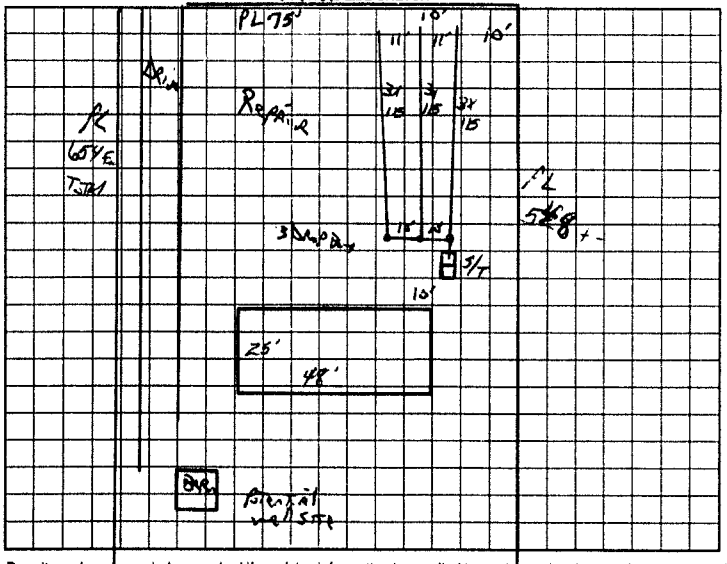

AS BUILT SKETCH

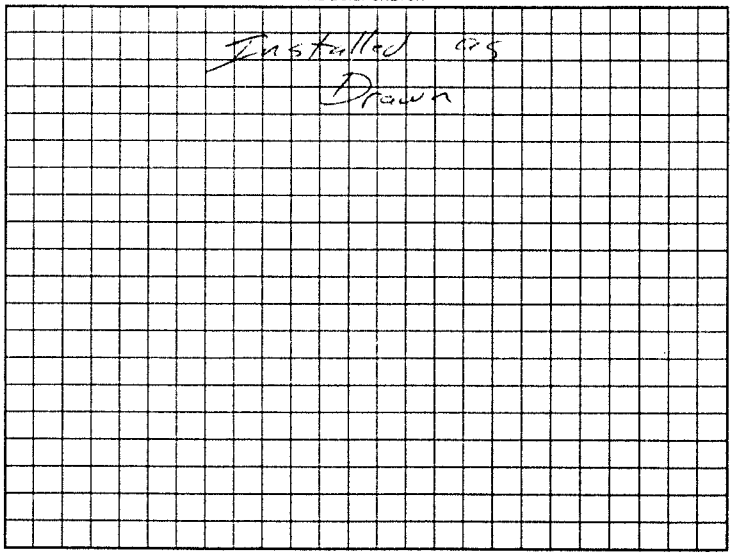

Permit can be suspended or revoked if any false information is supplied toward securing the permit/any unauthorized changes are made to the site/any unauthorized changes are made in the installation of the system. Improvement Permit with plat valid without expiration. Improvement Permit with site plan valid for sixty months. Authorization to Construct is valid for a period equal to that of Improvement Permit – not to exceed sixty months.

Signed: James W. VANhoy date 6-14-2000 Installed by: Dale Wingler

Improvement Permit by: J.C. Potter date June 14 2000 Operation Permit by: [signature] RSI date 11/3/01

Authorization to Construct by: J.C. Potter date June 14 2000 Existing System Inspection by: _____ date _____

HEALTH DEPT. COPY: WHITE OWNER COPY (FINAL): YELLOW OWNER COPY (INITIAL): PINK