IREDELL COUNTY HEALTH DEPARTMENT

STATESVILLE 704-878-5305 (2) MOORESVILLE 704-664-5281

(2) IMPROVEMENT PERMIT / AUTHORIZATION TO CONSTRUCT / OPERATION PERMIT / EXISTING SYSTEM INSPECTION

PERMIT# 132293 PIN# 4741-96-8203 DATE 11-22-05

OWNER OR CONTRACTOR JAMES WAYNE VAN HOY PHONE: Business _____ Home 704-929-8476

ADDRESS 251 PEAR TREE ROAD, TROUTMAN, NC 28166

LOCATION I-77 S, TL AMITY HILL RD, TR PILCH ROAD, CONTINUE PEAR TREE TO END ON LEFT

SUBDIVISION VANHOY ESTATES BLOCK / SECTION _____ LOT 3 LOT AREA 1.489 ACRES SITE CLASS. PS DESIGN FLOW 360 L.T.A.R. 0.25 GPD/FT²

Septic Tank: EXISTING Gallons; STB _____ Date _____

Pump Tank: _____ Gallons; PT _____ Date _____

Pump Make: _____ Model _____ Serial No. _____

Nitrification Field: No Fields 1 Square Feet 480 Linear Feet 160

No Lines TWO Trench Width 36" Max Trench Bottom Depth 36" Gravel Depth 12"

☑ New System ☐ Repair System Type: I, (II), III, IV, V, VI

System Description: CONVENTIONAL GRAVITY

Repair System Description: CONV. GRAVITY

Maintenance Agreement Required: ☐ Yes ☑ No

☑ House/Mod. Home No. Bedrooms 3

☐ Mobile Home No. Bathrooms ____

☐ Business No. Employees ____

☐ Other _____

☐ Slab ☐ Crawl Space ☑ Basement w/plumbing ☐ Basement wo/plumbing

Water Supply: ☑ Individual ☐ Public ☐ Community

Comments:/Conditions:


(1) EXPAND EXISTING SYSTEM AS SHOWN

(2) INSTALL TWO NEW DROP BOXES FEEDING TWO NEW 3' x 80' LINES.


(3) EXISTING BUILDING TO BE DISCONNECTED.

Comments:/Conditions:

INITIAL SITE SKETCH

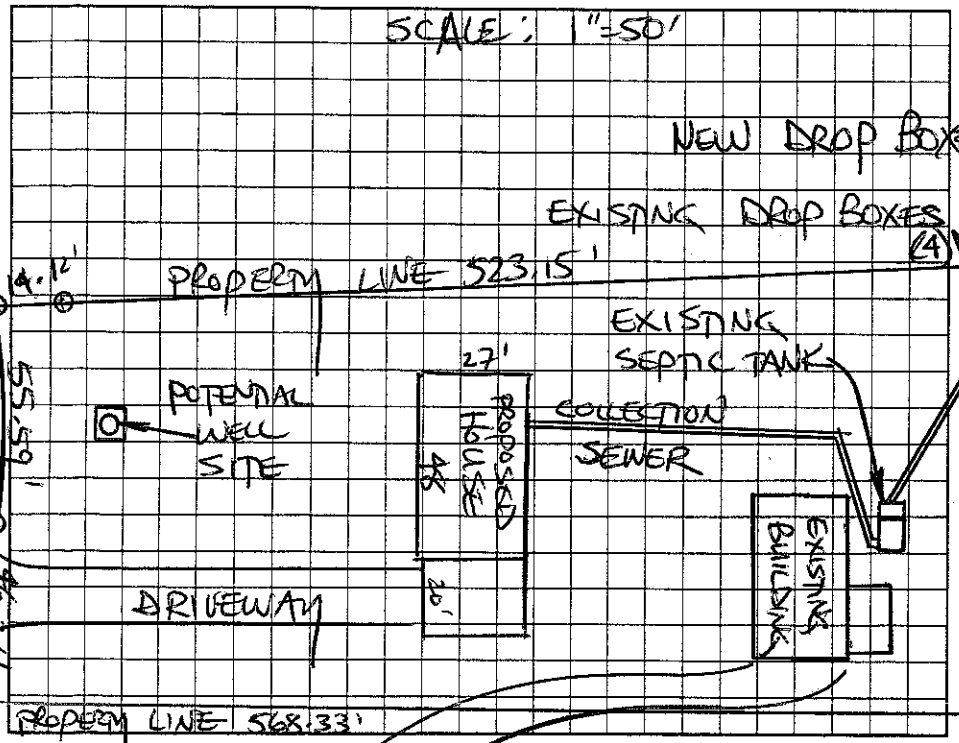

AS BUILT SKETCH

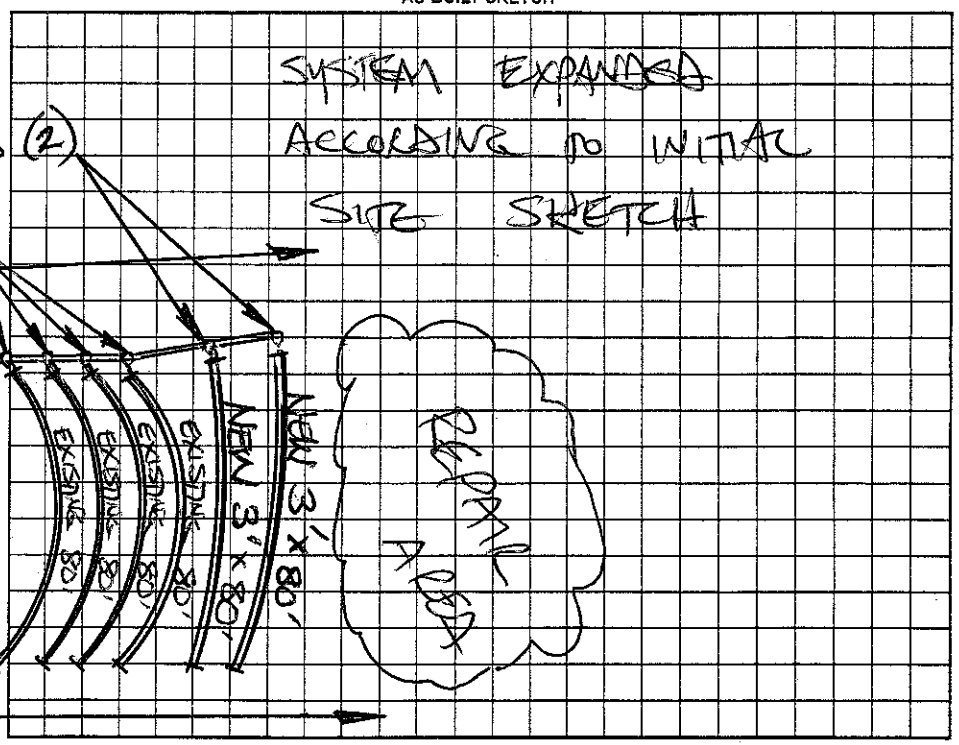

Permit can be suspended or revoked if any false information is supplied toward securing the permit/any unauthorized changes are made to the site/any unauthorized changes are made in the installation of the system. Improvement Permit with plat valid without expiration. Improvement Permit with site plan valid for sixty months. Authorization to Construct is valid for a period equal to that of Improvement Permit – not to exceed sixty months.

Signed: James Van Hoy date 11-22-05 Installed by: K & K GRADING

Improvement Permit by: STEVE HEDRICK date 11-22-05 Operation Permit by: STEVE HEDRICK date 10-6-06

Authorization to Construct by: STEVE HEDRICK date 11-22-05 Existing System Inspection by: _____ date _____

HEALTH DEPT. COPY: WHITE OWNER COPY (FINAL): YELLOW OWNER COPY (INITIAL): PINK