IREDELL COUNTY HEALTH DEPARTMENT

STATESVILLE 704-878-5305 MOORESVILLE 704-664-5281

IMPROVEMENT PERMIT / AUTHORIZATION TO CONSTRUCT / OPERATION PERMIT / EXISTING SYSTEM INSPECTION

PERMIT# 103808 PIN# 4741-96-8203 DATE 1-16-02

OWNER OR CONTRACTOR JAMES W. VANHOY PHONE: Business (704) 657-5603 Home (704) 528-9277

ADDRESS 153 PEAR TREE ROAD, TROUTMAN, NC 28166

LOCATION AMITY HILL ROAD, TR PILCH ROAD, TR PEAR TREE ROAD, NEAR END AT BOX #155 ON LEFT

SUBDIVISION VAN HOY EST. BLOCK / SECTION ____ LOT 3 LOT AREA 1.533 ACRES SITE CLASS. PS DESIGN FLOW 240 L.T.A.R. 0.25 GPD/FT²

Septic Tank: 1000 Gallons; STB 1012 Date 06/27/02
Pump Tank: ____ Gallons; PT ____ Date ____
Pump Make: ____ Model ____ Serial No. ____
Nitrification Field: No Fields 1 Square Feet 960 Linear Feet 320
No Lines FOUR Trench Width 36" Max Trench Bottom Depth 36" Gravel Depth 12"

☑ New System ☐ Repair System Type: I, (II), III, IV, V, VI
System Description: CONVENTIONAL GRAVITY
Repair System Description: CONVENTIONAL GRAVITY
Maintenance Agreement Required: ☐ Yes ☑ No
☑ Slab ☐ Crawl Space ☐ Basement w/plumbing ☐ Basement wo/plumbing


☑ House/Mod. Home No. Bedrooms 2
☐ Mobile Home No. Bathrooms 1
☐ Business No. Employees ____
☐ Other (FUTURE 2BR)

Water Supply:
☑ Individual
☐ Public
☐ Community
WELL


Comments:/Conditions: KEEP SYSTEM MINIMUM 100 FEET FROM WELL

Comments:/Conditions: - SEPTIC TANK INSTALLED USING MARKER & TUFFTIGHT FILTER

INITIAL SITE SKETCH

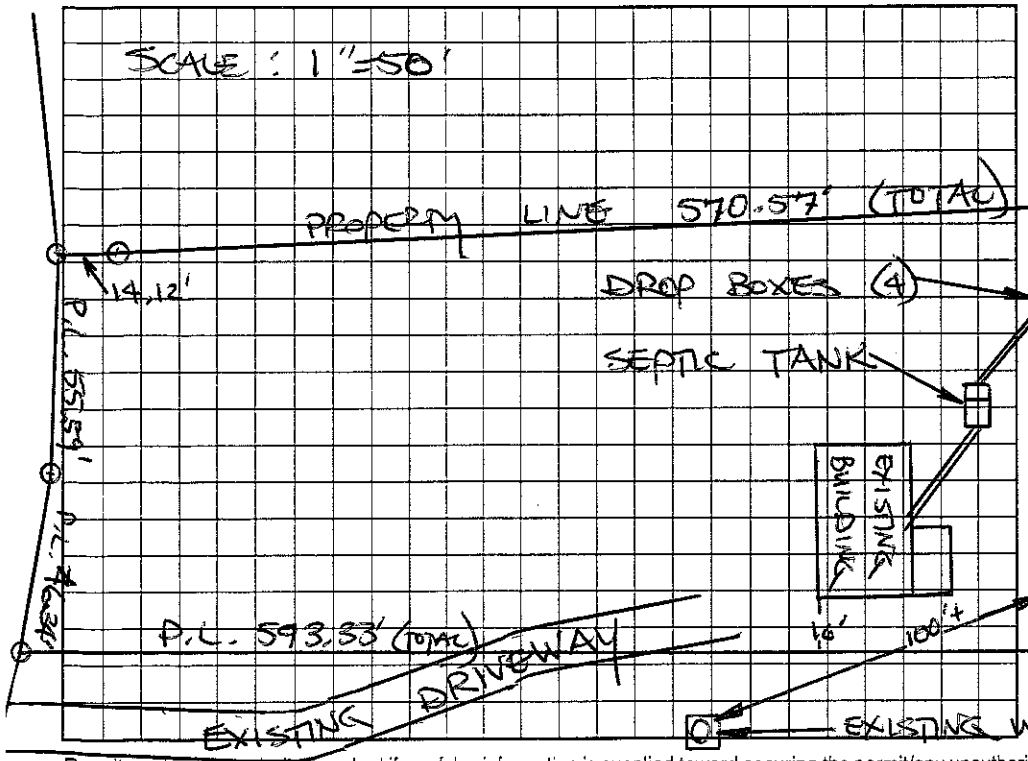

AS BUILT SKETCH

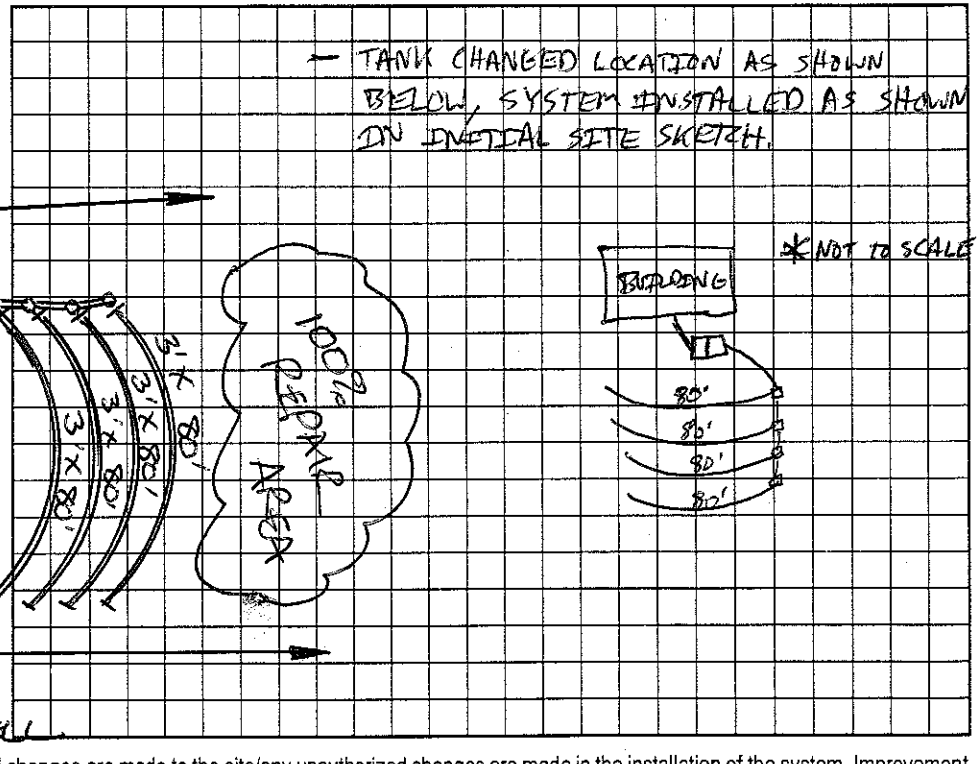

Permit can be suspended or revoked if any false information is supplied toward securing the permit/any unauthorized changes are made to the site/any unauthorized changes are made in the installation of the system. Improvement Permit with plat valid without expiration. Improvement Permit with site plan valid for sixty months. Authorization to Construct is valid for a period equal to that of Improvement Permit – not to exceed sixty months.

Signed: James W. Vanhoy date 1-16-02 Installed by: MARK WINGLER

Improvement Permit by: STEVE HEDRICK date 1-16-02 Operation Permit by: Patrick Mitchell date 09/12/02

Authorization to Construct by: STEVE HEDRICK date 1-16-02 Existing System Inspection by: ____ date ____

HEALTH DEPT. COPY: WHITE OWNER COPY (FINAL): YELLOW OWNER COPY (INITIAL): PINK