IREDELL COUNTY HEALTH DEPARTMENT

STATESVILLE 704-878-5305 MOORESVILLE 704-664-5281

IMPROVEMENT PERMIT / AUTHORIZATION TO CONSTRUCT / OPERATION PERMIT / EXISTING SYSTEM INSPECTION

PERMIT# 83976 PIN# 4741975035 DATE 5/15/00

OWNER OR CONTRACTOR ROBERT BARKLEY PHONE: Business _____ Home _____

ADDRESS 612 RIVER HWY - MOORESVILLE

LOCATION OSWALT AMITY - TL PILCH - TL PEARTREE - .5 MILE ON RT

SUBDIVISION _____ BLOCK / SECTION _____ LOT 1 LOT AREA PT of 3 AC SITE CLASS PS DESIGN FLOW 360 gpd L.T.A.R. .3 gpd/sq ft

Septic Tank: 1000 Gallons; STB 744 Date 7/10/00
Pump Tank: _____ Gallons; PT _____ Date _____
Pump Make: _____ Model _____ Serial No. _____
Nitrification Field: No Fields 1 Square Feet 1200 Linear Feet 400
No Lines 4@100' Trench Width 36" Max Trench Bottom Depth 36" Gravel Depth 12"

☑ New System ☐ Repair System Type: I (II) III, IV, V, VI
System Description: GRAVITY CONVENTIONAL
Repair System Description: SAME
Maintenance Agreement Required: ☐ Yes ☑ No


☑ House/Mod. Home No. Bedrooms 3
☐ Mobile Home No. Bathrooms 2
☐ Business No. Employees ____
☐ Other _____
☐ Slab ☑ Crawl Space ☐ Basement w/plumbing ☐ Basement wo/plumbing

Water Supply: ☑ Individual ☐ Public ☐ Community

Comments:/Conditions:

Comments:/Conditions:

INITIAL SITE SKETCH 1" = 50'

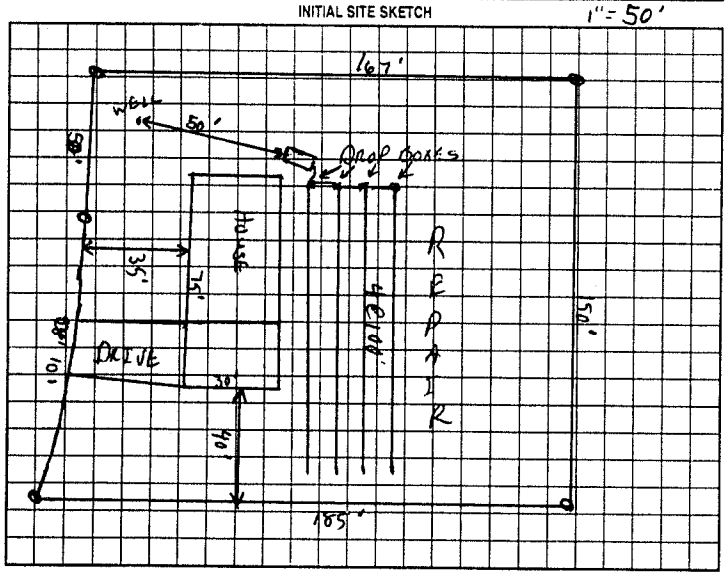

AS BUILT SKETCH

Permit can be suspended or revoked if any false information is supplied toward securing the permit/any unauthorized changes are made to the site/any unauthorized changes are made in the installation of the system. Improvement Permit with plat valid without expiration. Improvement Permit with site plan valid for sixty months. Authorization to Construct is valid for a period equal to that of Improvement Permit – not to exceed sixty months.

Signed: Robert J. Barkley date 5-15-00

Improvement Permit by: C. [signature] RS date 5/15/00

Authorization to Construct by: C [signature] RS date 5/15/00

Installed by: Tucker's Grading

Operation Permit by: [signature] RST date 9/27/00

Existing System Inspection by: _____ date _____

HEALTH DEPT. COPY: WHITE OWNER COPY (FINAL): YELLOW OWNER COPY (INITIAL): PINK