45624

IREDELL COUNTY HEALTH DEPARTMENT

STATESVILLE 704-878-5305 MOORESVILLE 704-664-5281

IMPROVEMENT PERMIT / CERTIFICATE OF COMPLETION / OPERATION PERMIT / EXISTING SYSTEM INSPECTION

PROPERTY DESCRIPTION NO. 14224 DATE 7-14-93 TAX MAP NO. 46-B-118

OWNER OR CONTRACTOR Vernon A. Armstrong PHONE: Business Home

ADDRESS

LOCATION I-77S To Amity Hill Rd TR Pilch Rd TR Peartree towards end on left

SUBDIVISION BLOCK / SECTION LOT LOT AREA 5.839 SITE CLASS. PS L.T.A.R. .4

Water Supply: ☑ Individual ☐ Community ☐ Public

Septic Tank: 1000 Gallons; STB 358 Date 3-18-93

Pump Tank: Gallons; PT Date

Nitrification Field: No Fields 1 Square Feet 900 Linear Feet 300

No Lines 3 Trench Width 36 Trench Depth 36 Gravel Depth 12

☑ New System ☐ Repair System Type: I (II) III. IV. V. VI

System Description: Conv. Gravity

Repair System Description: " "

Maintenance Agreement Required: ☐ Yes ☑ No

☑ House/Mod. Home No. Bedrooms 3 Garbage Disposal: ☐ Yes ☑ No

☐ Mobile Home No. Bathrooms 2½ Auto. Dishwasher: ☐ Yes ☑ No


☐ Business No. Employees Auto. Washing Machine: ☐ Yes ☐ No

☐ Other Other


☐ Slab ☐ Crawl Space ☑ Basement w/plumbing ☐ Basement wo/plumbing

Comments

INITIAL SITE SKETCH

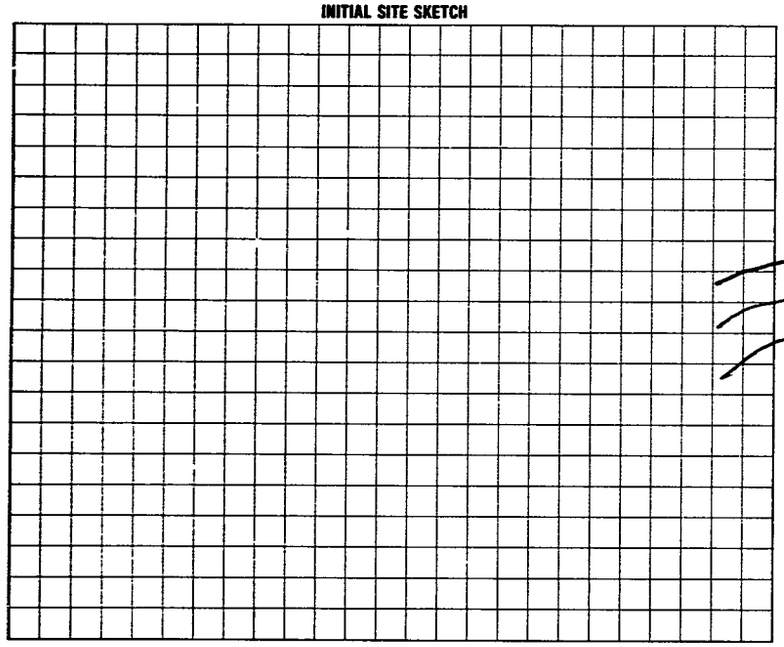

AS BUILT SKETCH

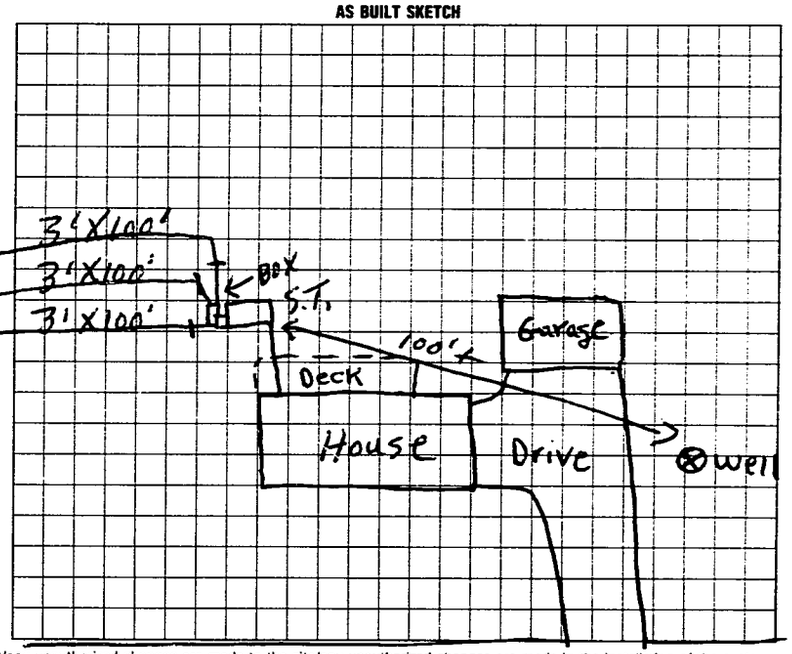

I understand that this permit can be suspended or revoked if any false information is supplied toward securing the permit/any unauthorized changes are made to the site/any unauthorized changes are made in the installation of the system. Improvement Permit is valid for 60 months from date of issuance.

Signed:

Improvement Permit by: date

Existing System Inspection by: date

Installed by: Jammy Reavis Road

Certificate of Completion by: C. C. Moore date 7-14-93

Operation Permit by: date

HEALTH DEPT. COPY: WHITE INSPECTION COPY (FINAL): GREEN OWNER COPY (FINAL): YELLOW INSPECTION COPY (INITIAL): PINK OWNER COPY (INITIAL): GOLD