IREDELL COUNTY HEALTH DEPARTMENT

STATESVILLE 704-878-5305 MOORESVILLE 704-664-5281

IMPROVEMENT PERMIT / AUTHORIZATION TO CONSTRUCT / OPERATION PERMIT / EXISTING SYSTEM INSPECTION

PERMIT# Kaufman/52779 PIN# 4742 00 6740 7858 DATE 9-16-08

OWNER OR APPLICANT The Finished Touch INC PHONE: Business 704-872-0573 Home

ADDRESS 217 South Judd Street Stat. NC 28677

LOCATION 115 South Rd Murdock Rd old Murdock Rd Timmy RD

SUBDIVISION BLOCK / SECTION LOT LOT AREA 3.16 AC SITE CLASS R5 DESIGN FLOW 360 L.T.A.R. 125

Septic Tank: 1000 Gallons; STB 1012 Date 10-10-08
Pump Tank: Gallons; PT Date
Pump Make: Model Serial No.
Nitrification Field: No Fields Square Feet 1440 Linear Feet 360
No Lines 5 Trench Width 36" Max Trench Bottom Depth 24" Gravel Depth 12"

☑ New System ☐ Repair ☐ Expansion System Type: I II III IV V VI
System Description: 2570 Gravity
Repair System Description: @ 25% Pump
Maintenance Agreement Required: ☐ Yes ☑ No

☑ House/Mod. Home ☐ Mobile Home ☐ Business ☐ Other
No. Bedrooms 3 No. Persons No. Employees


Water Supply: ☑ Individual ☐ Public ☐ Community

☑ Gravity ☐ Pressure ☐ Slab ☐ Crawl Space ☑ Basement w/plumbing ☐ Basement wo/plumbing


Comments/Conditions:
24" Depth - Trench
Well Area

Comments/Conditions:
Rake Side wall
Maintain all setbacks
Install on contour

INITIAL SITE SKETCH

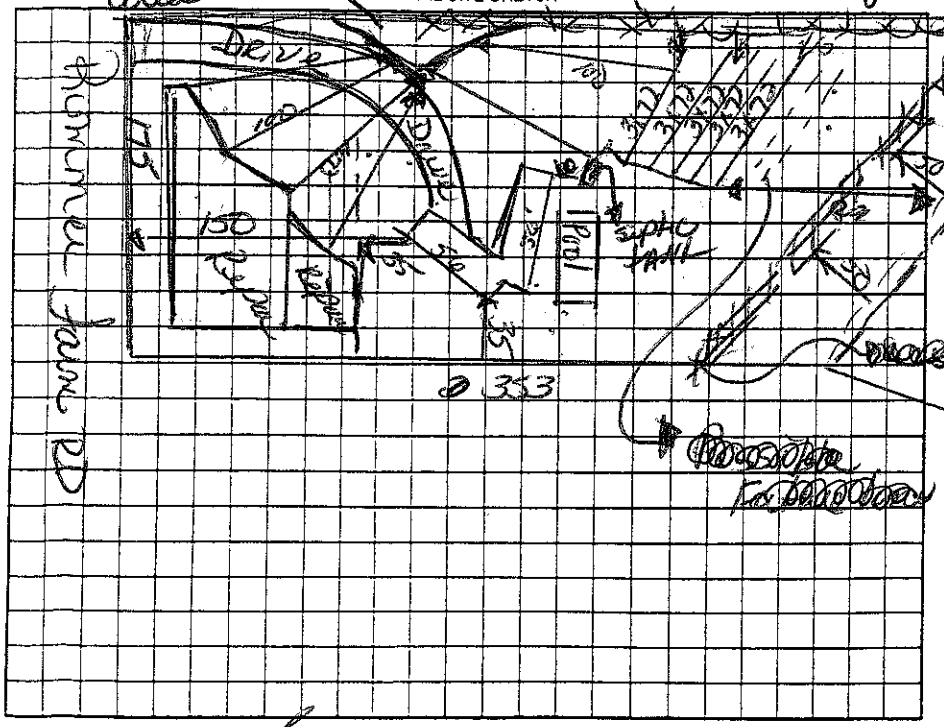

AS BUILT SKETCH

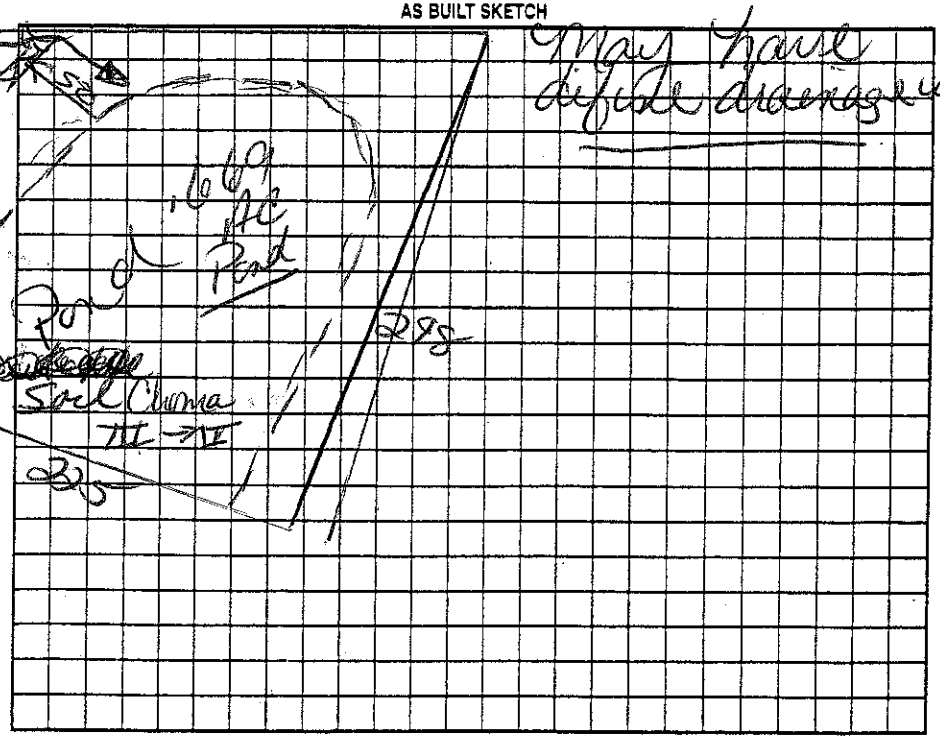

Permit can be suspended or revoked if any false information is supplied toward securing the permit/any unauthorized changes are made to the site/any unauthorized changes are made in the installation of the system. Improvement Permit with plat valid without expiration ☐ Improvement Permit with site plan valid for sixty months ☑ Authorization to Construct is valid for a period equal to that of Improvement Permit – not to exceed sixty months.

Signed: X Sheila Myers date 9-18-08 Installed by: Steve Jordan

Improvement Permit by: Kelly Cook date Operation Permit by: date 12-31-08

Authorization to Construct by: Kelly Cook date Existing System Inspection by: date

HEALTH DEPT. COPY: WHITE OWNER COPY (FINAL): YELLOW OWNER COPY (INITIAL): PINK