IREDELL COUNTY HEALTH DEPARTMENT

Statesville Office (704) 878-5305 Mooresville Office (704) 660-3625 PERMIT # 181233

IMPROVEMENT PERMIT / AUTHORIZATION TO CONSTRUCT / OPERATION PERMIT / EXISTING SYSTEM

PIN # 4742005265

APPLICANT: MARK TAYLOR APPLICANT ADDRESS: 102 FOUR WINDS DR. STATESVILLE NC PHONE: ALT. PHONE: 704 902 6363

SITE ADDRESS: 171 RIMMER FARM RD TROUTMAN, NC

SITE DIRECTIONS: OLD MURDOCH RD - TR RIMMER FARM RD - ON LT

SUBDIVISION: JANET BARNER ESTATE SECTION: LOT # 2 LOT AREA: 3.068AC DESIGN FLOW: 360 L.T.A.R.: .3

Septic Tank 1000 (gal) STB 1612-1000 Date 8-22-13

Pump Tank (gal) PT Date

Pump Make Model Serial #

Nitrification Fields 1 # Lines 3 Linear Ft: 300

Trench Width 36" Max. Trench Bottom Depth 36" Gravel Depth N/A

☑ New System ☐ Repair ☐ Expansion System Type: I II (III) IV V VI

System Description: GRAVITY 25% REDUCTION

Repair System Description: PUMP SAME

Maintenance Agreement Required: ☐ YES ☑ NO

☑ GRAVITY ☐ PRESSURE

☑ Residence No. Bedrooms 3

☐ Business No. Persons 6

☐ Other No. Employees


☐ Slab ☐ Crawl Space

☑ Basement w/plumbing ☐ Basement w/o plumbing


Water Supply: ☑ Private ☐ Public ☐ Community

Comments / Conditions:

INITIAL SITE SKETCH

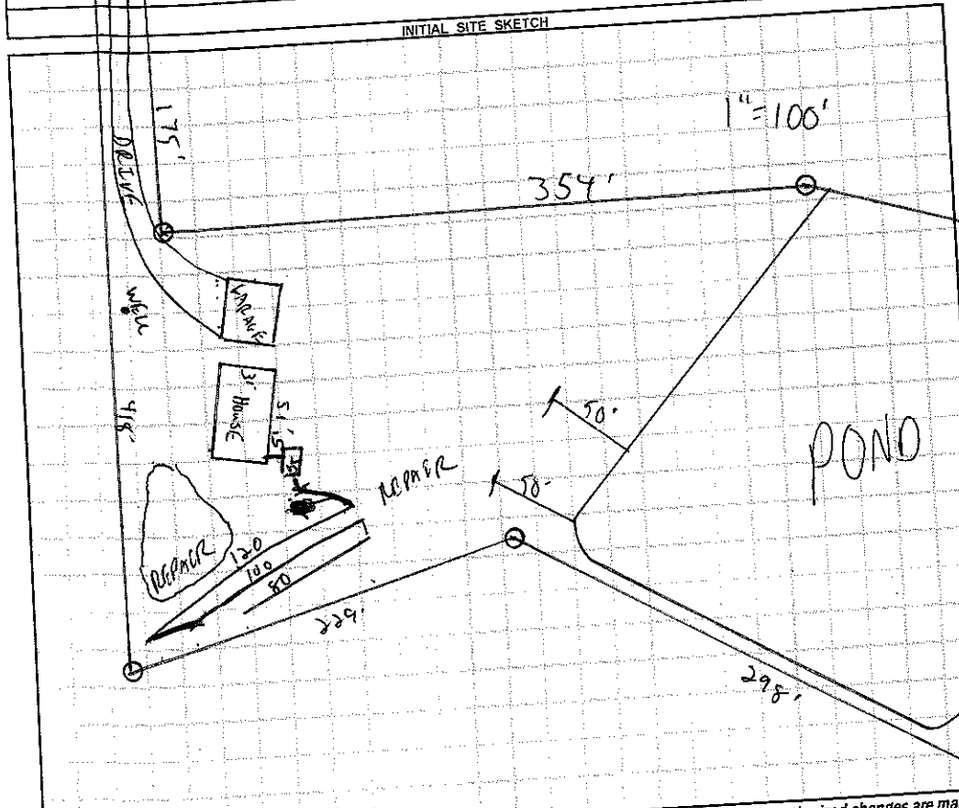

AS BUILT SKETCH

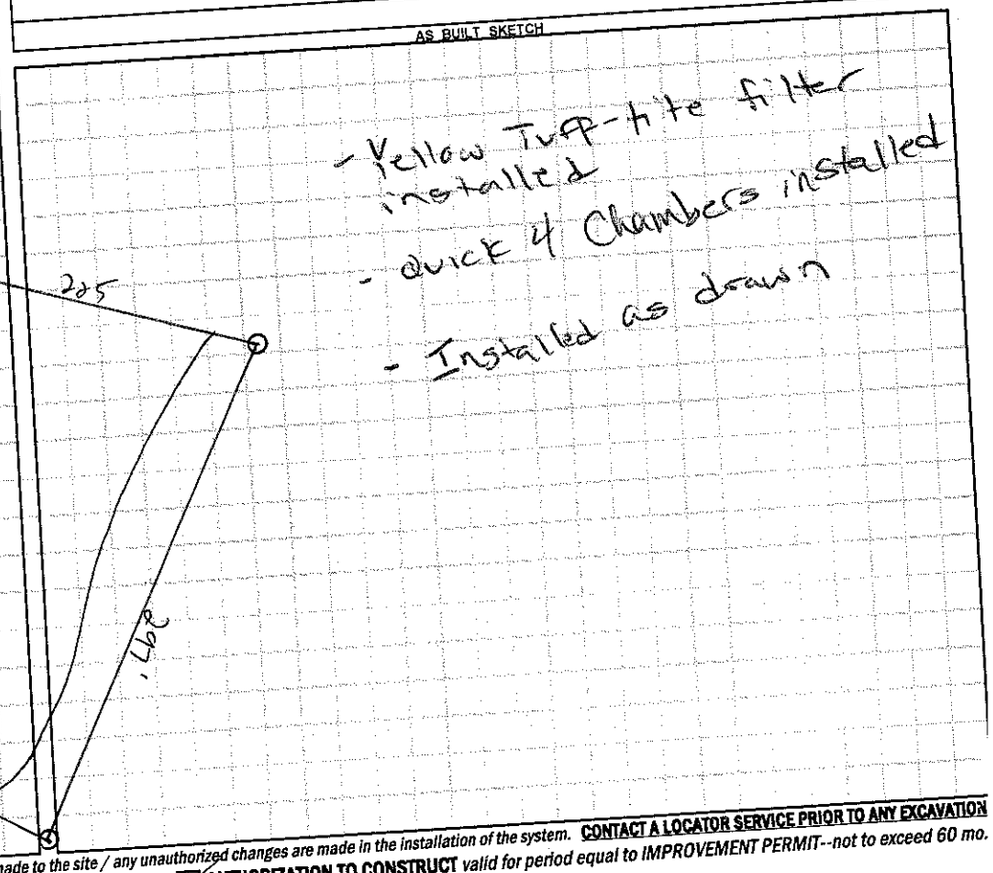

Permit can be suspended or revoked if any false information is supplied toward securing the permit / any unauthorized changes are made to the site / any unauthorized changes are made in the installation of the system. **CONTACT A LOCATOR SERVICE PRIOR TO ANY EXCAVATION**

☐ **IMPROVEMENT PERMIT** *with plat* valid without expiration.

☑ **IMPROVEMENT PERMIT** *with site plan* valid for 60 mos.

☑ **AUTHORIZATION TO CONSTRUCT** valid for period equal to IMPROVEMENT PERMIT--not to exceed 60 mo.

Owner / Applicant Signature: Date: 10-31-13

IMPROVEMENT PERMIT by: Date: 10/10/13

AUTHORIZATION TO CONSTRUCT by: Date: 10/10/13

Installed by: Steve Jordan Date: 6-9-14

OPERATION PERMIT by: Justin Henderson Date:

Existing System Inspected by:

Health Dept. Copy - WHITE Applicant (Final Approval) - YELLOW Applicant (Conditional Approval) - PINK