120823

IREDELL COUNTY HEALTH DEPARTMENT

STATESVILLE 704-878-5305 MOORESVILLE 704-664-5281

IMPROVEMENT PERMIT / AUTHORIZATION TO CONSTRUCT / OPERATION PERMIT / EXISTING SYSTEM INSPECTION

PERMIT# CITY OF TROUTMAN PIN# ~~4742-00-6873~~ 11-03363 DATE 4-20-04

OWNER OR CONTRACTOR GERALD RIMMER PHONE: Business _____ Home 704-902-1050

ADDRESS P.O. BOX 582 TROUTMAN, NC 28166 (295 MURDOCK RD)

LOCATION I-77 S EXIT 45 MAKE (R) (L) OLD MURDOCK BESIDE BRICK HOUSE BEFORE THOMASVILLE INDUSTRIES

SUBDIVISION _____ BLOCK / SECTION _____ LOT _____ LOT AREA 1.472 SITE CLASS. PS DESIGN FLOW 360 L.T.A.R. .2 GPD/FT²

Septic Tank: 1000 Gallons; STB 1012 Date 3-9-04
Pump Tank: _____ Gallons; PT _____ Date _____
Pump Make: _____ Model _____ Serial No. _____
Nitrification Field: No Fields 1 Square Feet 1800 Linear Feet 450
No Lines 4 Trench Width 36" Max Trench Bottom Depth 24" Gravel Depth N/A

☑ New System ☐ Repair System Type: I, II, (III) IV, V, VI
System Description: GRAVITY 25% REDUCTION
Repair System Description: GRAVITY PANEL 50% RED.
Maintenance Agreement Required: ☐ Yes ☑ No


☑ House/Mod. Home No. Bedrooms 3
☐ Mobile Home No. Bathrooms 2
☐ Business No. Employees ____
☐ Other _____
☐ Slab ☑ Crawl Space ☐ Basement w/plumbing ☐ Basement wo/plumbing

Water Supply: ☑ Individual ☐ Public ☐ Community EXISTING


Comments/Conditions: (1) INSTALL LINES 24" ON CONTOUR
(2) INSTALL FRENCH DRAIN AT 48" MAINTAINING A 15' SETBACK FROM SIDE OF REPAIR AND 10' ABOVE INITIAL
(3) MUST GRADE OFF BERM IN FRONT OF SYSTEM

Comments/Conditions: *NOTE: FRENCH DRAIN WILL BE APPROX. 200 FT.
Tuff Tite Filter ST Marker Installed
72 Infiltrator Panels Installed

SCALE 1"=60' INITIAL SITE SKETCH

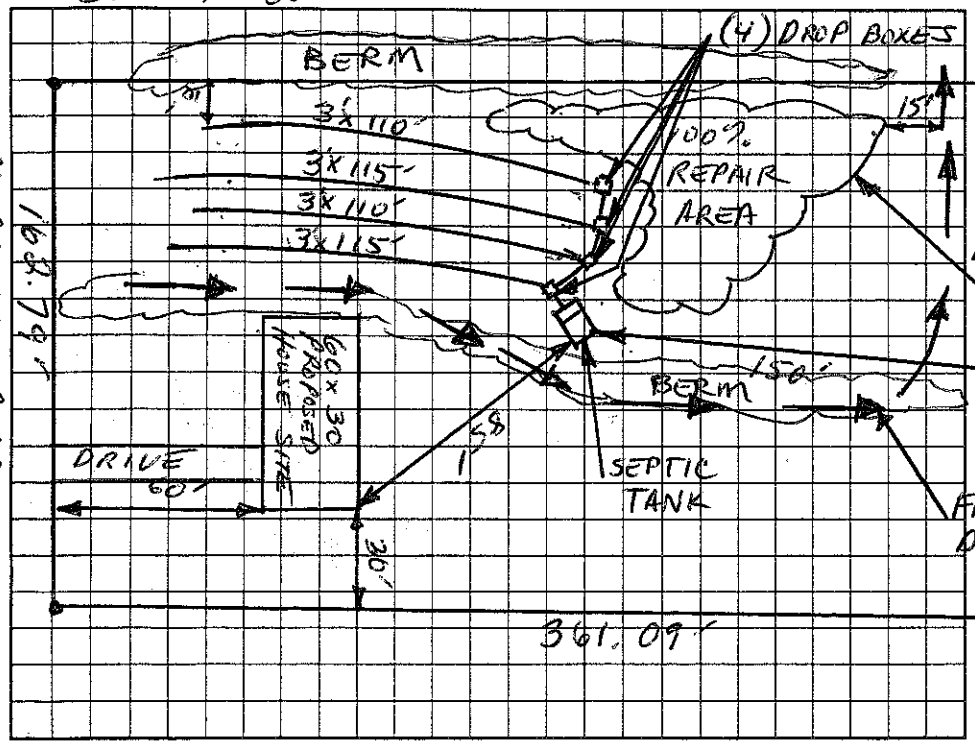

AS BUILT SKETCH

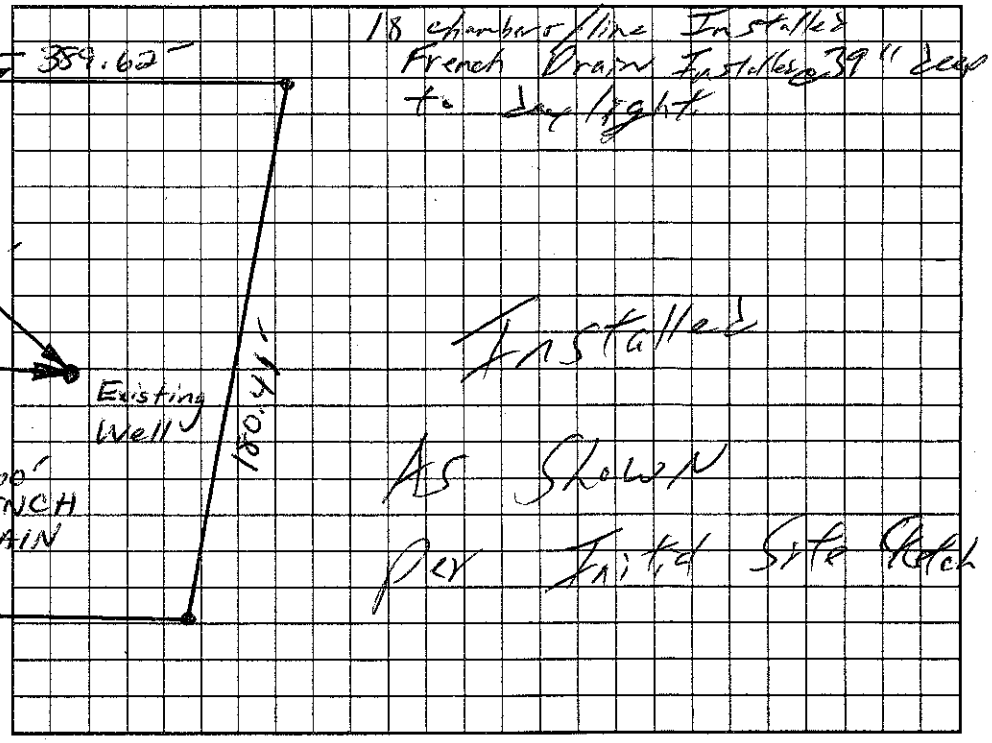

Permit can be suspended or revoked if any false information is supplied toward securing the permit/any unauthorized changes are made to the site/any unauthorized changes are made in the installation of the system. Improvement Permit with plat valid without expiration. Improvement Permit with site plan valid for sixty months. Authorization to Construct is valid for a period equal to that of Improvement Permit – not to exceed sixty months.

Signed: Janet R. Barlow date 4-20-04
Improvement Permit by: Christopher M. Sheriff, RS date 4-20-04
Authorization to Construct by: Christopher M. Sheriff, RS date 4-20-04

Installed by: Steve Jordan
Operation Permit by: William O. John date 8/4/04
Existing System Inspection by: _____ date _____

HEALTH DEPT. COPY: WHITE OWNER COPY (FINAL): YELLOW OWNER COPY (INITIAL): PINK