IREDELL COUNTY HEALTH DEPARTMENT

STATESVILLE 704-878-5305 MOORESVILLE 704-664-5281

IMPROVEMENT PERMIT / AUTHORIZATION TO CONSTRUCT / OPERATION PERMIT / EXISTING SYSTEM INSPECTION

PERMIT# TROUTMAN 76399 PIN# 4742200481 DATE 8-21-98

OWNER OR CONTRACTOR GERALD R. RIMMER PHONE: Business Home 871-6736

ADDRESS P.O. BOX 582, TROUTMAN, NC 28166

LOCATION US 21 SOUTH, TL MURDOCK ROAD, 0.3 MILE ON RIGHT, ~ 1000' BACK OFF ROAD

SUBDIVISION BLOCK / SECTION LOT LOT AREA 33.075 ACRE SITE CLASS. PS DESIGN FLOW 360 L.T.A.R. 0.25 SPA/FT2

Septic Tank: 1000 Gallons; STB 1012 Date 11-3-98
Pump Tank: Gallons; PT Date
Pump Make: Model Serial No.
Nitrification Field: No Fields 1 Square Feet 1490 Linear Feet 480
No Lines Four Trench Width 36" Max Trench Bottom Depth 36"

[X] New System [ ] Repair System Type: I, II, III, IV, V, VI
System Description: CONVENTIONAL GRAVITY
Repair System Description: CONV. GRAVITY
Maintenance Agreement Required: [ ] Yes [X] No
Gravel Depth 12" [ ] Slab [X] Crawl Space [ ] Basement w/plumbing [X] Basement wo/plumbing


[X] House/Mod. Home No. Bedrooms 3
[ ] Mobile Home No. Bathrooms 3
[ ] Business No. Employees
[ ] Other

Water Supply: [X] Individual [ ] Public [ ] Community WELL

Comments:/Conditions: KEEP SYSTEM MINIMUM 100 FEET FROM WELL.

Comments:/Conditions:

INITIAL SITE SKETCH SCALE: 1"=50'

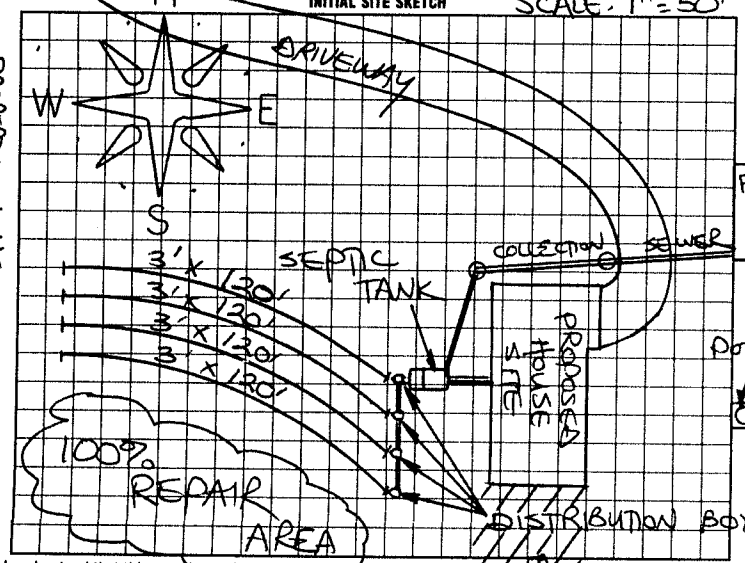

AS BUILT SKETCH

SYSTEM INSTALLED ACCORDING TO INITIAL SITE SKETCH

I understand that this permit can be suspended or revoked if any false information is supplied toward securing the permit/any unauthorized changes are made to the site/any unauthorized changes are made in the installation of the system. Improvement Permit with plat valid without expiration. Improvement Permit with site plan valid for sixty months. Authorization to Construct is valid for a period equal to that of Improvement Permit – not to exceed sixty months.

Signed: [signature] date 8-21-98 Installed by: STEVE JORDAN

Improvement Permit by: STEVE HEDRICK date 8-21-98 Operation Permit by: STEVE HEDRICK date 2-9-99

Authorization to Construct by: STEVE HEDRICK date 8-21-98 Existing System Inspection by: date

HEALTH DEPT. COPY: WHITE INSPECTION COPY (FINAL): GREEN OWNER COPY (FINAL): YELLOW INSPECTION COPY (INITIAL): PINK OWNER COPY (INITIAL): GOLD