IREDELL COUNTY HEALTH DEPARTMENT - *ENVIRONMENTAL HEALTH* ☒ STATESVILLE OFFICE 704-878-5305 ☐ MOORESVILLE OFFICE 704-664-5281

IMPROVEMENT PERMIT / AUTHORIZATION TO CONSTRUCT / OPERATION PERMIT / EXISTING SYSTEM INSPECTION

PERMIT # 17218Z PIN # 4744285558 DATE 5-9-12

OWNER Joseph Hess APPLICANT: Same PHONE: Home/Cell # 704-450-0690 Business # SAME

SITE ADDRESS Moose Club Rd. OWNER / APPLICANT ADDRESS PO Box 6921 Statesville NC 28677

SITE DIRECTIONS Hwy 21 South; (L) on Moose Club Rd.; Property on Right about 1 mile

SUBDIVISION N/A BLOCK / SECTION N/A LOT # N/A LOT AREA 1.243 DESIGN FLOW 360 gpd L.T.A.R. 0.25

Septic Tank 1000 Gallons: STB 794 Date 4-14-17
Pump Tank ____ Gallons: P T ____ Date ____
Pump Make ____ Model ____ Serial # ____
No. Nitrification Fields: 1 No. Lines 4 Linear Feet 360'
Trench Width 36" Max. Trench Bottom Depth 31" Gravel Depth N/A

☑ New System ☐ Repair ☐ Expansion System Type I II (III) IV V VI
System Description: 25% Reduction System
Repair System Description: 25% Reduction System
Maintenance Agreement Required ☐ YES ☑ NO
☑ GRAVITY ☐ PRESSURE


☑ Residence No. Bedrooms 3
☐ Business No. Persons ____
☐ Other No. Employees ____
☐ Slab ☐ Crawl Space
☐ Basement w/plumbing ☑ Basement w/o plumbing

Water Supply: ☑ Private ☐ Public ☐ Community


Comments / Conditions: Install 25% Reduction System on Contours w/ serial distribution

- Red polylok filter, installed; Tank marker installed
- ARC 36; KY-PIL-0013 PSA Inc 3613 BD

INITIAL SITE SKETCH

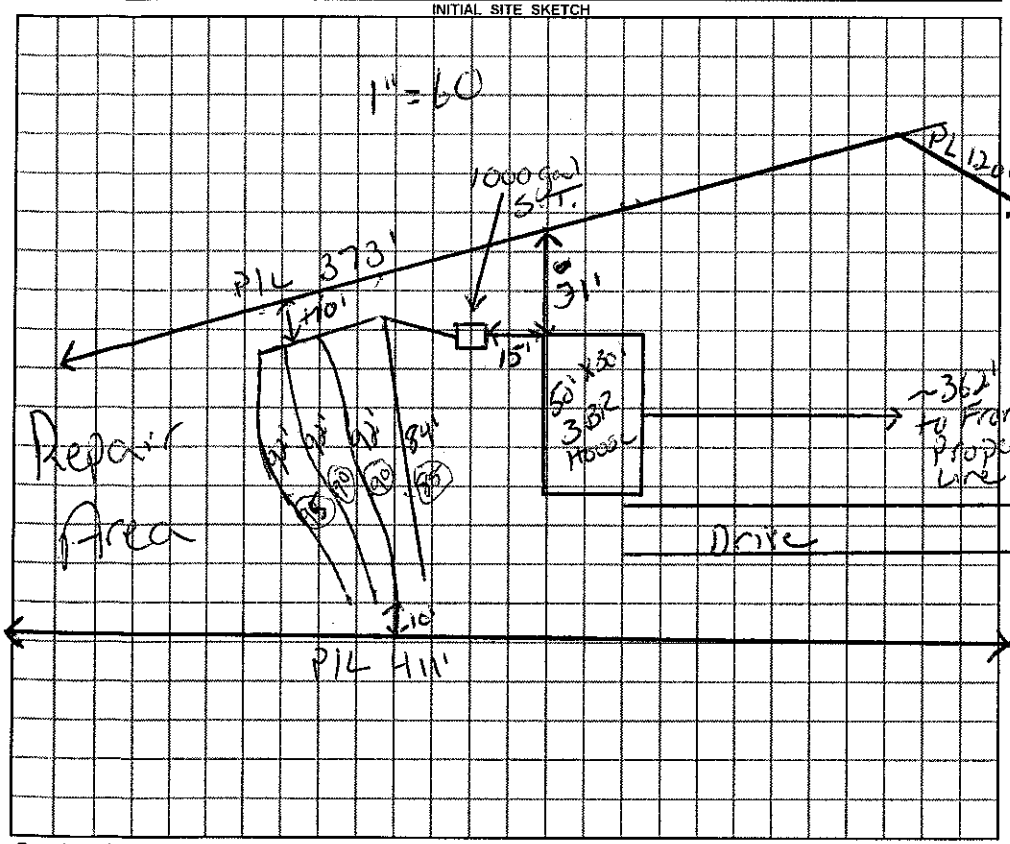

AS BUILT SKETCH

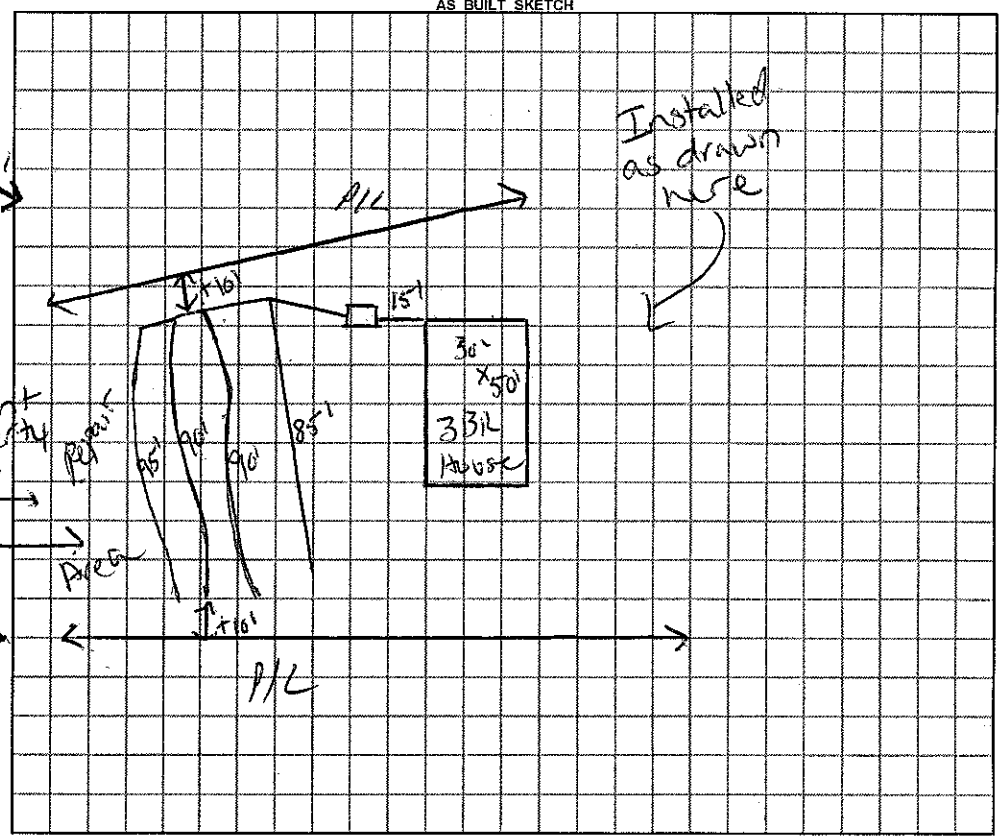

Permit can be suspended or revoked if any false information is supplied toward securing the permit / any unauthorized changes are made to the site / any unauthorized changes are made in the installation of the system.

☐ ***IMPROVEMENT PERMIT*** with plat valid without expiration. ☑ ***IMPROVEMENT PERMIT*** with plat ~~valid without expiration.~~ site plan valid 60 mo. ☑ ***AUTHORIZATION TO CONSTRUCT*** valid for period equal to IMPROVEMENT PERMIT--not to exceed 60 mo.

Owner / Applicant Signature: [signature] Date 5-10-12 Installed by: Maiden Grading + Septic Tank

IMPROVEMENT PERMIT by: Justin Henderson REHS Date 5-9-12 OPERATION PERMIT by: Justin Henderson REHS Date 5-22-17

AUTHORIZATION TO CONSTRUCT by: Justin Henderson REHS Date 5-9-12 Existing System Inspected by: REHS Date

YOU SHOULD CONTACT A LOCATOR SERVICE PRIOR TO ANY EXCAVATION

White Copy – Environmental Health YELLOW COPY (Final) Owner / Applicant PINK COPY (Initial) Owner / Applicant