IREDELL COUNTY HEALTH DEPARTMENT

STATESVILLE 704-878-5305 100.00 MOORESVILLE 704-664-5281

IMPROVEMENT PERMIT / AUTHORIZATION TO CONSTRUCT / OPERATION PERMIT / EXISTING SYSTEM INSPECTION

PERMIT# 073750 PIN# 4743105847 (pt) DATE 9-2-98

OWNER OR CONTRACTOR Fox DEN ACRES / JIM SLOOP PHONE: Business 567-9836 Home

ADDRESS 5201 Monroe Rd. Charlotte 28205

LOCATION Moose Club Rd Turn on Skyuka Rd. TR on Arlie Loop stay left to Apple Valley Ln. At End on left

SUBDIVISION Apple Valley BLOCK / SECTION LOT 21 LOT AREA 1.48Ac. SITE CLASS. PS DESIGN FLOW 360gpd L.T.A.R. .3

Septic Tank: 1000 Gallons; STB 1012 Date 9-20-00
Pump Tank: Gallons; PT Date
Pump Make: Model Serial No.
Nitrification Field: No Fields 1 Square Feet 1200 Linear Feet 400
No Lines 3@134' Trench Width 36" Max Trench Bottom Depth 24" Gravel Depth 12"

☑ New System ☐ Repair System Type: I, (II), III, IV, V, VI
System Description: gravity conventional
Repair System Description: same
Maintenance Agreement Required: ☐ Yes ☑ No

☐ House/Mod. Home No. Bedrooms 3
☑ Mobile Home No. Bathrooms 2
☐ Business No. Employees
☐ Other


☐ Slab ☑ Crawl Space ☐ Basement w/plumbing ☐ Basement wo/plumbing

Water Supply: ☑ Individual ☐ Public ☐ Community

Comments:/Conditions:

Comments:/Conditions: Filter Installed

INITIAL SITE SKETCH 1" = 100'

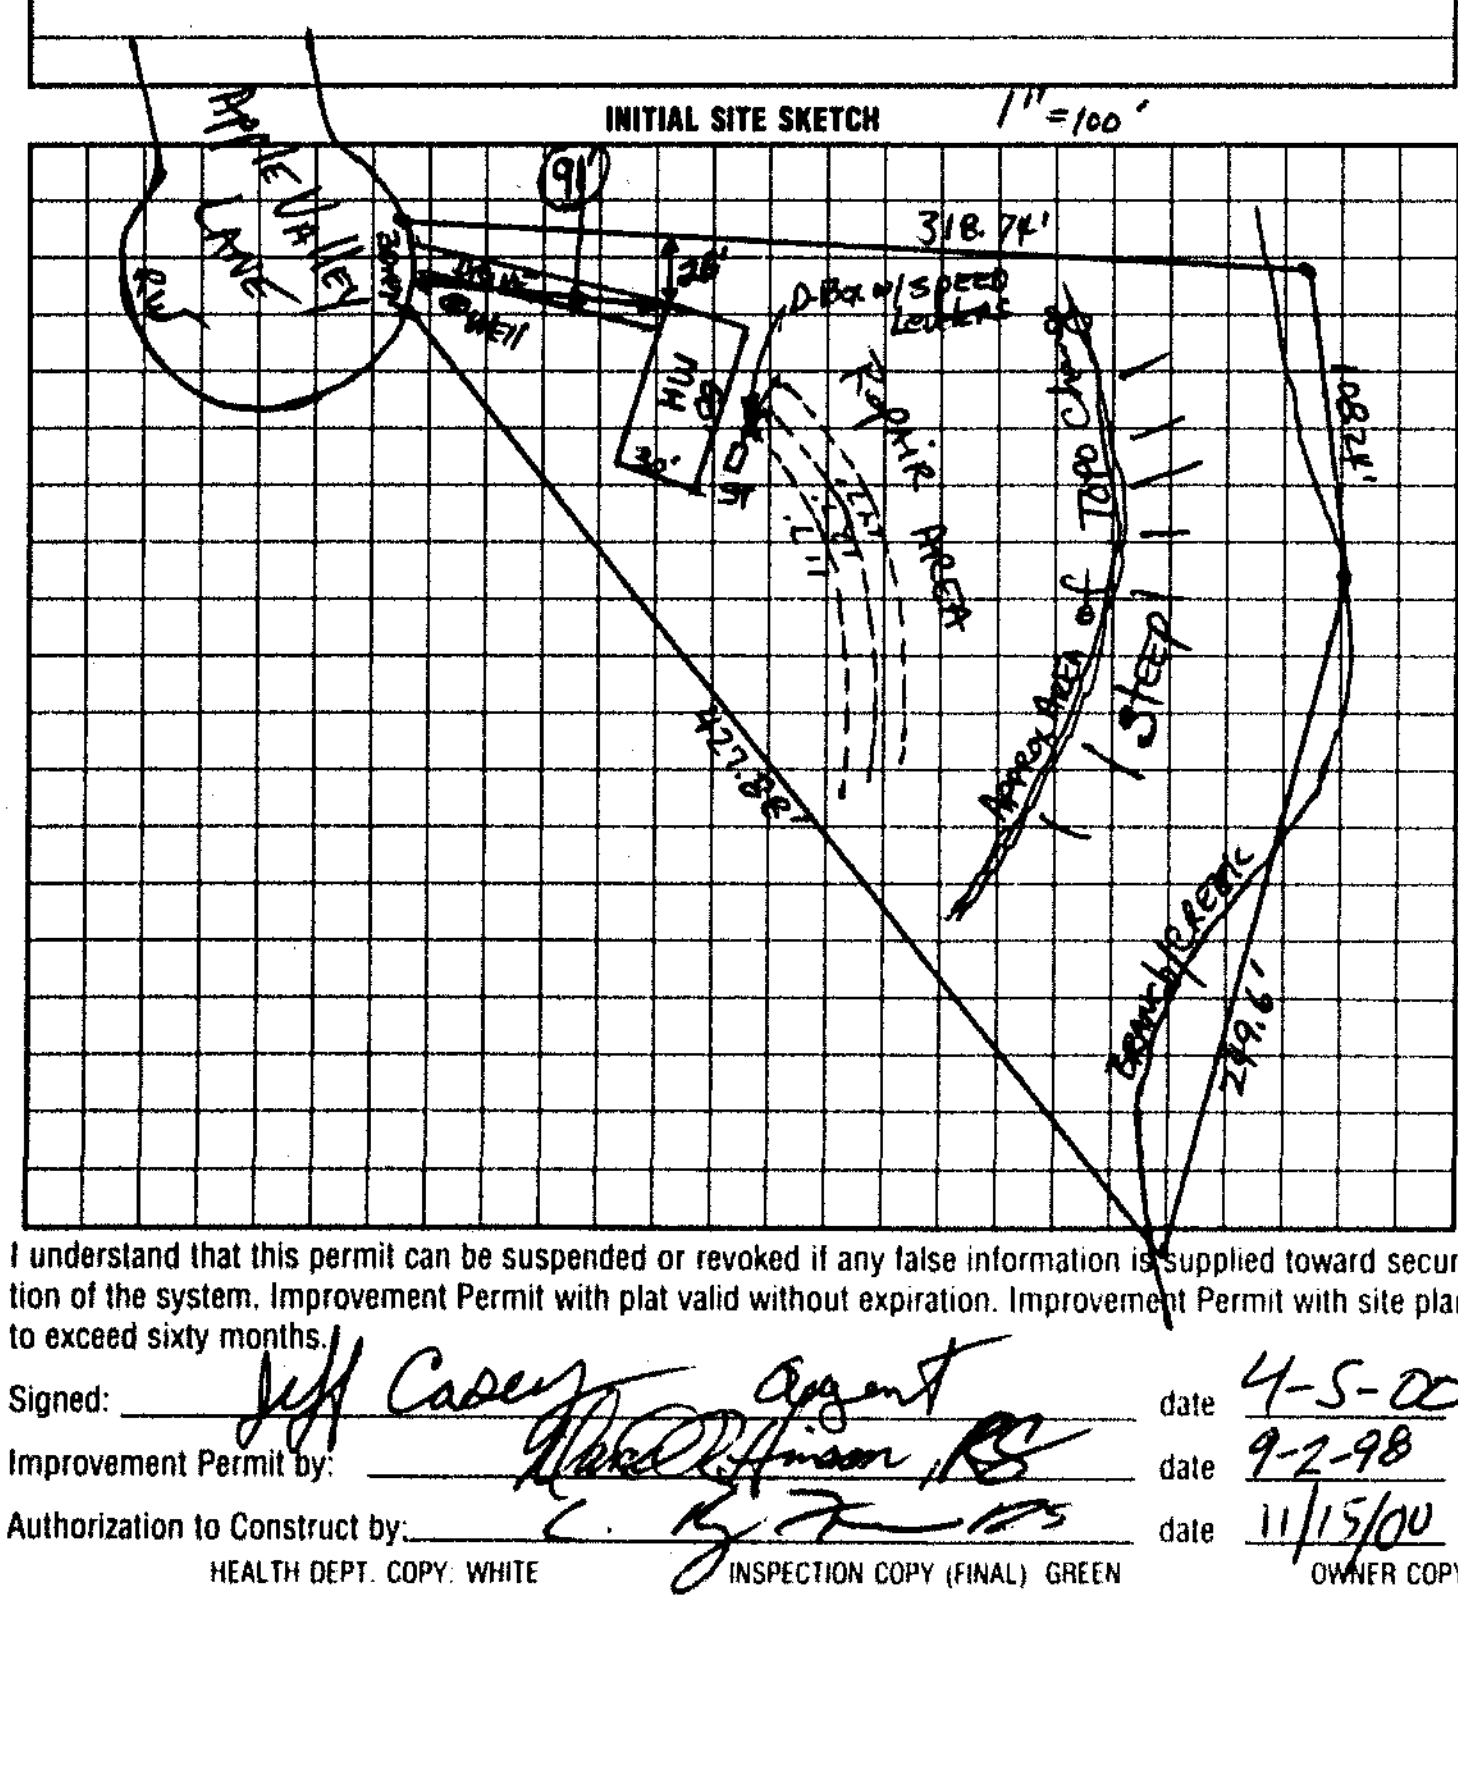

AS BUILT SKETCH

I understand that this permit can be suspended or revoked if any false information is supplied toward securing the permit/any unauthorized changes are made to the site/any unauthorized changes are made in the installation of the system. Improvement Permit with plat valid without expiration. Improvement Permit with site plan valid for sixty months. Authorization to Construct is valid for a period equal to that of Improvement Permit – not to exceed sixty months.

Signed: Jeff Casey Agent date 4-5-00
Improvement Permit by: [signature], RS date 9-2-98
Authorization to Construct by: [signature] RS date 11/15/00

Installed by: A-1 Backhoe
Operation Permit by: [signature] RSI date 12/6/00
Existing System Inspection by: date

HEALTH DEPT. COPY WHITE INSPECTION COPY (FINAL) GREEN OWNER COPY (FINAL) YELLOW INSPECTION COPY (INITIAL) PINK OWNER COPY (INITIAL) GOLD