IREDELL COUNTY HEALTH DEPARTMENT

Statesville Phone TR 3-7271 Mooresville Phone NO 3-1271

PERMIT TO INSTALL SEPTIC TANK

Permit NO. _____ Permit Date Nov 5 1963

Owner Osborne Smith Address old Amity Rd.

Installed By C Horton Address RT


Location of Property 1st paved road to Right past Mills Fish Lake 1st new brick on R.

Tank	Capacity	Length of Lines	Fixtures
Block ( )	800 ( )	150' ( )	No. of Baths (3)
Precast (+)	900 ( )	175' ( )	Dishwasher ( )
	1000 (+)	200' ( )	Garbage Grdr. ( )
	1100 ( )	225' ( )	Auto-Washer (+)
	1200 ( )	250' ( )	Other _____
	Other _____	Other 240'	

NOTIFY HEALTH DEPARTMENT AT LEAST EIGHT HOURS BEFORE TANK IS TO BE INSPECTED.

Final Inspection 11-5 1963 Approved (1) Disapproved ( )

Remarks No well on property at this time

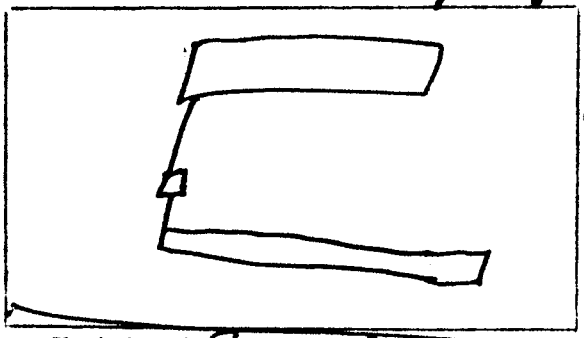

48" Cover over lines due to plumbing rough out of basement.

Sketch of Installation

R.L.

Sanitarian