**IREDELL COUNTY HEALTH DEPARTMENT - *ENVIRONMENTAL HEALTH*** ☒ STATESVILLE OFFICE 704-878-5305 ☐ MOORESVILLE OFFICE 704-664-5281

**IMPROVEMENT PERMIT / AUTHORIZATION TO CONSTRUCT / OPERATION PERMIT @ / EXISTING SYSTEM INSPECTION**

PERMIT # 165191 PIN # 4742-29-6214 DATE 2-8-11

OWNER Joseph Robinson APPLICANT: Shellane Builders PHONE: Home/Cell # 828-635-6509 Business # 828-312-3220

SITE ADDRESS 423 Moose Club Rd. OWNER / APPLICANT ADDRESS 600 York Last Rd Hiddenite, NC 28636

SITE DIRECTIONS Hwy 215 to (L) on Moose Club, 423 on (L)

SUBDIVISION n/a BLOCK / SECTION n/a LOT # n/a LOT AREA 623 x 74' DESIGN FLOW 240 L.T.A.R. Ex.

Septic Tank Ex Gallons: STB Ex Date
Pump Tank Gallons: P T Date
Pump Make Model Serial #
No. Nitrification Fields: Ex No. Lines Ex Linear Feet Ex
Trench Width Ex Max. Trench Bottom Depth Ex Gravel Depth Ex


☐ New System ☐ Repair ☐ Expansion System Type I II III IV V VI
System Description: Existing
Repair System Description:
Maintenance Agreement Required ☐ YES ☒ NO
☒ GRAVITY ☐ PRESSURE

☒ Residence No. Bedrooms 2
☐ Business No. Persons
☐ Other No. Employees
☐ Slab ☒ Crawl Space
☐ Basement w/plumbing ☐ Basement w/o plumbing


Water Supply: ☒ Private ☐ Public ☐ Community

Comments / Conditions

INITIAL SITE SKETCH

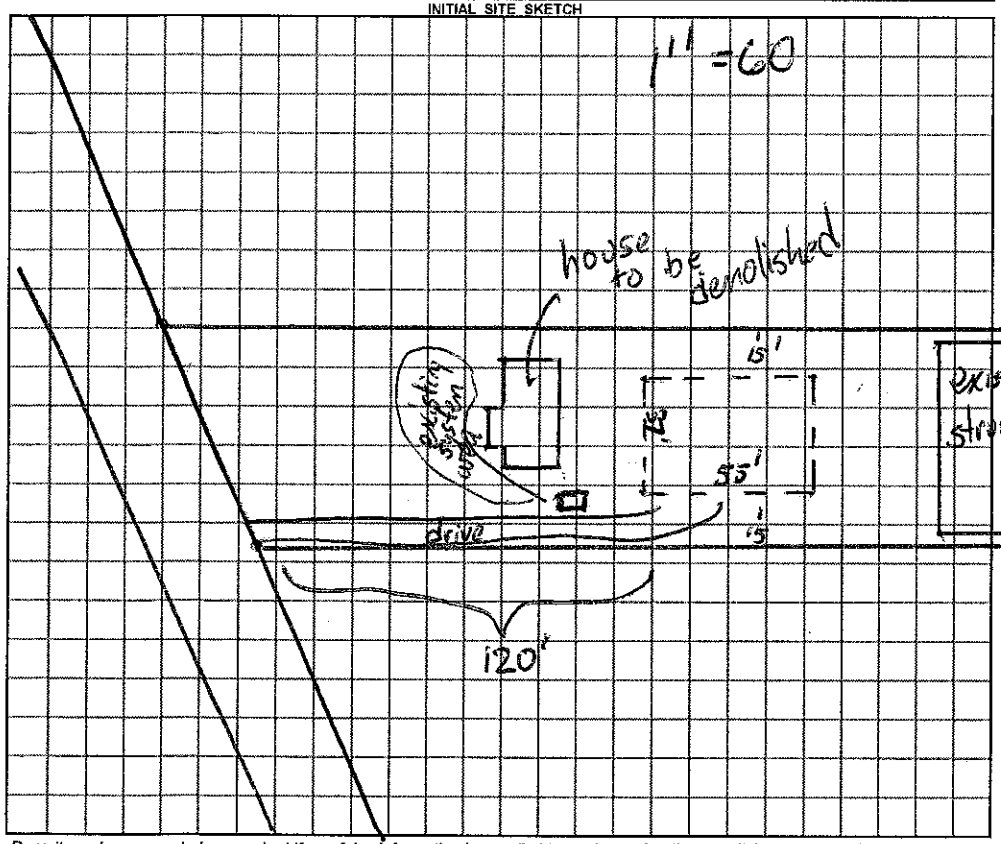


AS BUILT SKETCH

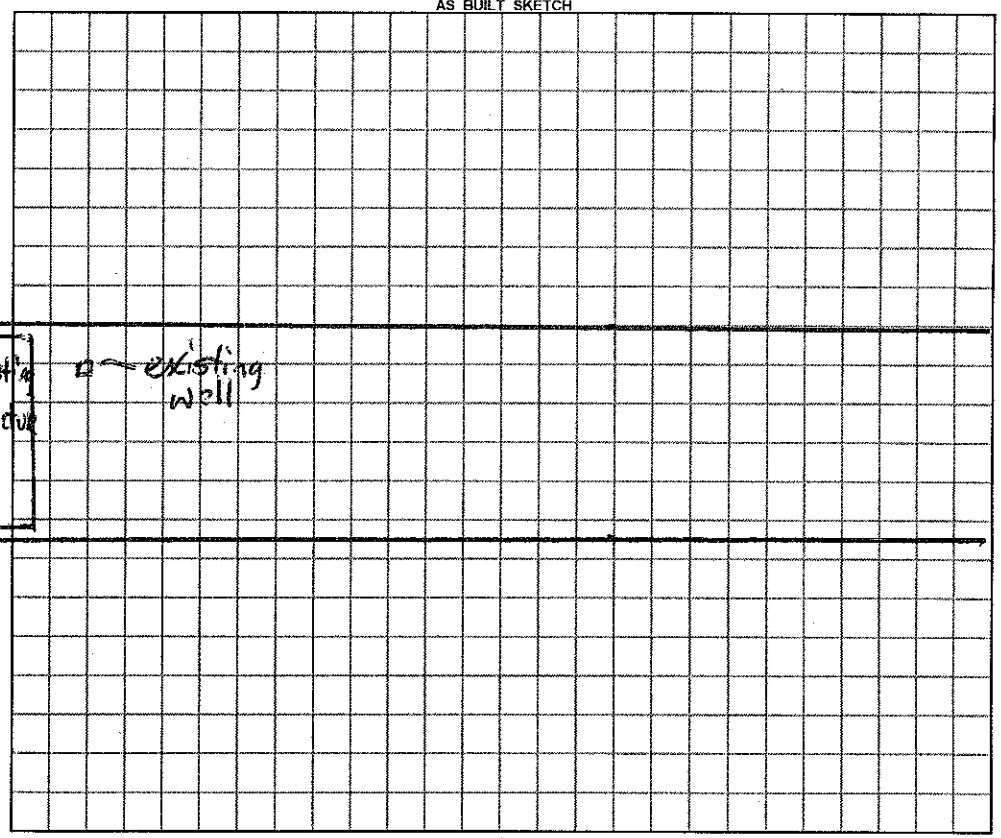


*Permit can be suspended or revoked if any false information is supplied toward securing the permit / any unauthorized changes are made to the site / any unauthorized changes are made in the installation of the system.*

☐ ***IMPROVEMENT PERMIT*** *with plat valid without expiration.* ☒ ***IMPROVEMENT PERMIT*** *with plat valid without expiration.* ☒ ***AUTHORIZATION TO CONSTRUCT*** valid for period equal to IMPROVEMENT PERMIT–not to exceed 60 mo.

Owner / Applicant Signature: [signature] Date 2/21/11 Installed by:

IMPROVEMENT PERMIT by: REHS Date OPERATION PERMIT by: REHS Date

AUTHORIZATION TO CONSTRUCT by: REHS Date Existing System Inspected by: James REHS Date 2-8-11

***YOU SHOULD CONTACT A LOCATOR SERVICE PRIOR TO ANY EXCAVATION***

White Copy – Environmental Health YELLOW COPY (Final) Owner / Applicant PINK COPY (Initial) Owner / Applicant