ICHD - ENVIRONMENTAL HEALTH DIVISION

Statesville Office (704) 878-5305 Mooresville Office (704) 660-3625 PERMIT # 308511

SEPTIC: IMPROVEMENT PERMIT / AUTHORIZATION TO CONSTRUCT / OPERATION PERMIT / EXISTING SYSTEM

PIN # 4742318183

APPLICANT/OWNER: Boyce Gallihet APPLICANT ADDRESS: 165 Ashley Acres Road Statesville NC 28677

SITE ADDRESS: 130 Leona Lane Troutman NC 28166 PHONE: 704-402-2795 ALT. PHONE -


SITE DIRECTIONS: South 21 L on Murdock Rd R on Leona 3rd Lot SAP CONTROLLED: ☐ YES ☒ NO

SUBDIVISION: Sherry Cash + Lisa Davis SECTION: - LOT # 2 LOT AREA: 2.67 Acre DESIGN FLOW: 360gpd L.T.A.R.: .3

Septic Tank	Ex	(gal)	STB	Date	☐ New System ☐ Repair ☒ Expansion System Type: I II III IV V VI	☒ Residence	No. Bedrooms	3	Water Supply		
Pump Tank		(gal)	PT	Date	System Description: 25% Reduction	☐ Business	No. Persons	6	☒ Private		
Pump Make		Model		Serial #	Repair System Description: 25% Reduction	☐ Other	No. Employees		☐ Public		
# Nitrification Fields	1	# Lines	1	Linear Ft: 100	Maintenance Agreement Required: ☐ YES ☒ NO	☐ Slab	☒ Crawl Space		☐ Community		
Trench Width	36"	Trench Bottom Depth(~~Low side~~)	Max 36"	Gravel Depth -	☒ GRAVITY ☐ PRESSURE	☐ Basement w/plumbing			☐ Basement w/o plumbing		

Comments / Conditions: Existing System Functioning properly at time of inspection. Add 100' of 25% Reduction. Install on Contour feed line from existing D Box. Inspect and replace D Box if needed.

INITIAL SITE SKETCH

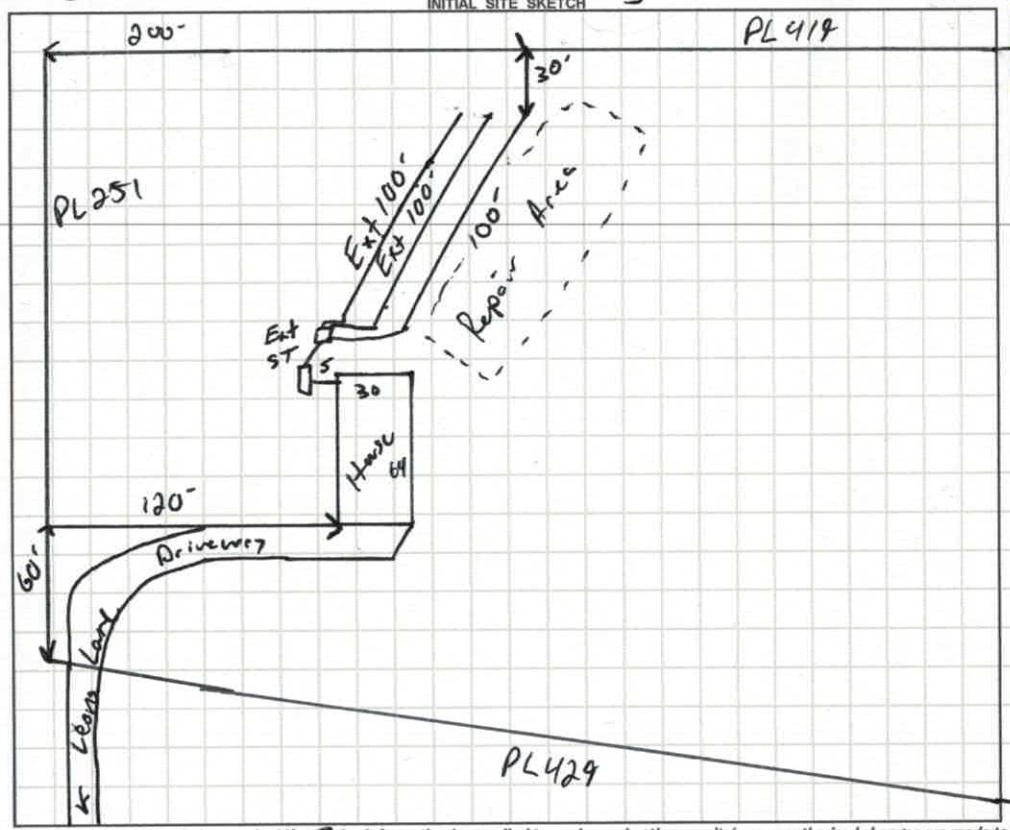

AS BUILT SKETCH

FOR SEPTIC FINAL INSPECTION CALL: 704-664-3703 between 8am-9am the day the inspection is needed. Be sure to speak with an inspector to confirm your time.

1" = 80'

INSTALLED AS PERMITTED

PL 305'

Permit can be suspended or revoked if any false information is supplied toward securing the permit / any unauthorized changes are made to the site / any unauthorized changes are made in the installation of the system. **CONTACT A LOCATOR SERVICE PRIOR TO ANY EXCAVATION**

☐ **IMPROVEMENT PERMIT** *with plat valid without expiration.* ☒ **IMPROVEMENT PERMIT** *with site plan valid for 60 mos.* ☒ **AUTHORIZATION TO CONSTRUCT** *valid for period equal to IMPROVEMENT PERMIT--not to exceed 60 mo.*

Owner / Applicant Signature: Boyce Gallihet Date: 7-13-20 Installed by: ATLAS SOLUTIONS

IMPROVEMENT PERMIT by: Date: 7-13-2020 OPERATION PERMIT by: Burkett C. White Date: 7-28-20

AUTHORIZATION TO CONSTRUCT by: Date: 7-13-2020 Existing System Inspected by: Date:

FOR SEPTIC FINAL INSPECTION: CALL 704-664-3703 between 8am-9am the day the inspection is needed.

DEPARTMENT OF HEALTH AND HUMAN SERVICES
DIVISION OF PUBLIC HEALTH, ENVIRONMENTAL HEALTH SECTION
ON-SITE WATER PROTECTION BRANCH

Sheet 1 of 1
PROPERTY ID #: 9743818
COUNTY: Iredell

SOIL/SITE EVALUATION
for ON-SITE WASTEWATER SYSTEM
(Complete all fields in full)

OWNER: Lisa Davis
APPLICATION DATE 6-10-20
ADDRESS: 433 Avon Avenue Troutman NC 28166
DATE EVALUATED: 7-8
PROPOSED FACILITY: 3BR / PROPOSED DESIGN FLOW (.1949): 360gpd
PROPERTY SIZE: 2.67
LOCATION OF SITE: 130 Leone LN
PROPERTY RECORDED: Yes
WATER SUPPLY: ☐ Private ☐ Public ☑ Well ☐ Spring ☐ Other
EVALUATION METHOD: ☐ Auger Boring ☑ Pit ☐ Cut
TYPE OF WASTEWATER: ☑ Sewage ☐ Industrial Process ☐ Mixed

PROFILE #	.1940 LANDSCAPE POSITION/ SLOPE %	HORIZON DEPTH (IN.)	SOIL MORPHOLOGY (.1941) .1941 STRUCTURE/ TEXTURE	.1941 CONSISTENCE/ MINERALOGY	OTHER PROFILE FACTORS .1942 SOIL WETNESS/ COLOR	.1943 SOIL DEPTH	.1956 SAPRO CLASS	.1944 RESTR HORIZ	PROFILE CLASS & LTAR
1	2-3% SS	0-11	SBK SCL	FrSSSP Samp	N/A	48=	N/A	N/A	PS .3
		11-43	SBK C						
		43-48	SBK CL						
2	SS 2-3%	0-11	SBK SCL		N/A	48=	N/A	N/A	PS .3
		11-33	SBK C						
		33-48	SBK CL						
3	SS 2-4%	0-10	SBK SCL		Few F/B Mott @ 30~	48=	N/A	N/A	PS .25
		10-37	ABK C						
		37-48	SBK CL						
4	SS 2-3%	0-12	SBK SCL		N/A	48=	N/A	N/A	PS .3
		12-40	SBK C						
		40-48	SBK CL						

DESCRIPTION	INITIAL SYSTEM	REPAIR SYSTEM
Available Space (.1945)	300'	360'
System Type(s)	25% Reduction	25% Reduction
Site LTAR	.3	.25

OTHER FACTORS (.1946):
SITE CLASSIFICATION (.1948): PS
EVALUATED BY: Boggs
OTHER(S) PRESENT:

COMMENTS:

LEGEND

use the following standard abbreviations

LANDSCAPE POSITION	GROUP	SOIL TEXTURE	CONVENTIONAL ,1955 LTAR*	LPP ,1957 LTAR*	MINERALOGY/ CONSISTENCE	STRUCTURE
CC (Concave Slope)	I	S (Sand)	1.2 - 0.8	0.6 - 0.4	SEXP (Slightly Expansive)	G (Single Grain)
CV (Convex Slope)		LS (Loamy Sand)			EXP (Expansive)	M (Massive)
D (Drainage Way)						CR (Crumb)
DS (Debris Slump)	II	SL (Sandy Loam)	0.8 - 0.6	0.4 - 0.3		GR (Granular)
FP (Flood Plain)		L (Loam)				SBK (Subangular Blocky)
FS (Foot Slope)						ABK (Angular Blocky)
H (Head Slope)	III	Si (Silt)	0.6 - 0.3	0.3 - 0.15		PL (Platy)
L (Linear Slope)		SiCL (Silty Clay Loam)				PR (Prismatic)
N (Nose Slope)		CL (Clay Loam)				
R (Ridge)		SCL (Sandy Clay Loam)			MOIST	WET
S (Shoulder Slope)		SiL (Silt Loam)				
T (Terrace)					VFR (Very Friable)	NS (Non-sticky)
	IV	SC (Sandy Clay)	0.4 - 0.1	0.2 - 0.05	FR (Friable)	SS (Slightly Sticky)
		SiC (Silty Clay)			FI (Firm)	S (Sticky)
		C (Clay)			VFI (Very Firm v. Very Sticky)	VS (Very Sticky)
		O (Organic)	None	None	EFI (Extremely Firm)	NP (Non-plastic)
						SP (Slightly Plastic)
						P (Plastic)
						VP (Very Plastic)

*Adjust LTAR due to depth, consistence, structure, soil wetness, landscape, position, wastewater flow and quality.


NOTES

HORIZON DEPTH	In inches below natural soil surface
DEPTH OF FILL	In inches from land surface
RESTRICTIVE HORIZON	Thickness and depth from land surface
SAPROLITE	S(suitable) or U(unsuitable)
SOIL WETNESS	Inches from land surface to free water or inches from land surface to soil colors with chroma 2 or less - record Munsell color chip designation
CLASSIFICATION	S (Suitable), PS (Provisionally Suitable), or U (Unsuitable)

Evaluation of saprolite shall be by pits.

Long-term Acceptance Rate (LTAR): gal/day/ft^2

Show profile locations and other site features (dimensions, reference or benchmark, and North).

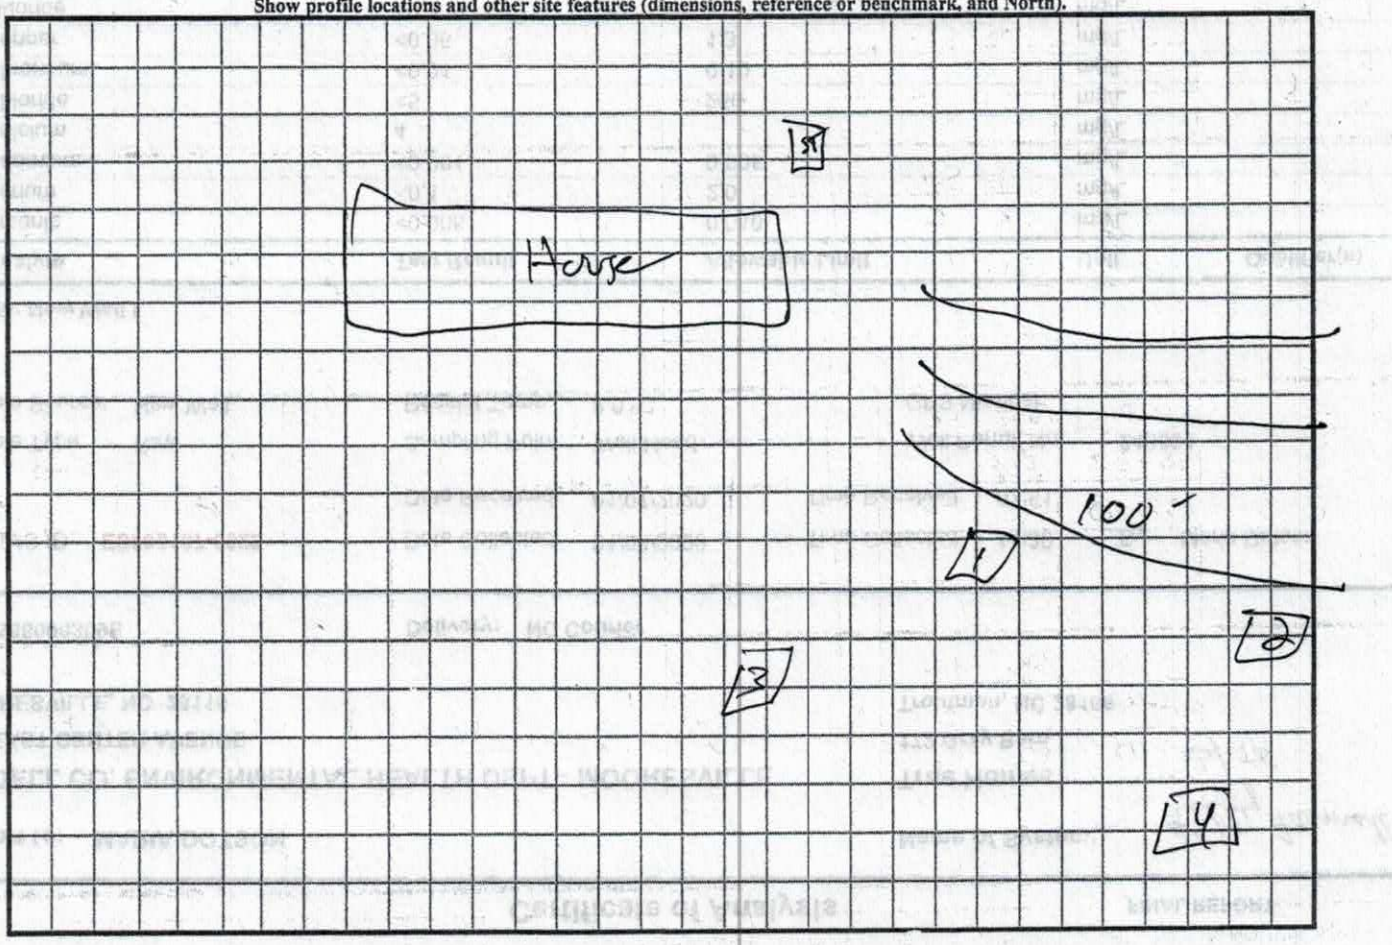

RECEIVED JUN 25 2020 AP-006011 $500.00

APPLICATION MUST BE FILLED OUT COMPLETELY & BE LEGIBLE OR IT WILL NOT BE PROCESSED

Iredell County Health Department – Environmental Health Division

PAGE 1: *APPLICATION FORM*

Application For: ( ) New Well Permit ( ) Well Repair Permit ( ) Well Abandonment
(✓) Septic Improvement Permit ( ) Authorization to Construct ( ) Existing System Inspection ( ) Septic System Repair

THE ABOVE PERMIT DOCUMENTS WILL BECOME INVALID IF INFORMATION PROVIDED ON THIS APPLICATION IS FALSIFIED OR CHANGED, OR IF THE SITE IS ALTERED. THE IMPROVEMENT PERMIT IS VALID FOR EITHER 60 MONTHS OR WITHOUT EXPIRATION DEPENDING UPON DOCUMENTATION SUBMITTED. APPLICATION WITH SITE PLAN 60 MONTHS, APPLICATION WITH COMPLETE, SCALED PLAT WITHOUT EXPIRATION. SEE 15A NCAC 18A .1937(f) FOR DETAILS.

Page 2: *Site Plan Worksheet* form MUST accompany this application

The following optional attachments may also be submitted: ( ) Survey Plat, scaled no more than 1 inch = 60 feet
Place an (X) beside whichever is submitted if applicable ( ) Custom Site Plan, scaled no more than 1 inch = 60 feet

Applicant Information: (PRINT CLEARLY)

Applicant Name: Boyce Galliher Address: 165 Ashley Acres Rd. Statesville Zip: 28677
Applicant Email: boyce.galliher@icloud.com Phone: 704-402 2795 Alt. Phone: _____
Owner Name: Lisa Davis Address: 4133 Avon Avenue Troutman N.C. Zip: 28166
Owner Email: ldavis3574@yahoo.com Phone: 704-567-8049 Alt. Phone: _____

Property Information:

Street Address: 130 Leona Lane, Troutman N.C. 28166
Subdivision Name: _____ Section/Phase: _____ Lot Number: _____
Driving Directions: South 21 - Left on Murdock Rd. - Rt on Leona Lane - 3rd Lot on Rt.

Site Development Information: *(check or complete ALL that apply*

(✓) New Single Family Residence Maximum Number of Bedrooms: 3 (✓) Crawl Space Foundation
( ) New Multi-Family Residence Maximum Number of Occupants: 2 ( ) Concrete Slab Foundation
( ) Accessory Building ( ) Swimming Pool ( ) Basement with Plumbing
( ) Bedroom(s) Addition ( ) Other Addition/Structure: _____ ( ) Basement without Plumbing
( ) Repair to failing septic system ___ Tank ___ Drain lines Describe Problem: _____
Non-Residential Site Development: Type of Business: _____
Square Footage of Building: _____ Max. Number of Employees: ____ Max. Number of Seats/Beds/Other: _____

Water Supply: ( ) Replacement Well – Reason: _____
( ) Multi-connection Well Number of Houses: _____ Number of Persons: _____
( ) New Well (✓) Existing Well ( ) Community Well ( ) City Water ( ) Other Public Water

Desired Septic System Type: *(you may rank in order of preference)* Year existing system installed: 11-24-87
( ) No Preference ( ) Alternative (✓) Conventional ( ) Innovative ( ) Modified Conventional ( ) Other: _____

Please answer the following to the best of your ability:
( ) Yes (✓) No Does the site contain any jurisdictional wetlands?
( ) Yes (✓) No Is any non-domestic sewage (i.e. industrial) to be generated?
( ) Yes (✓) No Is the site subject to approval by any other public agency?

I have read this application and certify that the information provided herein is true, complete, and correct. Authorized county and state officials are granted right of entry to conduct necessary inspections to determine compliance with applicable laws and rules. I understand that I am solely responsible for the proper identification and labeling of all property lines and corners and making the site accessible so that a complete site evaluation can be performed.


Signature: Boyce Galliher 6-10-20
Property owner or owner's legal representative signature (SIGNATURE REQUIRED) DATE

IREDELL COUNTY HEALTH DEPARTMENT

ENVIRONMENTAL HEALTH DIVISION

PAGE 2: *SITE PLAN WORKSHEET*

SEE THE "SAMPLE SITE PLAN" BELOW. *INCOMPLETE SITE PLANS WILL BE RETURNED TO YOU FOR COMPLETION AND MAY RESULT IN A DELAY IN THE ISSUANCE OF YOUR SEPTIC SYSTEM PERMIT!!!*

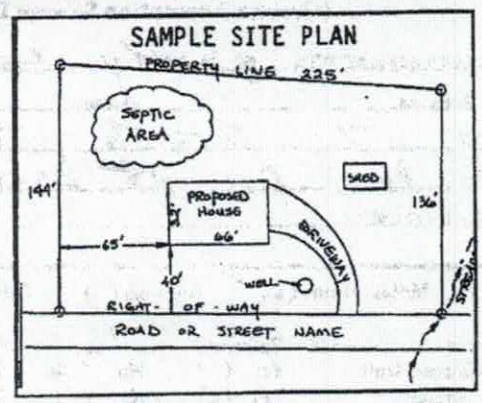

Place an (X) beside each item as you complete the site plan:


- (X) Property Line measurements are clearly identified
- (X) All proposed structures are indicated
- (X) Front and side setbacks from property line
- (X) Preferred driveway location and well location
- (X) Area you prefer your septic system to be placed
- (X) North arrow, or other sufficient indicator of direction

Circle N/A on the following if appropriate:

Location of septic systems and wells within 100' of your property	N/A
Location of easements and rights of ways on your property	N/A
Location of any designated wetlands on the property	N/A

USE THIS SPACE TO DRAW YOUR SITE PLAN

Show: proposed house or business footprint, wells, water lines, patios, pools and decks, and any other item that will occupy space on the site

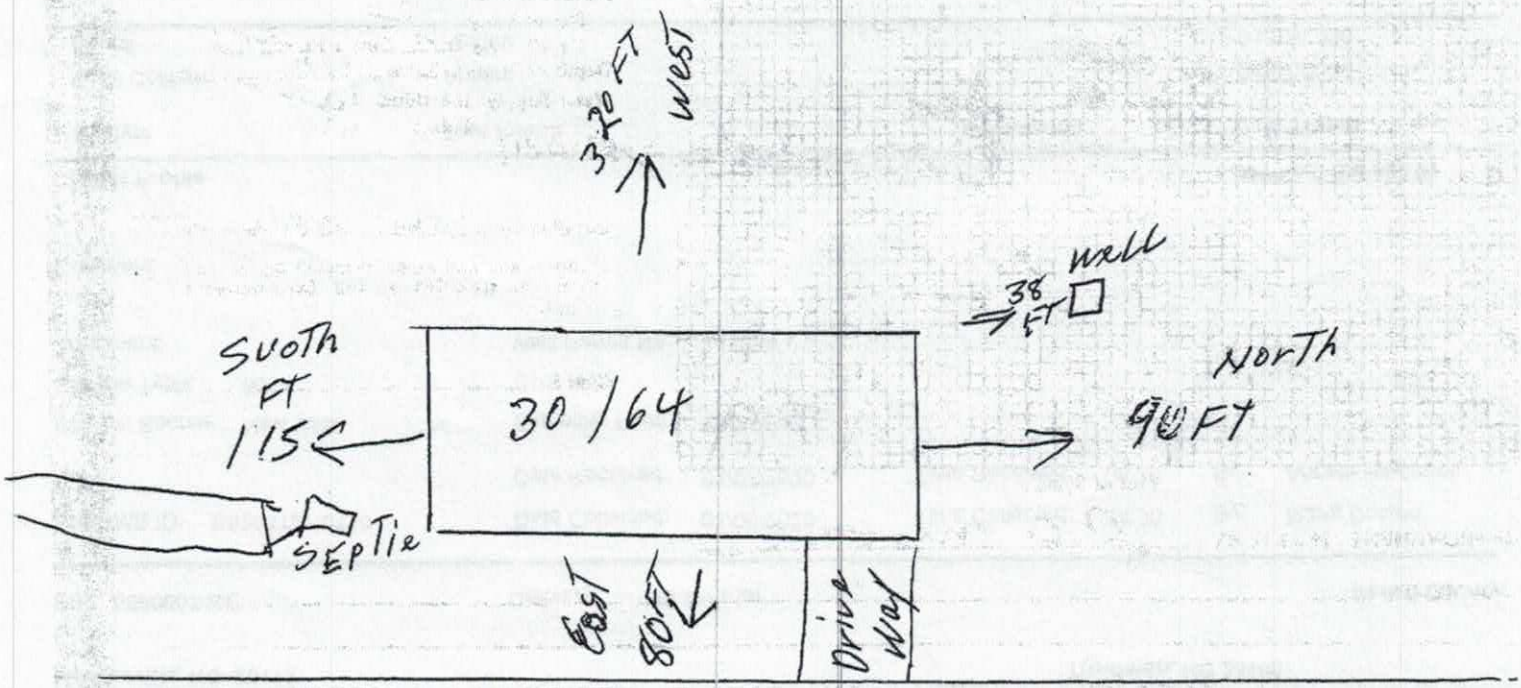

Signature: Bryce Gilliland
Property owner or owner's legal representative signature (SIGNATURE REQUIRED)

6-10-20
DATE

07656

IREDELL COUNTY HEALTH DEPARTMENT

(SEPTIC TANK) IMPROVEMENTS PERMIT AND CERTIFICATE OF COMPLETION
(Ground Absorption Sewage Disposal System – G. S. Chapter 130-Article 13C)

OWNER OR CONTRACTOR Sherry Cash DATE 11-24-87 PERMIT NO. _____

PHONE: Business _____ Home _____

LOCATION 21 South To Troutman TL on murdock Rd 1mi on Rt back off Rd on Private Rd S. R. No. _____

SUBDIVISION NAME _____ LOT NO. _____ SECTION OR BLOCK NO. _____

House ( ) Mobile Home (✓) Business ( ) Other _____


No. Bedrooms 2 No. Bathrooms 2

Garbage Disposal Unit Yes ( ) No (✓)
Auto. Dishwasher Yes (✓) No ( )
Auto. Wash. Machine Yes (✓) No ( )
Site Suitable Yes (✓) No ( )

Character & Porosity of Soil Clayey
Percolation Rate 24
Topography 2 to 6%
Depth to Water Table 10'+
Rock or other impervious formations none

Lot Area 5.31 acre

_____ Basement with Plumbing _____ Basement without Plumbing _____ No Basement

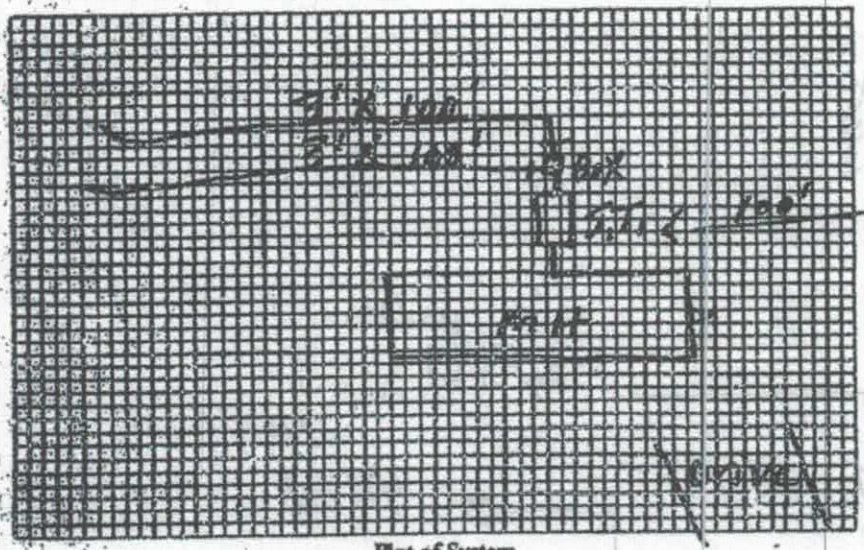

Plot of System

Size of Tank 1000 Gals.

Nitrification Field:
No. of Lines 2
Sq. Ft. 600 Linear Ft. 200
Depth of Stone in Lines 12"

Water Supply: Individual (✓)
Public ( )
Well

Installed by Sam Oswalt

I understand and agree to install septic tank system as specified on this Improvements Permit.

Signed: _____

IMPROVEMENTS PERMIT BY P. C. Moore

COMMENTS: _____

CERTIFICATE OF COMPLETION BY P. C. Moore DATE 11-24-87

EXISTING SYSTEM CHECKED BY: _____ DATE _____

CONSTRUCTION MUST COMPLY WITH ALL OTHER APPLICABLE STATE AND LOCAL REGULATIONS.

Permit is VOID if any unauthorized changes are made in installation of system and/or if any false information is supplied in making Improvements Permit.

Health Dept. Copy: White Inspection Dept. Copy: Yellow Sanitarian's Copy: Pink Owner's Copy: Gold

IREDELL COUNTY DEPARTMENT OF ENVIRONMENTAL HEALTH

DOCUMENTATION TO AUTHORIZE AN OWNER'S LEGAL REPRESENTATIVE

(Check and sign only ONE of the options below)

☐ **1. * APPLICANT AND OWNER ARE THE SAME. *** (*Sign here*) Lisa C Davis

Applications for permits require the "signature of the owner or owner's legal representative" (15A NCAC 18A .1937). If the owner does not sign the application himself or herself, they can submit any one of the following documents to designate their legal representative: *Power of Attorney; Real Estate Contract; Estate executor; Bankruptcy trustee; Court ordered guardianship*
In the absence of the above documentation, the property owner may provide the local health department with documentation that designates a legal representative. A property owner may:
Complete this form to document his or her legal representative, or provide his or her own form that contains the information in this form. If there are multiple property owners, then all property owners must sign the form that designates a legal representative.
By signing a form that designates a legal representative for purposes of 15A NCAC 18A .1937, the property owner authorizes that representative to act on their behalf in matters pertaining to the application and permitting process, including signing or receiving any application, document or permit. The owner retains full responsibility to meet all permit conditions specified by the local health department.

☐ **2.** I, Lisa C. Davis, am the legal owner(s) of the property located at 130 Iron Lane Troutman NC 28166, identified as

PIN (Parcel Identification Number)_____, located in Iredell County, North Carolina.

I do hereby authorize (**print legal representative/company name**) Boyce Mullis, to act as an agent on my behalf in applying for/signing/obtaining any of the documents described below.

- Application for Improvement Permit (IP) / Authorization to Construct (AC)
- Improvement Permit (IP) / Authorization to Construct (AC)
- Application for soil-site evaluation (new/repair)
- Application/permit for private drinking water well/well abandonment
- Application for Compliance Inspection

I agree to abide by all decisions and/or conditions between the legal representative acting on my behalf and the Iredell County Department of Public Health, Environmental Health Division.

Lisa C. Davis — Signature of Owner(s)

6-10-20 — Date

Mooresville - Environmental Health
Fax: 704-662-3239
610 E. Center Avenue, Mooresville, NC 28115

Statesville - Environmental Health
ronda.hart@co.iredell.nc.us
Fax: 704-871-3483
349 N. Center Street, Statesville, NC 28677

Fairgreen


Chateau Collection

FactorySelectHomes

3 Bedrooms, 2 Baths

Approx. 1,941 Sq. Ft.

Last Updated: 1-13-19

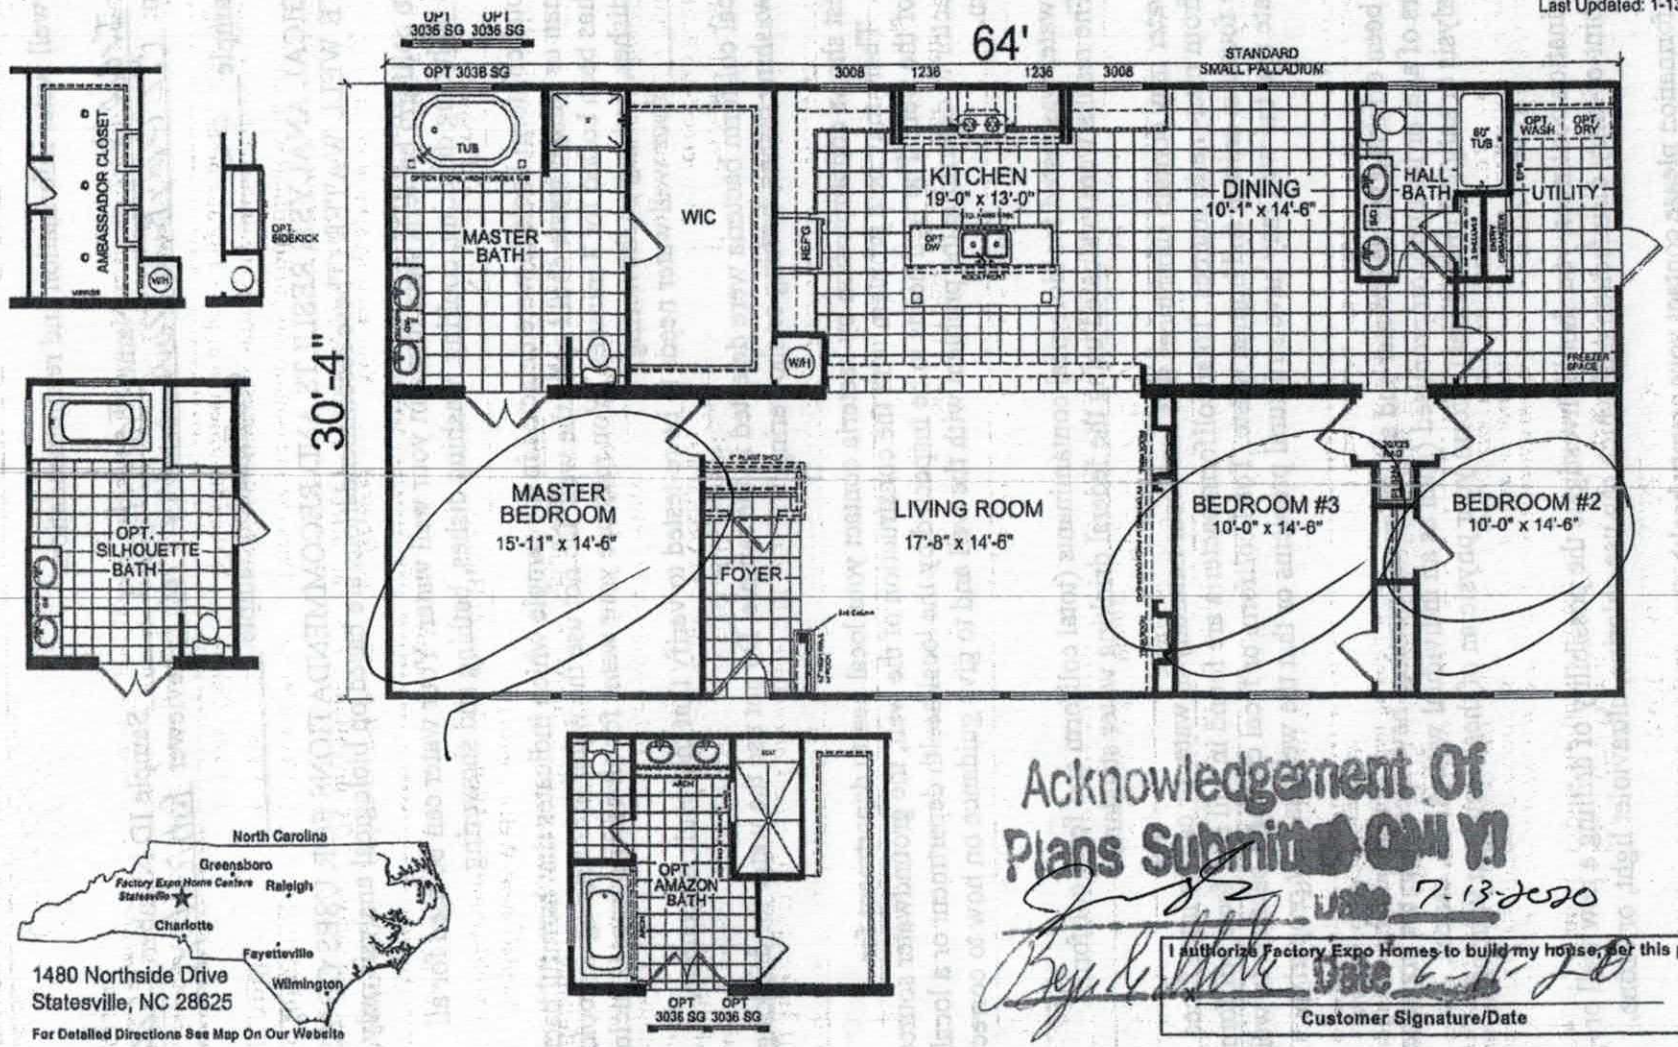

1480 Northside Drive
Statesville, NC 28625

For Detailed Directions See Map On Our Website

Acknowledgement Of Plans Submitted

Date 7-13-2020

I authorize Factory Expo Homes to build my house per this plan.

Date 2-11-20

Customer Signature/Date

1-800-965-6842 www.FactorySelectHomeCenter.com 1-800-965-6842 www.FactorySelectHomeCenter.com

Important: Due to our policy of continuing improvement, all information in our brochures may vary from actual home. The right is reserved to make changes at any time, without notice or obligation, in colors, materials, specifications, processes, and models. All dimensions and square footage calculations are nominal and approximate figures. Please check with your sales person for specific and current information.

Zoning Permit # 308511
Fee $ 45.00 Code 104

See reverse for new construction.

Zoning Permit

LOCATION	Date (mm/dd/yy)	06-22-20	Tax Parcel #	4742318183
	Business Name or Property Owner	Lisa Davis		
	Street Address & Lot Number	130 Leone Lane - Troutman 28166		
	Business Type and/or Project Description	Residental Home		
APPLICANT	Applicant	Boyce Gallihen	Preferred Phone	704-402-2795
	Address City/State/Zip	165 Ashley Acres Rd. Statesville NC 28677		
	E-Mail	boycegallihen@icloud.com		
	Would you like your e-mail address added to: (check any of interest)	☐ The Whistle Stop (Town of Troutman newsletter) ☐ Troutman Business Council (Local Chamber of Commerce) ☐ Sunshine List (Agenda for Town Board Meetings)		

Following approval of this permit proceed to Iredell County Building Inspections (349 N Center St, Statesville, NC 28677). All Applicants, please note that final inspection by the Town is required prior to occupancy. Business Applicants, please note that proof of RPZ (backflow) inspection is required prior to occupancy (in addition, restaurants may be required to have a grease trap inspection).

Office Use Only

Zoning District(s)	RS	TL ☐ ETJ ☑	Plans Attached: Yes ☑ No ☐
Utilities	Well / Septic		Floodplain: Yes ☐ No ☑
Permitted Use of Property	SFR		
Minimum Setback Requirements	Front 35', Rear 25', Left Side 15', Right Side 15' *Setback measured from nearest projecting point of structure to Property Line.*		

Comments: Please see attached Section from the Town of Troutman UDO on manufactured homes, also the attached for landscaping and trees.

I hereby certify that all of the information provided for this application is, to the best of my knowledge, accurate and complete. I understand that this permit will expire and become invalid unless the work for which it was issued is started within six (6) months of the date of issue or is the work authorized is suspended or abandoned for a period of one (1) year.

Boyce Gallihen
Signature of Applicant

To the best of my knowledge, this application is deemed complete and approved based on the information provided to me and my knowledge of the Town of Troutman Unified Development Ordinance.

Signature of Zoning Administrator


















