THIS PERMIT REPLACES PREVIOUS ISSUED 3-17-05

IREDELL COUNTY HEALTH DEPARTMENT

STATESVILLE 704-878-5305 (01) MOORESVILLE 704-664-5281

IMPROVEMENT PERMIT / AUTHORIZATION TO CONSTRUCT / OPERATION PERMIT / EXISTING SYSTEM INSPECTION

PERMIT# 127556 PIN# 4742-32-7462 DATE 4-21-05

OWNER OR CONTRACTOR KATHY JONES PHONE: Business 828-234-9134 Home 704-663-2227

ADDRESS 467 MURDOCK ROAD, TROUTMAN, NC 28166

LOCATION US 21 SOUTH TL MURDOCK ROAD, 1.4 MILES ON LEFT AT BOX #467

SUBDIVISION _____ BLOCK / SECTION _____ LOT _____ LOT AREA LIMITED SITE CLASS. PS DESIGN FLOW 240 L.T.A.R. EXISTING

Septic Tank: 1000 Gallons; STB 825 Date 3-11-05
Pump Tank: _____ Gallons; PT _____ Date _____
Pump Make: _____ Model _____ Serial No. _____
Nitrification Field: No Fields ____ Square Feet _____ Linear Feet EXISTING
No Lines _____ Trench Width _____ Max Trench Bottom Depth _____ Gravel Depth _____

☑ New System ☐ Repair System Type: I, (II), III, IV, V, VI
System Description: CONVENTIONAL, GRAVITY
Repair System Description: _____
Maintenance Agreement Required: ☐ Yes ☑ No


☑ House/Mod. Home No. Bedrooms 2
☐ Mobile Home No. Bathrooms ____
☐ Business No. Employees ____
☐ Other _____
☐ Slab ☐ Crawl Space ☐ Basement w/plumbing ☐ Basement wo/plumbing

Water Supply: ☐ Individual ☑ Public ☐ Community

Comments:/Conditions: REPLACE EXISTING SEPTIC TANK AT LOCATION SHOWN, MINIMUM 5' FROM BLDG. FOUNDATION, P.L. 140.0

Comments:/Conditions: SEPTIC TANK WITH MARKER INSTALLED USING "Poly Lok" FITTER

INITIAL SITE SKETCH

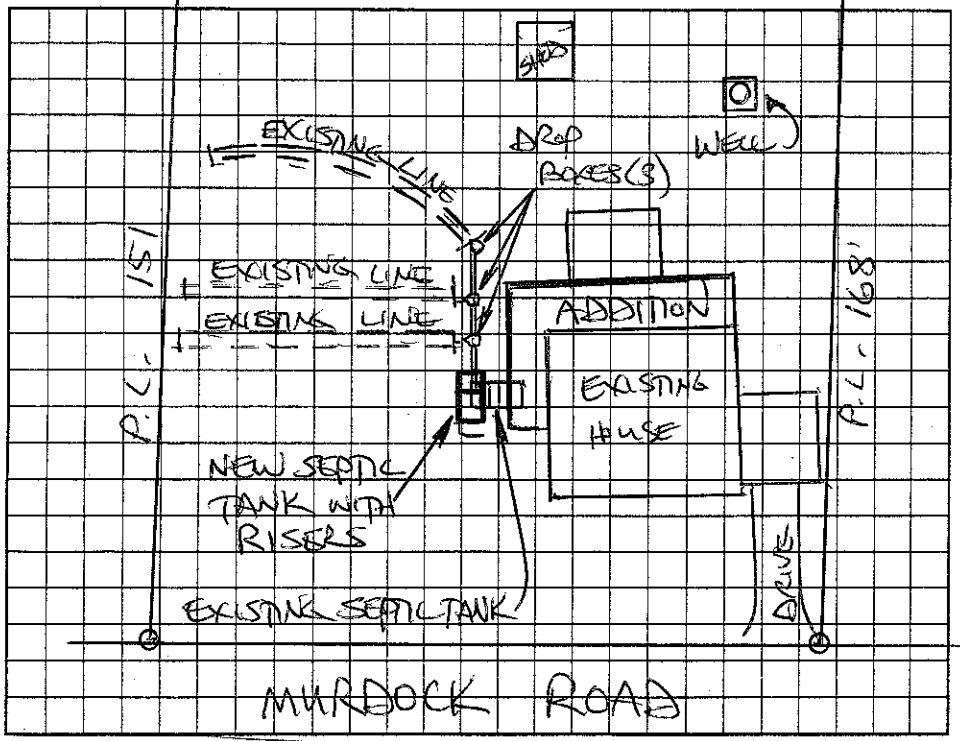

AS BUILT SKETCH

SEPTIC TANK RELOCATED AS SHOWN ON INITIAL SITE SKETCH

Permit can be suspended or revoked if any false information is supplied toward securing the permit/any unauthorized changes are made to the site/any unauthorized changes are made in the installation of the system. Improvement Permit with plat valid without expiration. Improvement Permit with site plan valid for sixty months. Authorization to Construct is valid for a period equal to that of Improvement Permit – not to exceed sixty months.

Signed: Steve Coghill date 4-21-05 Installed by: ROWAN SEPTIC

Improvement Permit by: STEVE HEDRICK date 4-21-05 Operation Permit by: STEVE HEDRICK date 6-10-05

Authorization to Construct by: STEVE HEDRICK date 4-21-05 Existing System Inspection by: _____ date _____

HEALTH DEPT. COPY: WHITE OWNER COPY (FINAL): YELLOW OWNER COPY (INITIAL): PINK