860049 Unit # 860050 Unit 2

IREDELL COUNTY HEALTH DEPARTMENT

STATESVILLE 704-878-5305 MOORESVILLE 704-664-5281

IMPROVEMENT PERMIT / AUTHORIZATION TO CONSTRUCT / OPERATION PERMIT / EXISTING SYSTEM INSPECTION

PERMIT# 02-2-1099 Troutman PIN# 4742 333360 DATE 10-22-99

OWNER OR CONTRACTOR Brent murdock PHONE: Business 528 6969 Home

ADDRESS 368 Old mtn Rd Troutman

LOCATION 215 TL murdock Rd on left after Duckcreek TL JohnCarl Dr. 1st lot L

SUBDIVISION Amanda Leigh BLOCK / SECTION LOT 12 LOT AREA .831 acres SITE CLASS. PS DESIGN FLOW 480 L.T.A.R. .3

Septic Tank: 1500 Gallons; STB 1011 Date 7-9-99
Pump Tank: Gallons; PT Date
Pump Make: Model Serial No.
Nitrification Field: No Fields 5 Square Feet 1600 Linear Feet 534
No Lines 5 Trench Width 36" Max Trench Bottom Depth 36" Gravel Depth 12"

☑ New System ☐ Repair System Type: I, II, III, IV, V, VI
System Description: Conv. Gravity
Repair System Description:
Maintenance Agreement Required: ☐ Yes ☑ No
☐ Slab ☐ Crawl Space ☐ Basement w/plumbing ☐ Basement wo/plumbing


☐ House/Mod. Home No. Bedrooms 4
☐ Mobile Home No. Bathrooms 4
☐ Business No. Employees
☑ Other Duplex

Water Supply: ☑ Individual ☐ Public ☐ Community


Comments:/Conditions:

Comments /Conditions:

INITIAL SITE SKETCH

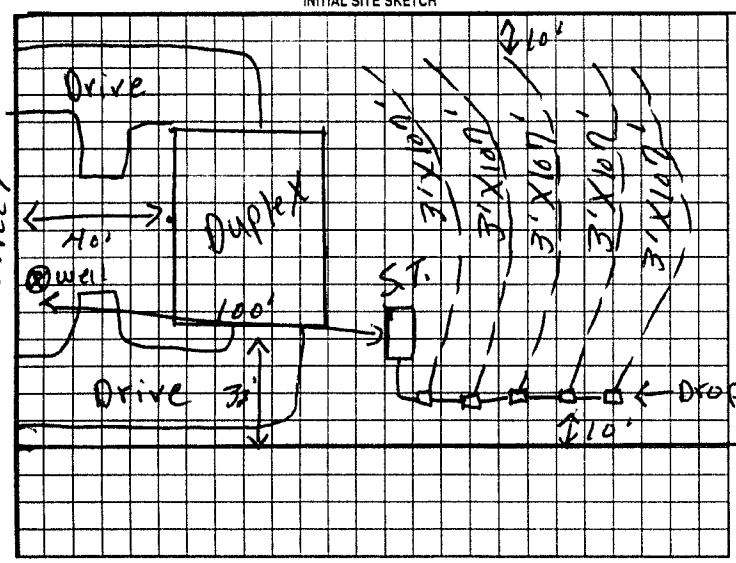

AS BUILT SKETCH

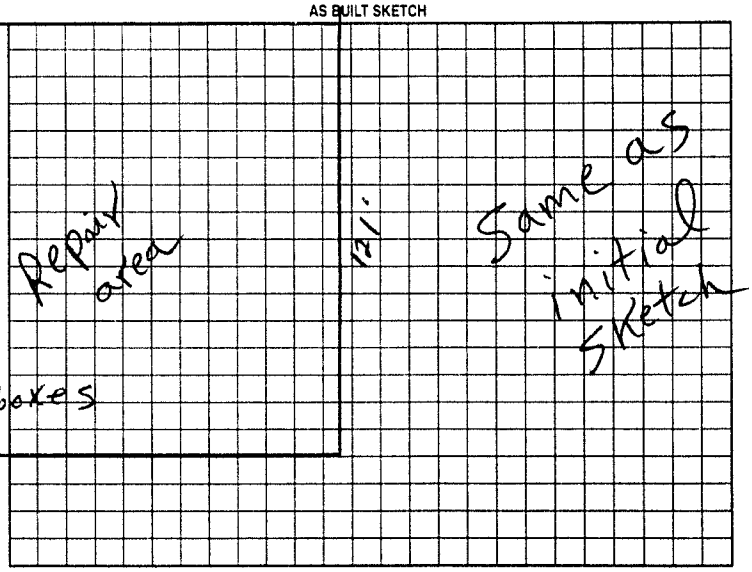

Permit can be suspended or revoked if any false information is supplied toward securing the permit/any unauthorized changes are made to the site/any unauthorized changes are made in the installation of the system. Improvement Permit with plat valid without expiration. Improvement Permit with site plan valid for sixty months. Authorization to Construct is valid for a period equal to that of Improvement Permit – not to exceed sixty months.

Signed: [signature] date 10/26/99 Installed by: Steve Jordan

Improvement Permit by: P. C. moore date 10-22-99 Operation Permit by: P. C. moore date 2-23-00

Authorization to Construct by: P. C. moore date 10-22-99 Existing System Inspection by: date

HEALTH DEPT. COPY: WHITE OWNER COPY (FINAL) YELLOW OWNER COPY (INITIAL): PINK