87545 + 87546

1:00 - 1:30

IREDELL COUNTY HEALTH DEPARTMENT

STATESVILLE 704-878-5305 MOORESVILLE 704-664-5281

IMPROVEMENT PERMIT / AUTHORIZATION TO CONSTRUCT / OPERATION PERMIT / EXISTING SYSTEM INSPECTION

PERMIT# 02-2-1299 PIN# 4742-33-3360 DATE 1-07-00

OWNER OR CONTRACTOR Brent murdock PHONE: Business 528 6969 Home

ADDRESS 368 OMR Statesville, N.C.

LOCATION I-77 S TR Amity Hill TL murdock TR John Carl on left at end

SUBDIVISION Amanda Leigh Est. BLOCK / SECTION LOT 11 LOT AREA 33976 SITE CLASS PS DESIGN FLOW 480 L.T.A.R. .13

Septic Tank: 1500 Gallons; STB 1011 Date 2/3/10

Pump Tank: Gallons; PT Date

Pump Make: Model Serial No

Nitrification Field: No Fields 1 Square Feet 1600 Linear Feet 548

No Lines 5 Trench Width 36" Max Trench Bottom Depth 36" Gravel Depth 12"

☑ New System ☐ Repair System Type: I (II) III IV V VI

System Description: Conv. Gravity

Repair System Description: Gravity 752 Redo

Maintenance Agreement Required: ☐ Yes ☑ No

☐ House/Mod. Home No. Bedrooms 4

☐ Mobile Home No. Bathrooms 4

☐ Business No. Employees

☑ Other 4BR Duplex


☐ Slab ☑ Crawl Space ☐ Basement w/plumbing ☐ Basement wo/plumbing

Water Supply: ☑ Individual ☐ Public ☐ Community


Comments/Conditions:

Comments/Conditions.

INITIAL SITE SKETCH

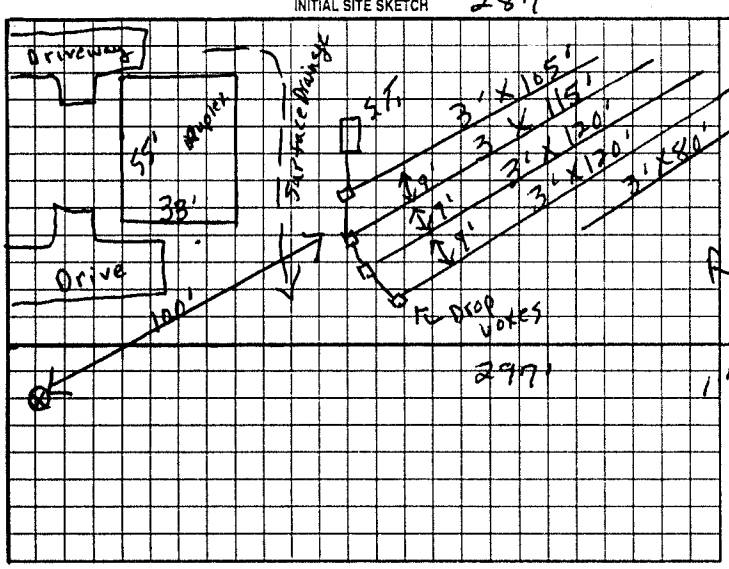

AS BUILT SKETCH

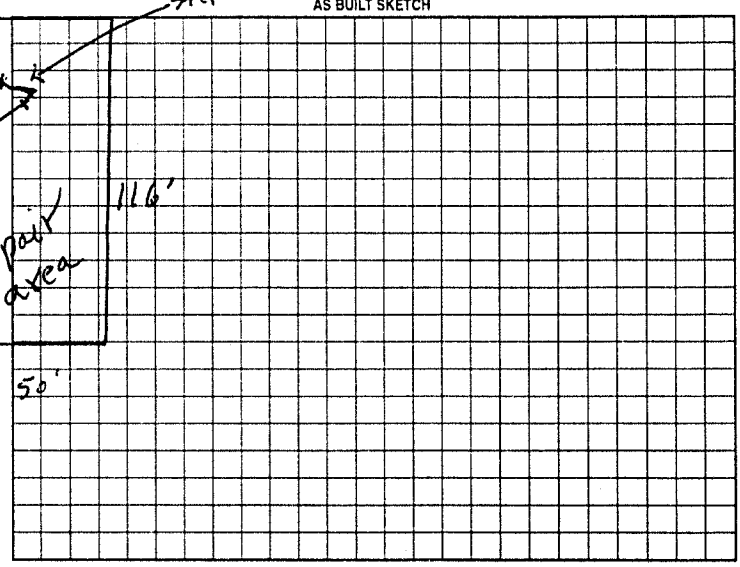

Permit can be suspended or revoked if any false information is supplied toward securing the permit/any unauthorized changes are made to the site/any unauthorized changes are made in the installation of the system. Improvement Permit with plat valid without expiration/ Improvement Permit with site plan valid for sixty months. Authorization to Construct is valid for a period equal to that of Improvement Permit – not to exceed sixty months.

Signed: X Shelton B Murdock date Installed by: STEVE JORDAN

Improvement Permit by: R. C. Moore date 1-07-00 Operation Permit by: C. Petty date 5/12/00

Authorization to Construct by: R. C. Moore date 1-07-00 Existing System Inspection by: date

HEALTH DEPT COPY WHITE OWNER COPY (FINAL) YELLOW OWNER COPY (INITIAL) PINK