IREDELL COUNTY HEALTH DEPARTMENT

STATESVILLE 704-878-5305 MOORESVILLE 704-664-5281

IMPROVEMENT PERMIT / AUTHORIZATION TO CONSTRUCT / OPERATION PERMIT / EXISTING SYSTEM INSPECTION

PERMIT# 01-2-1099 (8083) PIN# 4742 33 3360 DATE 10-22-99

OWNER OR CONTRACTOR Brent Murdock PHONE: Business 528 6969 Home

ADDRESS 368 Old Mtn Rd Trautman

LOCATION 215 Thurmurdock Rd TL on John Carl Rd 3rd lot Rt.

SUBDIVISION Amanda Heights Est. BLOCK / SECTION LOT 7 LOT AREA .812 acres SITE CLASS PS DESIGN FLOW 480 L.T.A.R. .3

Septic Tank: 1000 Gallons; STB 1012 Date 11-3-99
Pump Tank: 1000 Gallons; PT 17 Date 11-21-99
Pump Make: Hydromatic Model SIEF 50 Serial No.
Nitrification Field: No Fields 1 Square Feet 1200 Linear Feet 400
No Lines 5 Trench Width 36" Max Trench Bottom Depth 36" Gravel Depth N/A

☐ New System ☐ Repair System Type: I, II, III, IV, V, VI
System Description: Pump To 25% Reduction Innovative
Repair System Description: " "
Maintenance Agreement Required: ☐ Yes ☑ No

☐ House/Mod. Home No. Bedrooms 4
☐ Mobile Home No. Bathrooms 4
☐ Business No. Employees
☐ Other Duplex

☐ Slab ☐ Crawl Space ☐ Basement w/plumbing ☐ Basement wo/plumbing


Water Supply: ☑ Individual ☐ Public ☐ Community

Comments/Conditions: See Attached Sheets for Pump Tank, Pressure manifold, + clean out set ups They are 299'


Comments/Conditions: Inspected Drain Lines. Draw Down Test on Pump + set Valve at Pressure Manifold 2-24-00 JCM

Final wiring Alarm 3-1-00 JCM

INITIAL SITE SKETCH

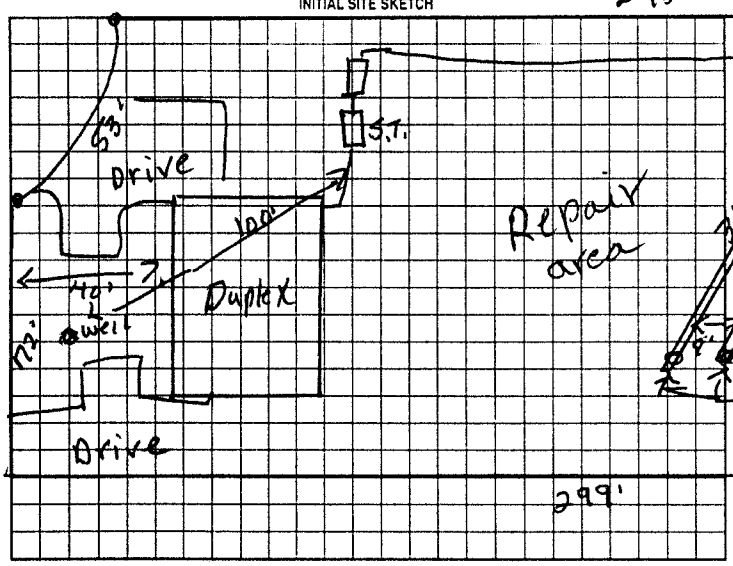

AS BUILT SKETCH

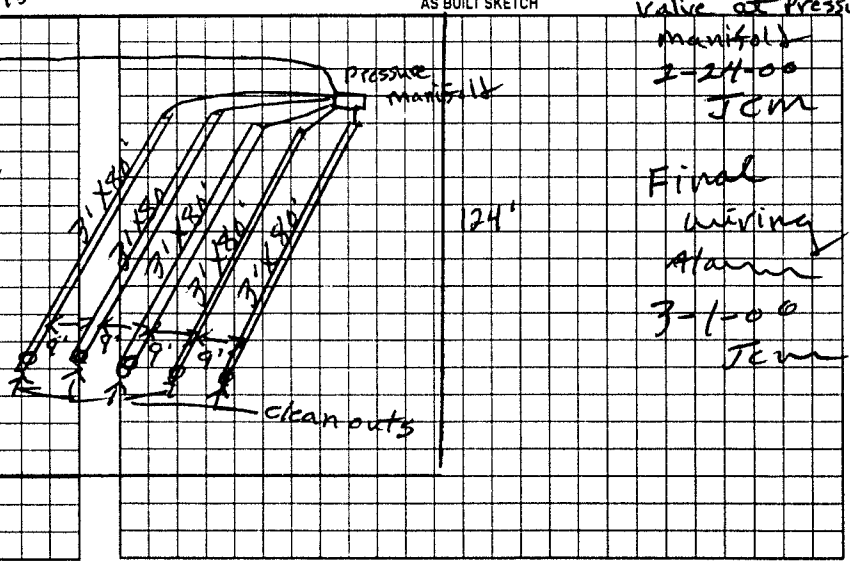

Permit can be suspended or revoked if any false information is supplied toward securing the permit/any unauthorized changes are made to the site/any unauthorized changes are made in the installation of the system. Improvement Permit with plat valid without expiration. Improvement Permit with site plan valid for sixty months. Authorization to Construct is valid for a period equal to that of Improvement Permit – not to exceed sixty months.

Signed: Melvin B. Murdock date 10/26/99 Installed by: Steve Fortune

Improvement Permit by: J. C. Moore date 10-22-99 Operation Permit by: J. C. Moore date 3-1-00

Authorization to Construct by: J. C. Moore date 10-22-99 Existing System Inspection by: date

HEALTH DEPT. COPY: WHITE OWNER COPY (FINAL): YELLOW OWNER COPY (INITIAL): PINK