94889/94891

IREDELL COUNTY HEALTH DEPARTMENT

STATESVILLE 704-878-5305 MOORESVILLE 704-664-5281

IMPROVEMENT PERMIT / AUTHORIZATION TO CONSTRUCT / OPERATION PERMIT / EXISTING SYSTEM INSPECTION

PERMIT# 03-2-020 PIN# 4742 33 3360 DATE 2/23/01

OWNER OR CONTRACTOR SHELDON B. MURDOCK PHONE: Business (704) 528-6969 Home

ADDRESS 368 OLD MTN. RD. STATESVILLE, NC 28677

LOCATION I-77S TO EXIT 45 (R) AMITY HILL RD. (L) MURDOCK RD. (2) AMANDA LEIGH EST. TO END ON (R)

SUBDIVISION AMANDA LEIGH EST. BLOCK / SECTION LOT 8 LOT AREA .945 Ac. SITE CLASS PS DESIGN FLOW 420 GPD L.T.A.R. .30

Septic Tank: 1500 Gallons; STB 1011 Date 11-24-01
Pump Tank: Gallons; PT Date
Pump Make: Model Serial No.
Nitrification Field: No Fields 1 Square Feet 1600 Linear Feet 533'
No Lines 5 Trench Width 3' Max Trench Bottom Depth 30" Gravel Depth 12"

☑ New System ☐ Repair System Type: I (II) III IV V VI
System Description: CONVENTIONAL
Repair System Description: SAME
Maintenance Agreement Required: ☐ Yes ☑ No
☑ Slab ☐ Crawl Space ☐ Basement w/plumbing ☐ Basement wo/plumbing


☑ House/Mod. Home No. Bedrooms 2/2
☐ Mobile Home No. Bathrooms 2/2
☐ Business No. Employees
☐ Other

Water Supply: ☐ Individual ☐ Public ☑ Community

Comments/Conditions: (1) NO CUTTING OR FILLING OVER DRAINFIELD/REPAIR AREA (2) KEEP ALL DRAINS AWAY FROM DRAINFIELD/REPAIR AREA (3) MAINTAIN SETBACKS (4) INSTALL DRAINLINES UNIFORM AND ON CONTOUR.

Comments/Conditions: INSTALLED AS SHOWN WITH POLYLOK FILTER & MARKER

INITIAL SITE SKETCH

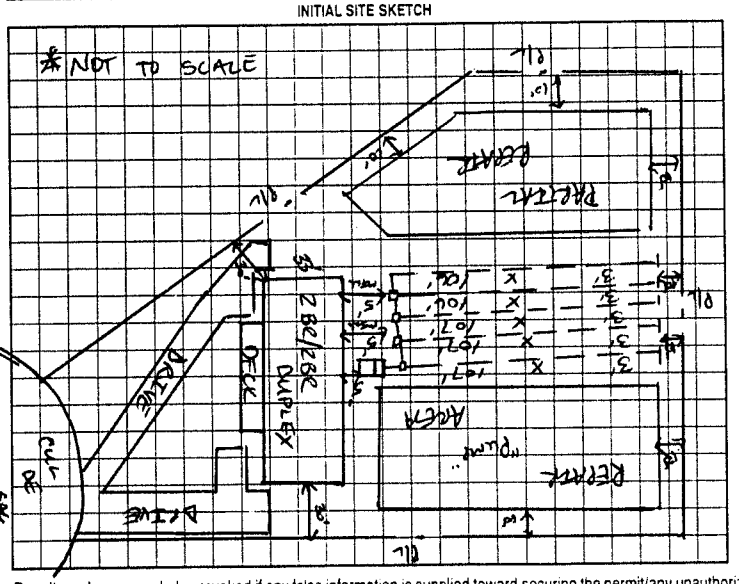

AS BUILT SKETCH

Permit can be suspended or revoked if any false information is supplied toward securing the permit/any unauthorized changes are made to the site/any unauthorized changes are made in the installation of the system. Improvement Permit with plat valid without expiration. Improvement Permit with site plan valid for sixty months. Authorization to Construct is valid for a period equal to that of Improvement Permit – not to exceed sixty months.

Signed: Sheldon B. Murdock date

Improvement Permit by: Tracy Shinn date 2/23/01

Authorization to Construct by: Tracy Shinn date 2/23/01

Installed by: STEVE JORDAN

Operation Permit by: [illegible] date 6-12-01

Existing System Inspection by: date

HEALTH DEPT COPY WHITE OWNER COPY (FINAL) YELLOW OWNER COPY (INITIAL) PINK