358

IREDELL COUNTY HEALTH DEPARTMENT

Statesville Phone TR 3-7271 Mooresville Phone NO 3-1271

PERMIT TO INSTALL SEPTIC TANK

Permit NO. Smith & Munday Elders. Permit Date July 13 1968

Owner Dick Mize Address R7

Installed By C Hoke Address R7

Location of Property on dirt before Duck creek gun Club.


Tank		Capacity		Length of Lines		Fixtures	
Block	( )	1000	( )	225'	( )	No. of Baths	(2)
Precast	(✓)	1250	( )	250'	( )	Dishwasher	( )
Lock		1500	( )	Other 260'		Garbage Grdr.	( )
		Other				Other 2 stools	

NOTIFY HEALTH DEPARTMENT AT LEAST EIGHT HOURS BEFORE TANK IS TO BE INSPECTED.

Final Inspection 19 Approved ( ) Disapproved ( )

Remarks Builder stated no garbage grdr. - wooded very steep ext. not too good a lay out

Layout checked over by Mr. Johnson. HD.

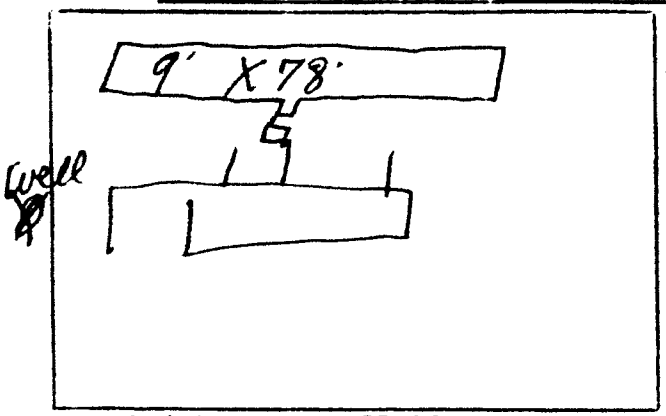

Sketch of Installation

Sanitarian