IREDELL COUNTY HEALTH DEPARTMENT - *ENVIRONMENTAL HEALTH* ☒ STATESVILLE OFFICE 704-878-5305 ☐ MOORESVILLE OFFICE 704-664-5281

IMPROVEMENT PERMIT / AUTHORIZATION TO CONSTRUCT / OPERATION PERMIT / EXISTING SYSTEM INSPECTION

PERMIT # 167771 PIN # 4742382140 DATE 7-26-11

OWNER Randy Bass APPLICANT: PHONE: Home/Cell # 704 902 1014 Business # 704 872-1323

SITE ADDRESS 1416 Duck Creek OWNER / APPLICANT ADDRESS

SITE DIRECTIONS Hwy 215, left Moose Club Rd, (R) Duck Creek, property on right

SUBDIVISION n/a BLOCK / SECTION n/a LOT # n/a LOT AREA 1.77 Acres DESIGN FLOW 360 L.T.A.R. Ex.

Septic Tank Ex Gallons: STB Ex. Date Ex.
Pump Tank Gallons: P T Date
Pump Make Model Serial #
No. Nitrification Fields: 1 No. Lines Ex Linear Feet Ex.
Trench Width Ex. Max. Trench Bottom Depth Ex. Gravel Depth Ex.


☐ New System ☐ Repair ☐ Expansion System Type I (II) III IV V VI
System Description: Existing
Repair System Description:
Maintenance Agreement Required ☐ YES ☒ NO
☒ GRAVITY ☐ PRESSURE

☒ Residence No. Bedrooms 3
☐ Business No. Persons
☐ Other No. Employees
☐ Slab ☐ Crawl Space
☒ Basement w/plumbing ☐ Basement w/o plumbing


Water Supply: ☒ Private ☐ Public ☐ Community

Comments / Conditions

INITIAL SITE SKETCH

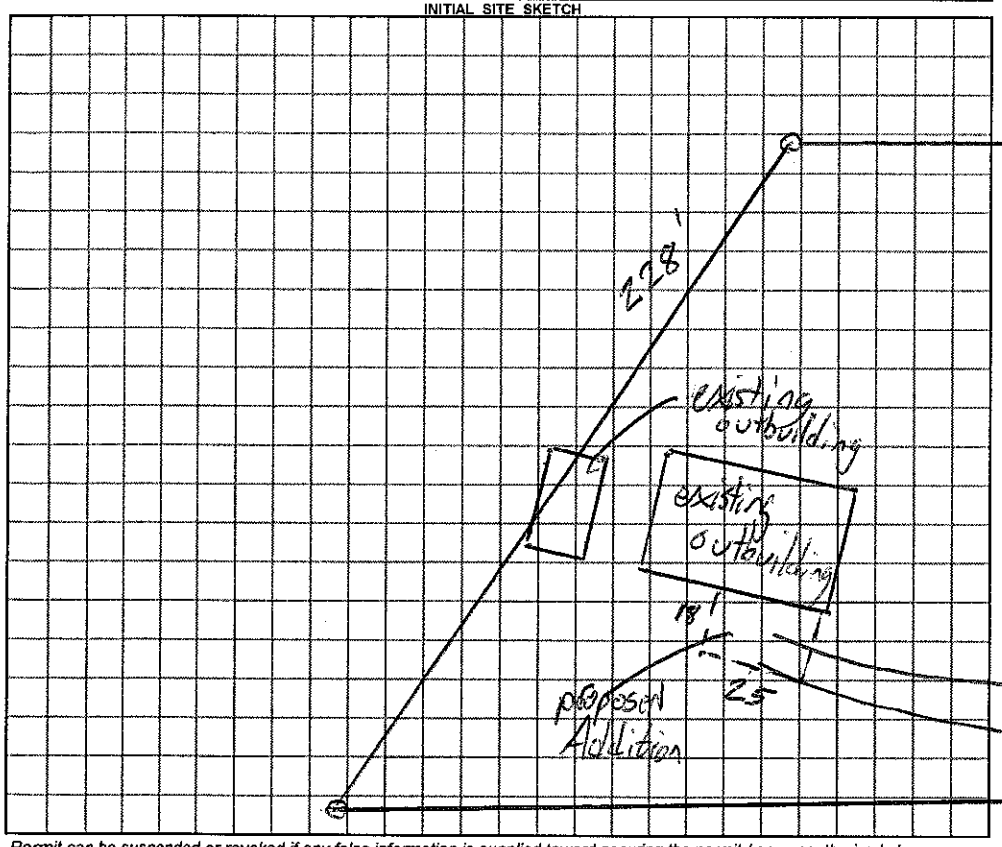

AS BUILT SKETCH

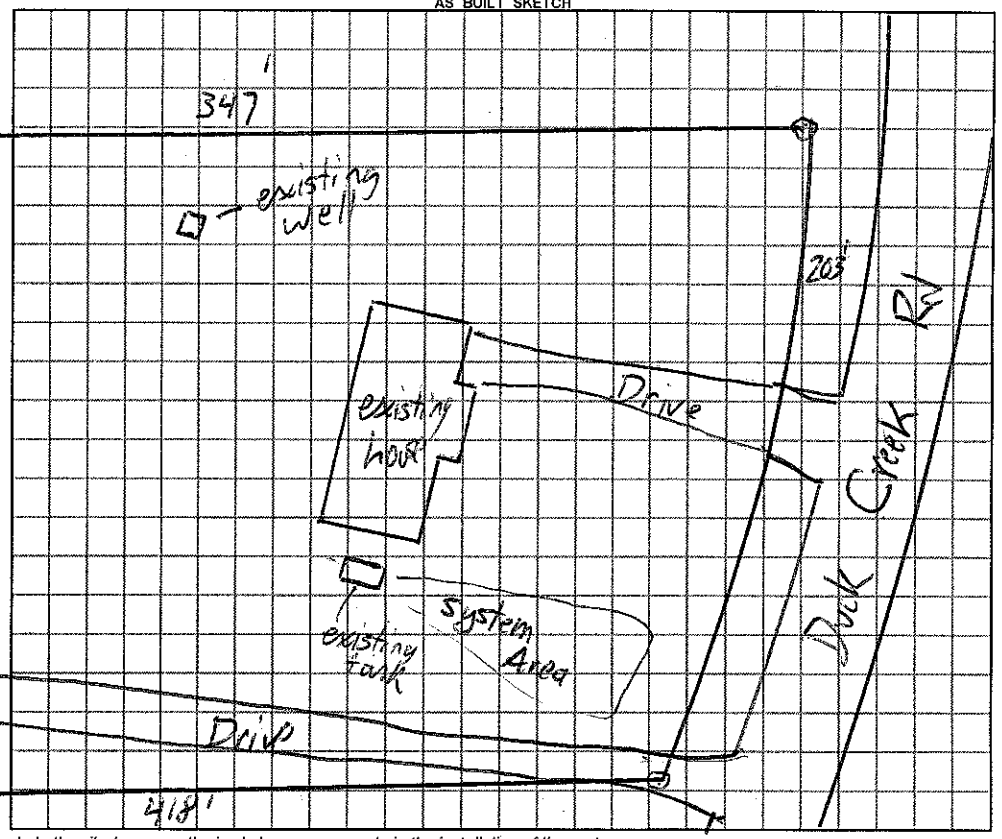

Permit can be suspended or revoked if any false information is supplied toward securing the permit / any unauthorized changes are made to the site / any unauthorized changes are made in the installation of the system.

☐ ***IMPROVEMENT PERMIT*** with plat valid without expiration. ☐ ***IMPROVEMENT PERMIT*** with ~~plat valid without expiration.~~ site plan valid 60 mo. ☐ ***AUTHORIZATION TO CONSTRUCT*** valid for period equal to IMPROVEMENT PERMIT--not to exceed 60 mo.

Owner / Applicant Signature: Randy Bass Date 7-26-11 Installed by:

IMPROVEMENT PERMIT by: REHS Date OPERATION PERMIT by: REHS Date

AUTHORIZATION TO CONSTRUCT by: REHS Date Existing System Inspected by: REHS Date 7-26-11

YOU SHOULD CONTACT A LOCATOR SERVICE PRIOR TO ANY EXCAVATION

White Copy – Environmental Health YELLOW COPY (Final) Owner / Applicant PINK COPY (Initial) Owner / Applicant