IREDELL COUNTY HEALTH DEPARTMENT - *ENVIRONMENTAL HEALTH* ☐ STATESVILLE OFFICE 704-878-5305 ☐ MOORESVILLE OFFICE 704-664-5281

IMPROVEMENT PERMIT / AUTHORIZATION TO CONSTRUCT / OPERATION PERMIT / EXISTING SYSTEM INSPECTION

PERMIT # Repair PIN # 4742-38-6272 DATE 3 October 2011

OWNER Shirley Price APPLICANT: Steve Kramm PHONE: Home/Cell # (704) 402-8478 Business #

SITE ADDRESS 145 Duck Creek Rd. OWNER / APPLICANT ADDRESS

SITE DIRECTIONS Moose Club Rd. Turn onto Duck Creek Rd. on left.

SUBDIVISION BLOCK / SECTION LOT # LOT AREA 1.83 ac. DESIGN FLOW 480 gpd L.T.A.R. exist.

New

Septic Tank 1000g Gallons: STB Date

Pump Tank Gallons: P T Date

Pump Make Model Serial #

No. Nitrification Fields: exist No. Lines exist Linear Feet exist

Trench Width exist. Max. Trench Bottom Depth exist. Gravel Depth

☐ New System ☑ Repair ☐ Expansion System Type I (II) III IV V VI

System Description: Existing Conv. Trench

Repair System Description: Replace Septic Tank

Maintenance Agreement Required ☐ YES ☑ NO

☑ GRAVITY ☐ PRESSURE

☑ Residence No. Bedrooms 4

☐ Business No. Persons

☐ Other No. Employees

☐ Slab ☐ Crawl Space

☐ Basement w/plumbing ☑ Basement w/o plumbing


Water Supply: ☑ Private ☐ Public ☐ Community

Comments / Conditions


1. Replace existing ST with New 1000g ST. Properly abandon old ST.
2. Septic Tank must have risers.

1. old septic system permit attached.

INITIAL SITE SKETCH

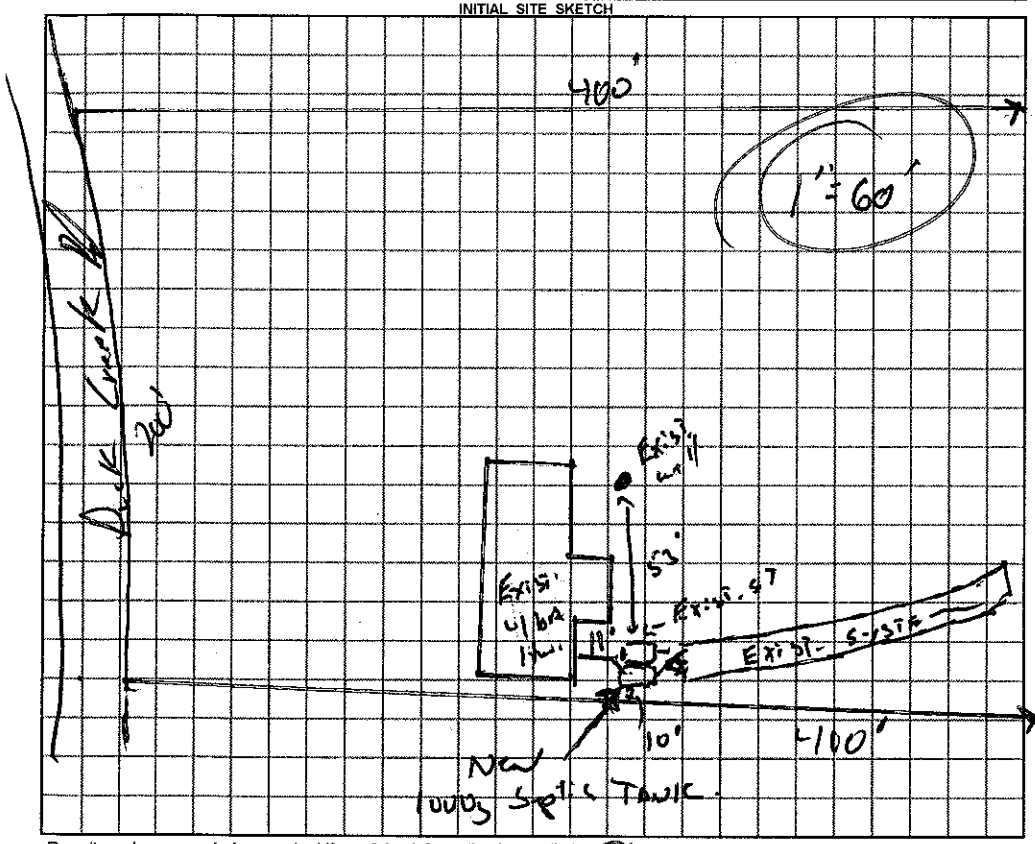

AS BUILT SKETCH

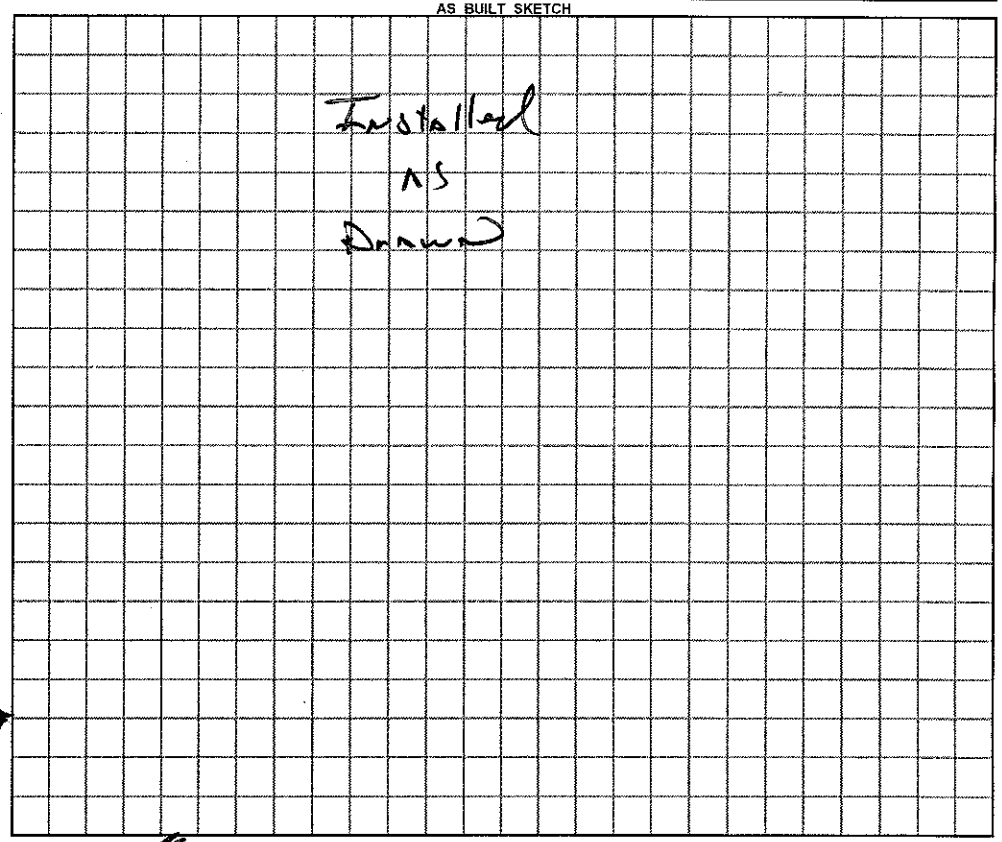

Permit can be suspended or revoked if any false information is supplied to ~~or~~ securing the permit / any unauthorized changes are made to the site / any unauthorized changes are made in the installation of the system.

☐ ***IMPROVEMENT PERMIT*** with plat valid without expiration. ☑ ***IMPROVEMENT PERMIT*** with plat ~~valid without expiration~~ site plan valid 60 mo. ☑ ***AUTHORIZATION TO CONSTRUCT*** valid for period equal to IMPROVEMENT PERMIT--not to exceed 60 mo.

Owner / Applicant Signature: Date 10-3-11 Installed by: Wes Lifton

IMPROVEMENT PERMIT by: REHS Date

OPERATION PERMIT by: REHS Date 5 Oct. 11

AUTHORIZATION TO CONSTRUCT by: REHS Date 3 Oct. 11

Existing System Inspected by: REHS Date

YOU SHOULD CONTACT A LOCATOR SERVICE PRIOR TO ANY EXCAVATION

White Copy – Environmental Health YELLOW COPY (Final) Owner / Applicant PINK COPY (Initial) Owner / Applicant