IREDELL COUNTY HEALTH DEPARTMENT

STATESVILLE 704-878-5305 MOORESVILLE 704-664-5281

IMPROVEMENT PERMIT / AUTHORIZATION TO CONSTRUCT / OPERATION PERMIT / EXISTING SYSTEM INSPECTION

PERMIT# 100158 PIN# 4742 48 3031 (PART) DATE 5-16-01

OWNER OR CONTRACTOR DAVID MEEHAN PHONE: Business (704) 902-0286 Home

ADDRESS 105 GALAX DRIVE, STATESVILLE, NC 28677

LOCATION US 21 S, TL MOOSE CLUB RD, TR DUCK CREEK RD, TL WINTERGREEN CIR, BEAR RIGHT, LOT ON (R) IN CURVE

SUBDIVISION BLOCK / SECTION LOT 6 LOT AREA 0.574 ACRE SITE CLASS PS DESIGN FLOW 360 L.T.A.R. 0.30 GPD/FT²

Septic Tank: 1000 Gallons; STB 1007 Date 5-2-01
Pump Tank: Gallons; PT Date
Pump Make: Model Serial No
Nitrification Field: No Fields 1 Square Feet EQ TO 1200 Linear Feet 200
No Lines FOUR Trench Width 24" Max Trench Bottom Depth 36"

☑ New System ☐ Repair System Type: I, II, (III), IV, V, VI
System Description: 50% REDUCTION, GRAVITY
Repair System Description: 50% REDUCT, LOW-PRESS
Maintenance Agreement Required: ☐ Yes ☑ No
Gravel Depth 3 AND 6" ☐ Slab ☐ Crawl Space ☐ Basement w/plumbing ☐ Basement wo/plumbing


☐ House/Mod. Home No. Bedrooms 3
☐ Mobile Home No. Bathrooms 2
☐ Business No. Employees
☐ Other

Water Supply: ☑ Individual ☐ Public ☐ Community
WELL


Comments/Conditions: ① INSTALL 50% REDUCTION SYSTEM USING 44 PPBPS PANELS IN 4 EQUAL LENGTH LINES ② INSTALL SUBSURFACE INTERCEPT DRAINAGE DITCH AS SHOWN BEGINNING 48 INCHES DEEP OUT TO DAYLIGHT ③ KEEP SYSTEM MINIMUM 100 FEET FROM WELL.

Comments/Conditions:
- Poly Tank Filter Installed
- Septic Tank Risers Installed

INITIAL SITE SKETCH

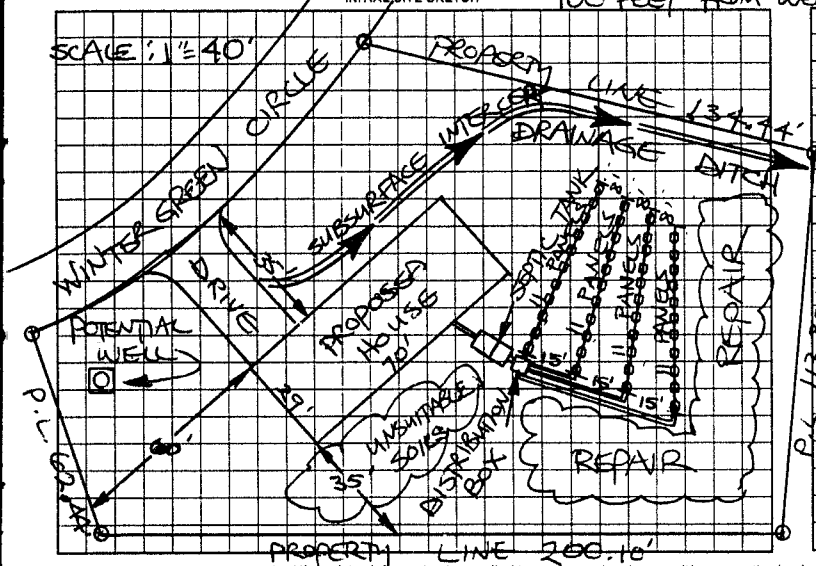

AS BUILT SKETCH

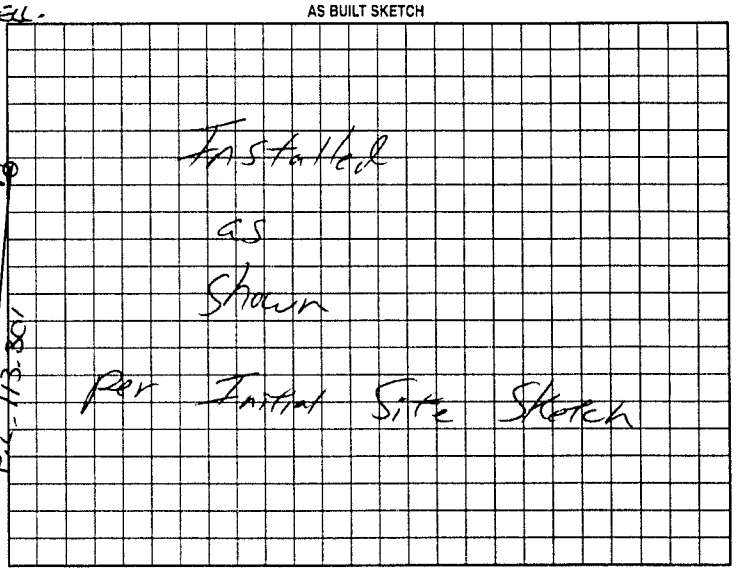

Permit can be suspended or revoked if any false information is supplied toward securing the permit/any unauthorized changes are made to the site/any unauthorized changes are made in the installation of the system. Improvement Permit with plat valid without expiration. Improvement Permit with site plan valid for sixty months. Authorization to Construct is valid for a period equal to that of Improvement Permit – not to exceed sixty months.

Signed: David Meehan date 5-18-01 Installed by: James Hudler

Improvement Permit by: STEVE HEARICK date 5-17-01 Operation Permit by: William G Johnson date 8/15/01

Authorization to Construct by: STEVE HEARICK date 5-17-01 Existing System Inspection by: date

HEALTH DEPT. COPY: WHITE OWNER COPY (FINAL): YELLOW OWNER COPY (INITIAL): PINK