59638

IREDELL COUNTY HEALTH DEPARTMENT

STATESVILLE 704-878-5305 MOORESVILLE 704-664-5281

IMPROVEMENT PERMIT / CERTIFICATE OF COMPLETION / OPERATION PERMIT / EXISTING SYSTEM INSPECTION

PROPERTY DESCRIPTION NO. Troutman DATE 1-22-96 TAX MAP NO 4N A7 Watershed: ☐ Yes ☐ No

OWNER OR CONTRACTOR Steve Cash PHONE: Business Home 878 0033

ADDRESS 360 murdock Rd Troutman N.C.

LOCATION I-77 S TR Amity Hill Rd TL murdock Then TL Leona Dr at end

SUBDIVISION BLOCK / SECTION LOT LOT AREA 44 acres SITE CLASS RJ DESIGN FLOW 240 LTAR .28

Septic Tank: 1000 Gallons: STB 794 Date 3-12-97

Pump Tank: Gallons: PT Date

Pump Make: Model Serial No

Nitrification Field: No Fields 1 Square Feet 900 Linear Feet 300

No Lines 3 Trench Width 36" Max Trench Bottom Depth 36" Gravel Depth 11"

☐ New System ☐ Repair System Type: I II III IV V VI

System Description: Conv. Gravity

Repair System Description: " "

Maintenance Agreement Required: Yes No

☐ House/Mod Home No Bedrooms 3

☐ Mobile Home No Bathrooms 2½

☐ Business No Employees

☐ Other

☐ Slab ☐ Crawl Space ☐ Basement w/plumbing ☐ Basement wo/plumbing


Water Supply: ☐ Individual ☐ Community ☐ Public

well next dock


Comments:

Comments

INITIAL SITE SKETCH

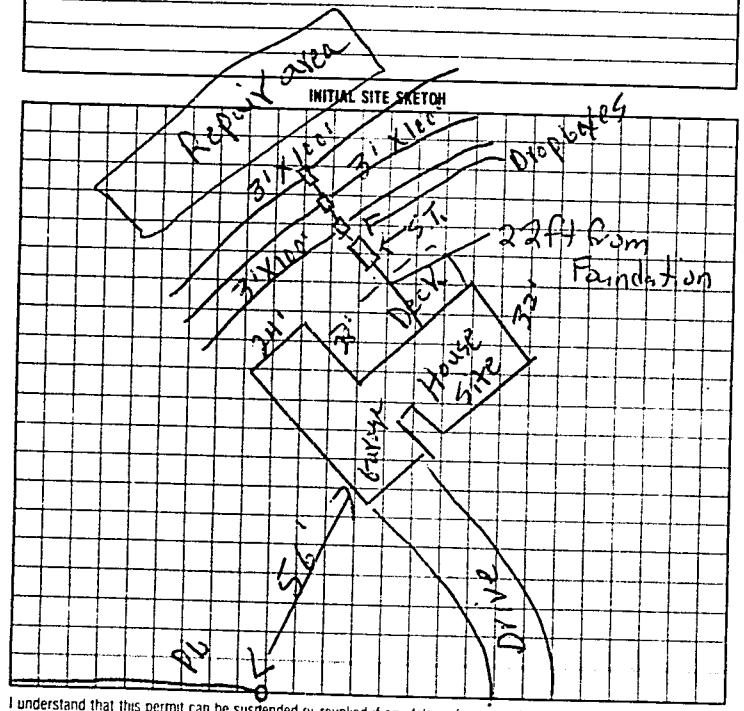

AS BUILT SKETCH

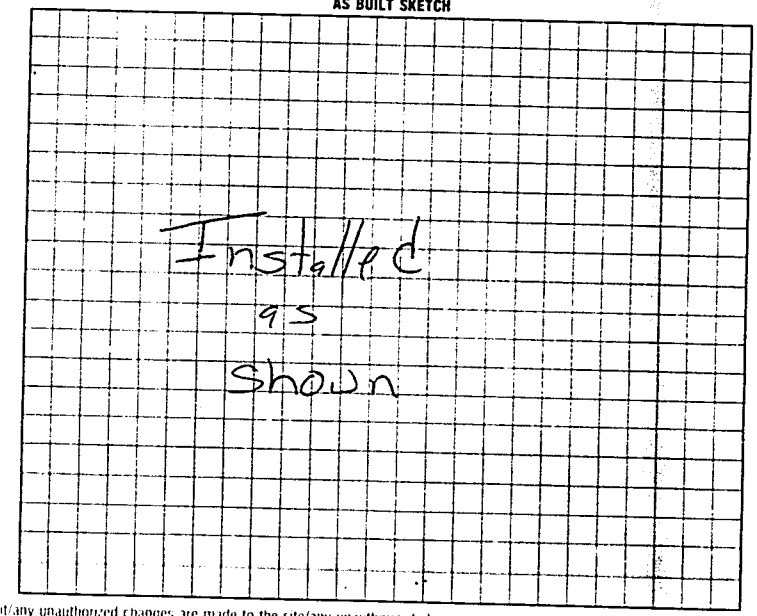

I understand that this permit can be suspended or revoked if any false information is supplied toward securing the permit/any unauthorized changes are made to the site/any unauthorized changes are made in the installation of the system

Signed D. MacPope

Improvement Permit by Auther Zeigler Existing System inspection by E.C. Moore date 1-22-96

to construction dept copy with E.C. Moore date 1-22-96

Installed by Wes Lytton

Certificate of Completion by date

Operation Permit by Mark C Oaks RS date 5-30-97

authorization to const. Expires 60 mos from issue

INSPECTION COPY (FINAL) GREEN OWNER COPY (FINAL) YELLOW INSPECTION COPY (INITIAL) PINK OWNER COPY (INITIAL) GOLD