See attached Permit # 163122 for pool added on site 8-25-10.

IREDELL COUNTY HEALTH DEPARTMENT

STATESVILLE 704-878-5305 (e1) MOORESVILLE 704-664-5281

IMPROVEMENT PERMIT / AUTHORIZATION TO CONSTRUCT / OPERATION PERMIT / EXISTING SYSTEM INSPECTION

PERMIT# Trad/MW 150468 PIN# 4742-42-3277 DATE 1-11-08

OWNER OR APPLICANT BARRY & ANITA GENERAL PHONE: Business 717-606-7507 Home 717-733-2116

ADDRESS 21-A BOCH MILL ROAD, LITITZ, PA 17543

LOCATION US 21 SOUTH, TL MURDOCK ROAD, TR HOOVER ROAD, ~1000' ON RIGHT AT # 162

SUBDIVISION _____ BLOCK / SECTION _____ LOT _____ LOT AREA 5.04 ACRES SITE CLASS: P5 DESIGN FLOW 480 L.T.A.R. 0.30 GPD/FT²

Septic Tank: EXISTING Gallons: STB _____ Date _____

Pump Tank: _____ Gallons: PT _____ Date _____

Pump Make: _____ Model _____ Serial No. _____

Nitrification Field: No Fields ___ Square Feet EQUIV 400 Linear Feet 100

No Lines 1 (NEW) Trench Width 36" Max Trench Bottom Depth 36"

☑ New System ☐ Repair ☐ Expansion System Type: I II (III) IV V VI

System Description: 25% REDUCTION GRAVITY

Repair System Description: 25% REDUCTION PUMP

Maintenance Agreement Required: ☐ Yes ☑ No

Gravel Depth N/A ☑ Gravity ☐ Pressure

☑ House/Mod. Home No. Bedrooms 4

☐ Mobile Home No. Persons ___

☐ Business No. Employees ___

☑ Other _____


Water Supply: ☑ Individual ☐ Public ☐ Community WELL

☐ Slab ☑ Crawl Space ☐ Basement w/plumbing ☐ Basement wo/plumbing


Comments:/Conditions: INSTALL NEW 3'x100' DRAINLINE ON CONTOUR USING 25% REDUCTION SYSTEM AS SHOWN.

Comments:/Conditions:

INITIAL SITE SKETCH

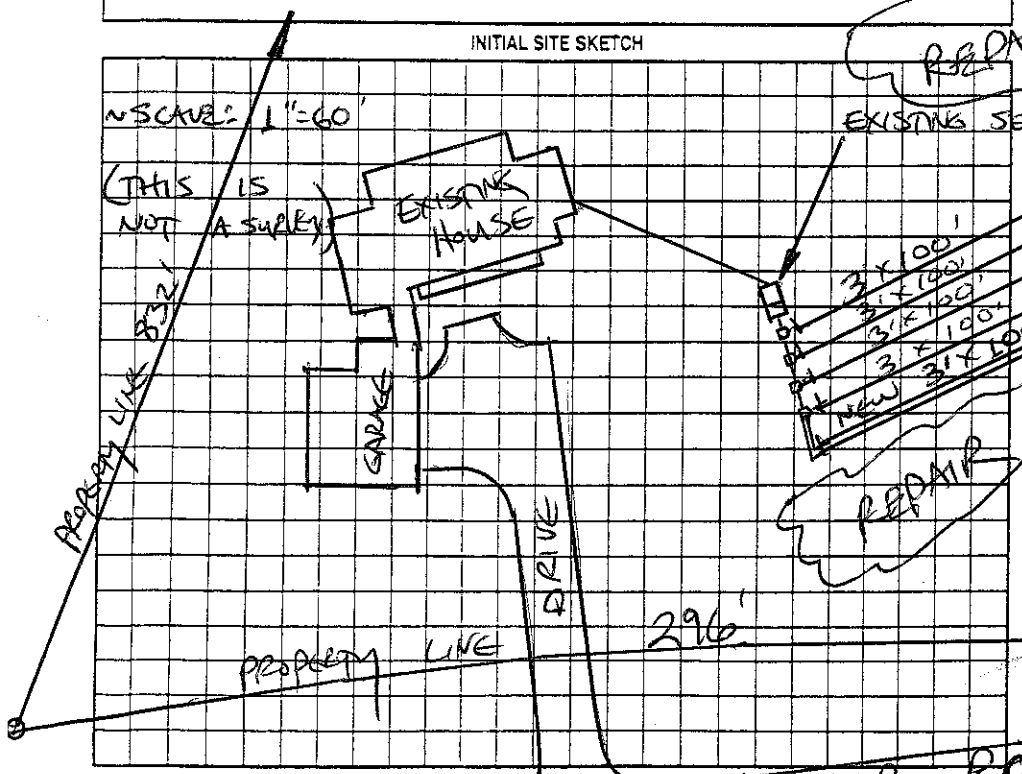

AS BUILT SKETCH

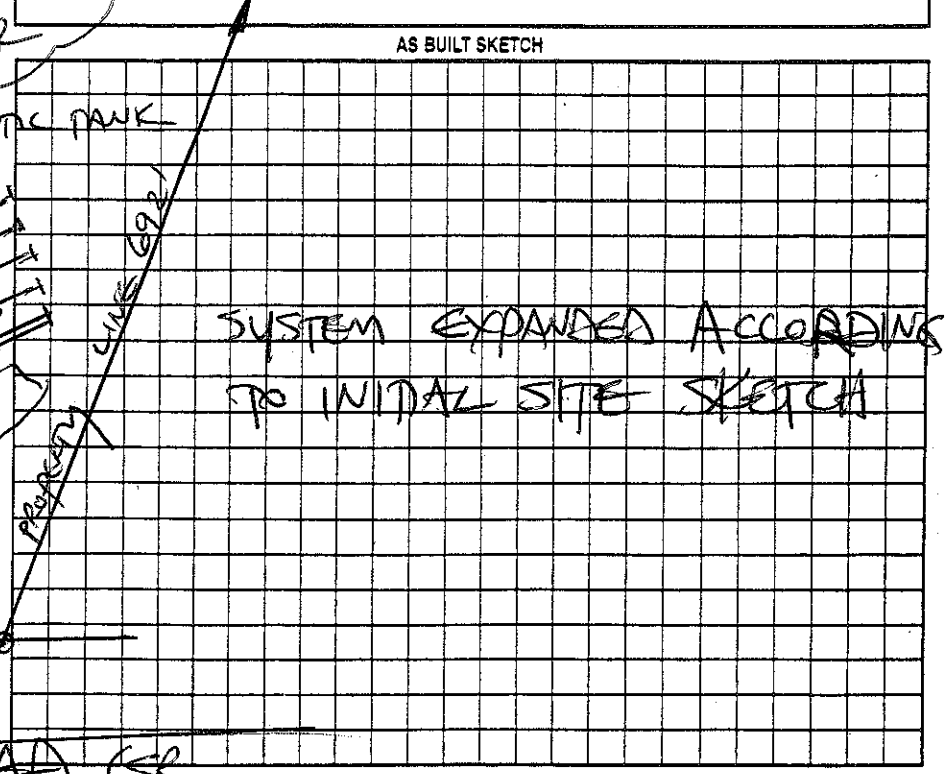

Permit can be suspended or revoked if any false information is supplied toward securing the permit, any unauthorized changes are made to the site/any unauthorized changes are made in the installation of the system. Improvement Permit with plat valid without expiration ☐ Improvement Permit with site plan valid for sixty months ☑ Authorization to Construct is valid for a period equal to that of Improvement Permit – not to exceed sixty months.

Signed: _____ date _____

Improvement Permit by: STEVE HENDRICK date 1-11-08

Authorization to Construct by: STEVE HENDRICK date 5-14-08

Installed by: A-1 BACKHOE

Operation Permit by: STEVE HENDRICK date 6-13-08

Existing System Inspection by: _____ date _____

HEALTH DEPT. COPY: WHITE OWNER COPY (FINAL): YELLOW OWNER COPY (INITIAL): PINK