# IREDELL COUNTY HEALTH DEPARTMENT

STATESVILLE 704-878-5305 MOORESVILLE 704-664-5281

## IMPROVEMENT PERMIT / AUTHORIZATION TO CONSTRUCT / OPERATION PERMIT / EXISTING SYSTEM INSPECTION

PERMIT# TROUTMAN ~~#10025~~ #18667 PIN# 4742-42-3277 / ~~4742-42-5567~~ DATE 1-20-04

OWNER OR CONTRACTOR CHRIS WENDT PHONE: Business 704-567-1720 Home 704-528-2685

ADDRESS 135 ENTERPRISE LANE TROUTMAN, NC 28166

LOCATION 21 SOUTH, (L) MURDOCK, (R) HOOVER, 3RD LOT ON RIGHT ≈ 300 YARDS

SUBDIVISION _____ BLOCK / SECTION _____ LOT _____ LOT AREA 10.08AC SITE CLASS. PS DESIGN FLOW 360 L.T.A.R. .3

Septic Tank: 1000 Gallons; STB 1012 Date 11-10-03
Pump Tank: _____ Gallons; PT _____ Date _____
Pump Make: _____ Model _____ Serial No. _____
Nitrification Field: No Fields 1 Square Feet 1200' Linear Feet 400'
No Lines 4x100' Trench Width 36" Max Trench Bottom Depth 36" Gravel Depth 12"

☒ New System ☐ Repair System Type: I, II, III, IV, V, VI
System Description: LOW PRESS
Repair System Description: LPP 25% REDUCT
Maintenance Agreement Required: ☐ Yes ☒ No


☒ House/Mod. Home No. Bedrooms 3
☐ Mobile Home No. Bathrooms 3
☐ Business No. Employees ____
☐ Other _____
☐ Slab ☐ Crawl Space ☐ Basement w/plumbing ☒ Basement wo/plumbing

Water Supply: ☒ Individual ☐ Public ☐ Community


Comments:/Conditions: (1) SYSTEM & HOUSE IS FLAGGED OUT ENTIRELY & SURVEYED ON A PLAT (2) MAINTAIN SETBACKS (3) INSTALL LINES ON CONTOURS (4) IT IS ≈20' FROM STUBOUT TO THE DRAINFIELD & THERE IS 6' OF FALL.

Comments:/Conditions: (5) SYSTEM DRAWN OUT ENTIRELY ON THE FIRST LOT MAINTAINS PROPER SETBACKS, OWNER PURCHASED BOTH LOTS & WILL HAVE THEM DEEDED AS ONE LOT

INITIAL SITE SKETCH

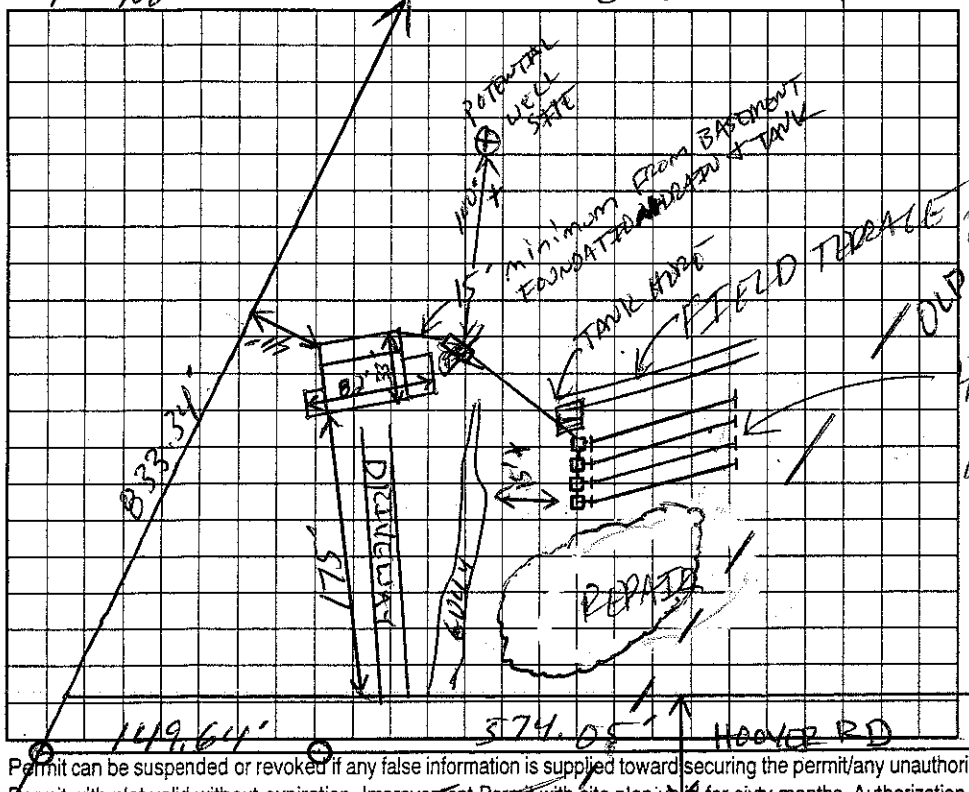


AS BUILT SKETCH

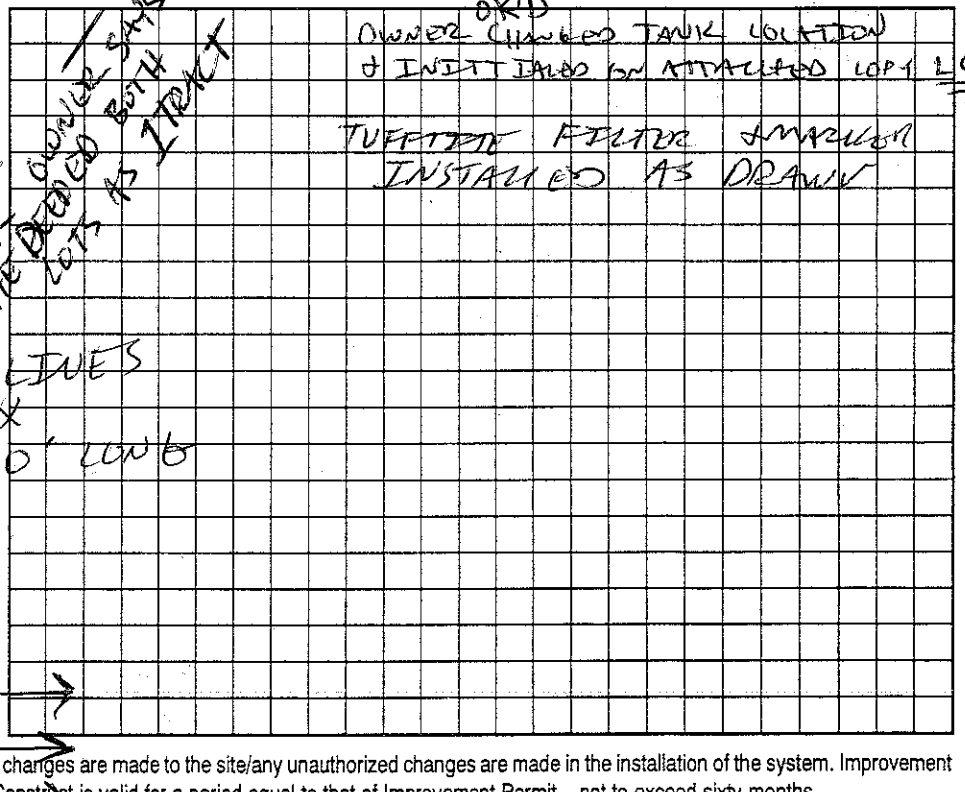


Permit can be suspended or revoked if any false information is supplied toward securing the permit/any unauthorized changes are made to the site/any unauthorized changes are made in the installation of the system. Improvement Permit with plat valid without expiration. Improvement Permit with site plan valid for sixty months. Authorization to Construct is valid for a period equal to that of Improvement Permit – not to exceed sixty months.

Signed: _____ date 1/20/04 Installed by: A-1 BACKHOE

Improvement Permit by: _____ date 1-20-04 Operation Permit by: _____ date 4-29-04

Authorization to Construct by: _____ date 1-20-04 Existing System Inspection by: _____ date _____

HEALTH DEPT. COPY: WHITE OWNER COPY (FINAL): YELLOW OWNER COPY (INITIAL): PINK