IREDELL COUNTY HEALTH DEPARTMENT

STATESVILLE 704-878-5305 MOORESVILLE 704-664-5281

IMPROVEMENT PERMIT / AUTHORIZATION TO CONSTRUCT / OPERATION PERMIT / EXISTING SYSTEM INSPECTION

PERMIT# REPAIR PIN# 4742-43-3426 DATE 1-6-06

OWNER OR CONTRACTOR ROBERT W. WYATT PHONE: Business 704-361-6957 Home 704-924-9056

ADDRESS 389 DUCK CREEK ROAD, TROUTMAN, NC 28166-8505

LOCATION US 21 SOUTH, TL MURDOCK ROAD, ON LEFT AT DUCK CREEK ROAD.

SUBDIVISION DUCK CREEK AC BLOCK / SECTION ____ LOT 4 LOT AREA 0.71 ACRE SITE CLASS. PS DESIGN FLOW 600 L.T.A.R. 0.30 GPD/FT²

Septic Tank: EXISTING Gallons; STB ____ Date ____

Pump Tank: ____ Gallons; PT ____ Date ____

Pump Make: ____ Model ____ Serial No. ____

Nitrification Field: No Fields 1 Square Feet 800 Linear Feet 200

No Lines TWO Trench Width 36" Max Trench Bottom Depth 36" Gravel Depth N/A

☐ New System ☑ Repair System Type: I, II, III, IV, V, VI

System Description: ____

Repair System Description: 25% REDUCTION

Maintenance Agreement Required: ☐ Yes ☑ No GRAVITY

☑ House/Mod. Home No. Bedrooms 5

☐ Mobile Home No. Bathrooms ____

☐ Business No. Employees ____

☐ Other ____


☐ Slab ☑ Crawl Space ☐ Basement w/plumbing ☐ Basement wo/plumbing

Water Supply: ☑ Individual ☐ Public ☐ Community WELL


Comments:/Conditions: ① CONSTRUCT DAMS IN EXISTING DRAINLINES AS SHOWN ② INSTALL NEW DRAINLINES ON CONTOUR USING 25% REDUCTION SYSTEM ③ THIS PERMIT SERVES AS NOTICE OF VIOLATION, TO BE REPAIRED BY 2-6-06

Comments:/Conditions:

INITIAL SITE SKETCH

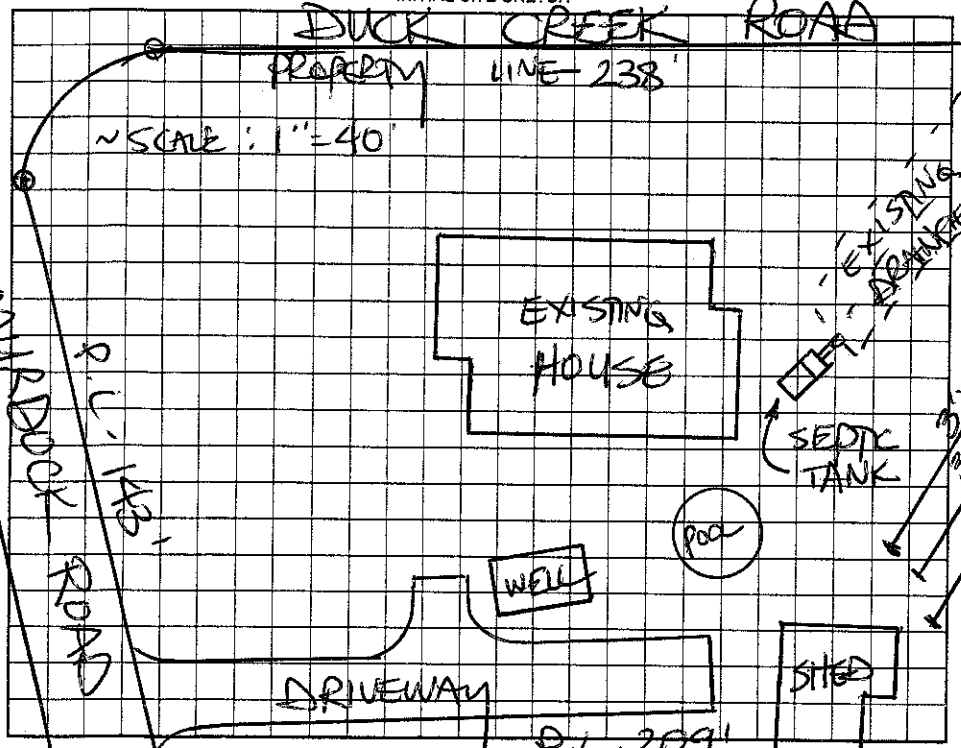

AS BUILT SKETCH

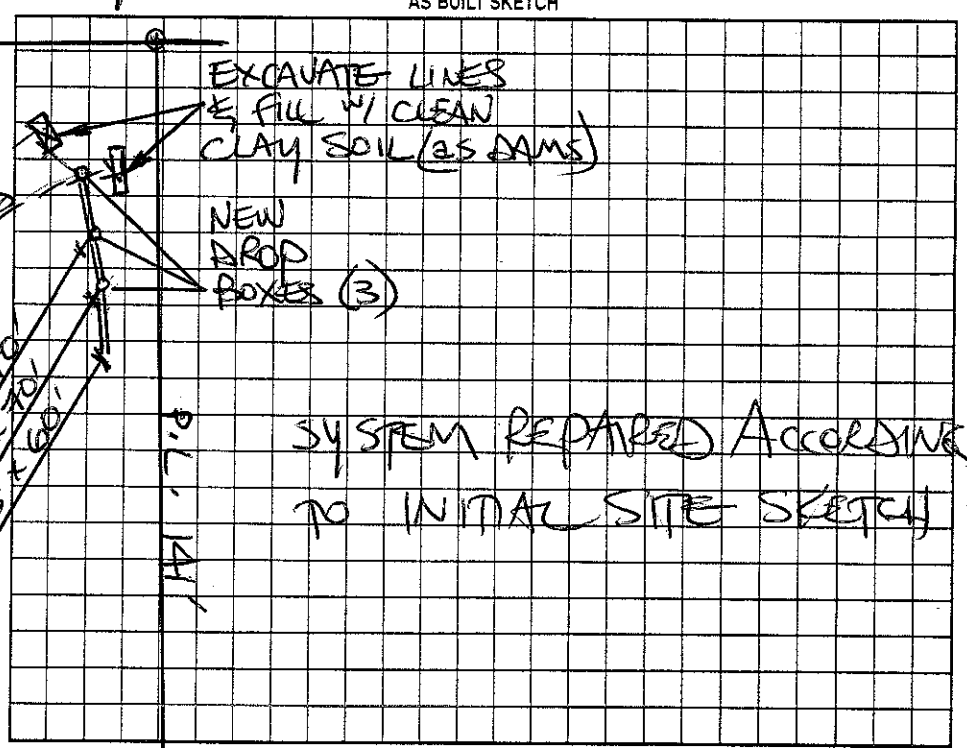

Permit can be suspended or revoked if any false information is supplied toward securing the permit/any unauthorized changes are made to the site/any unauthorized changes are made in the installation of the system. Improvement Permit with plat valid without expiration. Improvement Permit with site plan valid for sixty months. Authorization to Construct is valid for a period equal to that of Improvement Permit – not to exceed sixty months.

Signed: X RW Wyatt date 1-6-06 Installed by: A-1 BACKHOE

Improvement Permit by: STEVE HEDRICK date 1-6-06 Operation Permit by: STEVE HEDRICK date 1-20-06

Authorization to Construct by: STEVE HEDRICK date 1-6-06 Existing System Inspection by: ____ date ____

HEALTH DEPT. COPY: WHITE OWNER COPY (FINAL): YELLOW OWNER COPY (INITIAL): PINK