IREDELL COUNTY HEALTH DEPARTMENT

STATESVILLE 704-878-5305 MOORESVILLE 704-664-5281

IMPROVEMENT PERMIT / AUTHORIZATION TO CONSTRUCT / OPERATION PERMIT / EXISTING SYSTEM INSPECTION

PERMIT# REPAIR PIN# 4742-43-4479 DATE 1-6-06

OWNER OR CONTRACTOR GREGORY I. GREENWALSH PHONE: Business 908-963-5525 Home 704-875-2064

ADDRESS 525 MURDOCK ROAD, TROUTMAN, NC 28166

LOCATION US 21 SOUTH, TL MURDOCK ROAD, ON LEFT ACROSS FROM HOOVER ROAD AT #525

SUBDIVISION _____ BLOCK / SECTION _____ LOT _____ LOT AREA 0.66 ACRE SITE CLASS. PS DESIGN FLOW 360 L.T.A.R. 0.30 GPD/FT²

Septic Tank: EXISTING Gallons; STB _____ Date _____

Pump Tank: _____ Gallons; PT _____ Date _____

Pump Make: _____ Model _____ Serial No. _____

Nitrification Field: No Fields 1 Square Feet EQ. TO 800 Linear Feet 200

No Lines THREE Trench Width 36" Max Trench Bottom Depth 36" +/- Gravel Depth N/A

☐ New System ☑ Repair System Type: I, (II), III, IV, V, VI

System Description: _____

Repair System Description: 25% REDUCTION, GRAVITY

Maintenance Agreement Required: ☐ Yes ☑ No

☑ House/Mod. Home No. Bedrooms 3

☐ Mobile Home No. Bathrooms ____

☐ Business No. Employees ____

☐ Other _____


☐ Slab ☐ Crawl Space ☑ Basement w/plumbing ☐ Basement wo/plumbing

Water Supply: ☑ Individual ☐ Public ☐ Community WELL


Comments:/Conditions: ① REPLACE SANITARY TEE IN SEPTIC TANK IF NECESSARY ② INSTALL NEW DRAINLINES AS FLAGGED ON SITE USING 25% REDUCTION SYSTEM

Comments:/Conditions: NEW GUTTER DRAINS INSTALLED

INITIAL SITE SKETCH

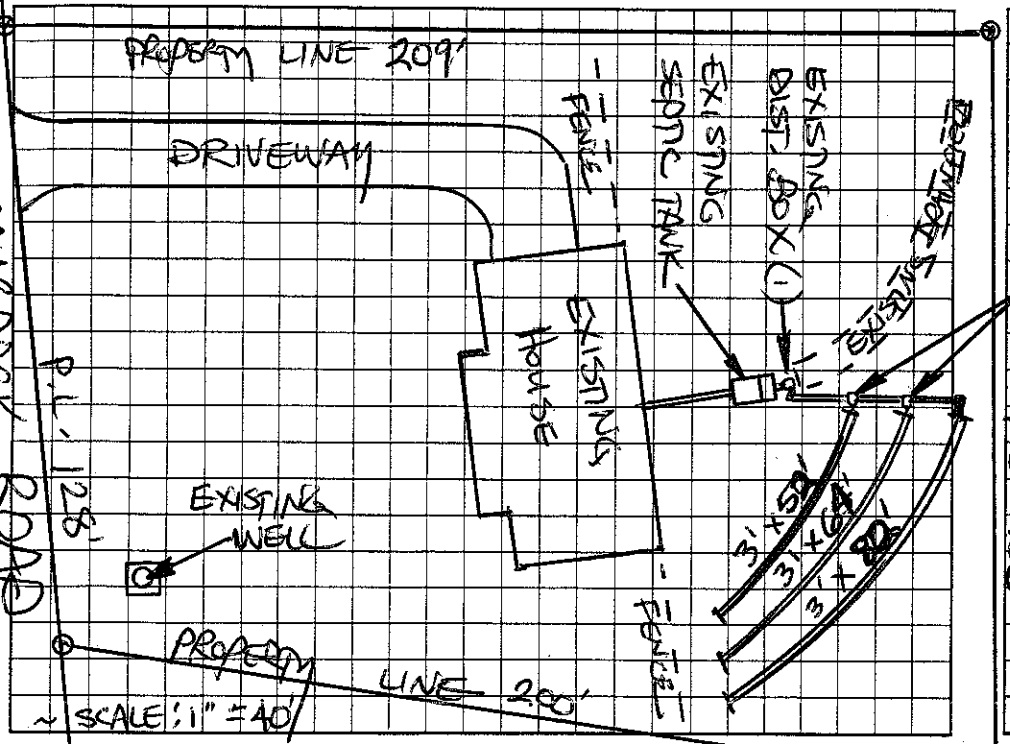

AS BUILT SKETCH

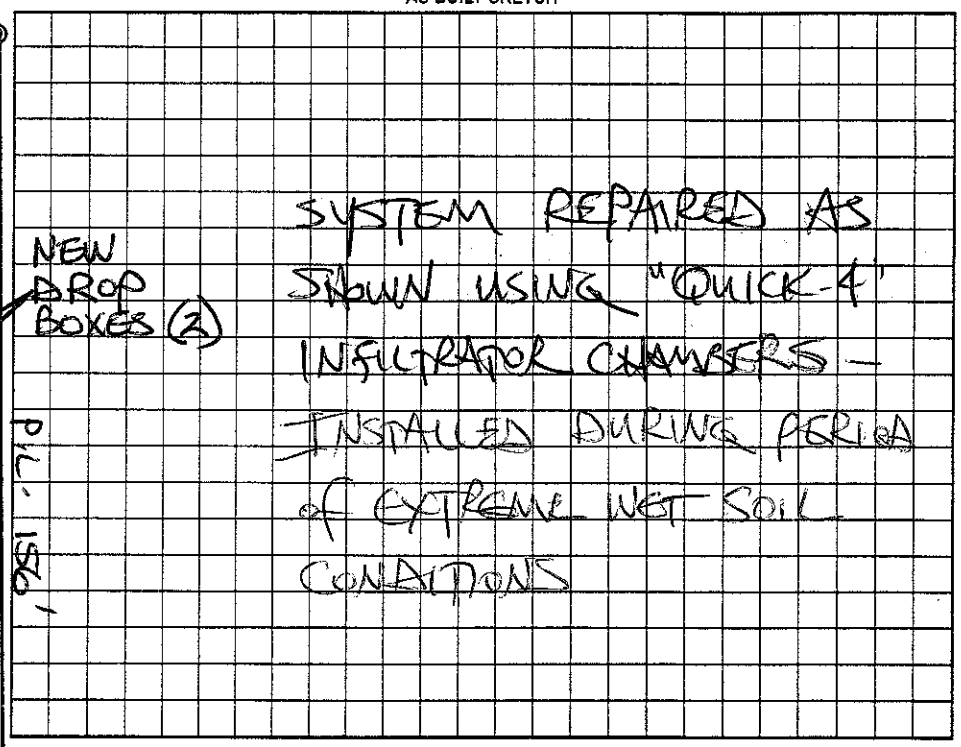

Permit can be suspended or revoked if any false information is supplied toward securing the permit/any unauthorized changes are made to the site/any unauthorized changes are made in the installation of the system. Improvement Permit with plat valid without expiration. Improvement Permit with site plan valid for sixty months. Authorization to Construct is valid for a period equal to that of Improvement Permit – not to exceed sixty months.

Signed: T Gregory I Greenwalsh date 1/6/06

Improvement Permit by: STEVE HEDRICK date 1-6-06

Authorization to Construct by: STEVE HEDRICK date 1-6-06

Installed by: A-1 BACKHOE

Operation Permit by: STEVE HEDRICK date 1-13-06

Existing System Inspection by: _____ date _____

HEALTH DEPT. COPY: WHITE OWNER COPY (FINAL): YELLOW OWNER COPY (INITIAL): PINK