IREDELL COUNTY HEALTH DEPARTMENT

STATESVILLE 704-878-5305 (@) MOORESVILLE 704-664-5281

IMPROVEMENT PERMIT / AUTHORIZATION TO CONSTRUCT / OPERATION PERMIT / EXISTING SYSTEM INSPECTION

PERMIT # 154710 PIN # 4742434606 DATE 2-12-09

OWNER or APPLICANT Hettie L Carroll PHONE: Business 704-380-2401 Home: 704-450-3716

OWNER or APPLICANT ADDRESS 373 DUCK CREEK Rd Troutman NC 28166

LOCATION / DIRECTIONS 77 SOUTH (R) Amity Hill (L) NWOODUK (R) DUCK CREEK 2ND LOT OURT

SUBDIVISION _____ BLOCK / SECTION _____ LOT # 3 LOT AREA _____ DESIGN FLOW 360 L.T.A.R. 13

Septic Tank 1000 Gallons: STB 1012 Date 8/23/00

Pump Tank _____ Gallons: P T _____ Date _____

Pump Make _____ Model _____ Serial # _____

Nitrification Field No Fields 1 No Lines 5 Linear Feet 400'+

Trench Width 36" Max. Trench Bottom Depth 36" Gravel Depth 12" ☒ GRAVITY ☐ PRESSURE

☐ New System ☐ Repair ☐ Expansion System Type I (II) III IV V VI

System Description: GRAVITY CONVENTIONAL

Repair System Description: GRAVITY LOW / INOP

Maintenance Agreement Required ☐ YES ☒ NO

☒ Residence No. Bedrooms 3 ☐ Business No. Persons _____ ☐ Other No. Employees _____

☐ Slab ☐ Crawl Space ☐ Basement w/plumbing ☐ Basement w/o plumbing

Water Supply: ☒ Private ☐ Public ☐ Community

Comments / Conditions (1) This is a properly functioning system at time of check. NO SIGNS OF FAILURE AND HOME WAS NOT IN PLACE. (2) Home IS SAME SIZE AS OLD ONE & WILL BE PUT IN

Comments / Conditions SAME LOCATION.

INITIAL SITE SKETCH

SEE ATTACHED EXISTING SYSTEM CHECK

AS BUILT SKETCH

Permit can be suspended or revoked if any false information is supplied toward securing the permit / any unauthorized changes are made to the site / any unauthorized changes are made in the installation of the system.

☐ *IMPROVEMENT PERMIT w / plat valid without expiration.* ☐ *IMPROVEMENT PERMIT w / site plan valid for 60 mos.* ☐ *AUTHORIZATION TO CONSTRUCT valid for period equal to IMPROVEMENT PERMIT-not to exceed 60 mo.*

Owner / Applicant Signature: Hettie L Carroll Date 2/13/09

Improvement Permit by: _____ Date _____

Authorization to Construct by: _____ Date _____

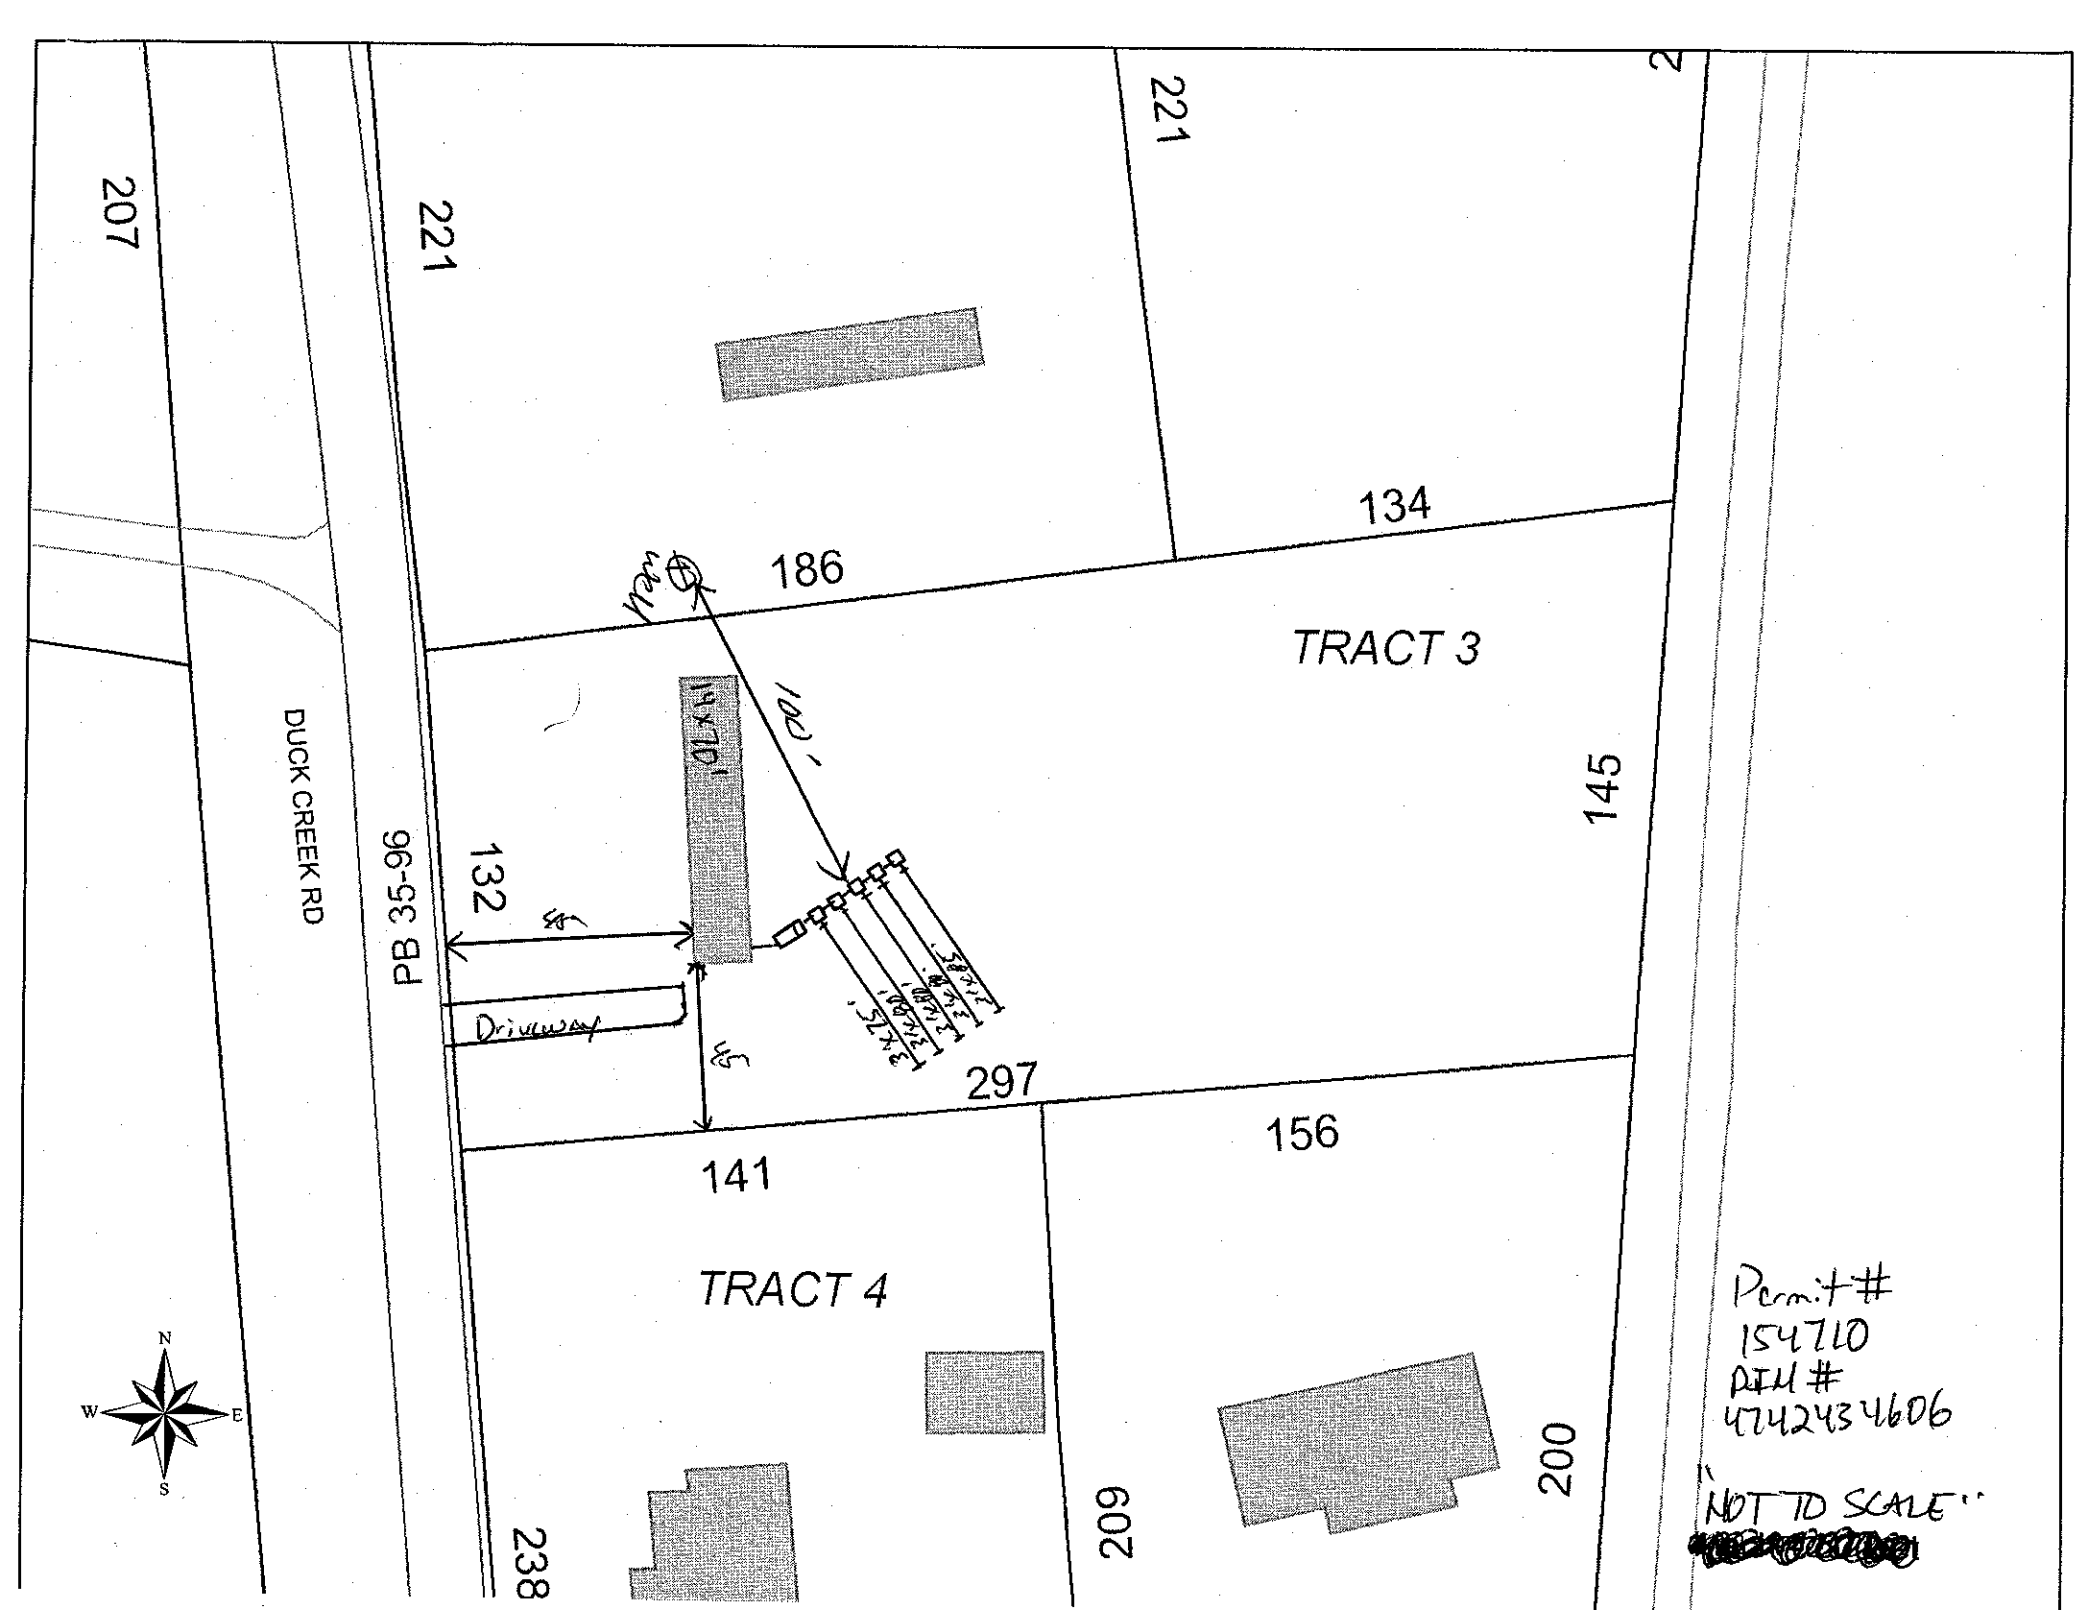
YOU SHOULD CONTACT A LOCATOR SERVICE PRIOR TO ANY EXCAVATION.

Installed by: _____

Operation Permit by: _____ Date: _____

Existing System Inspected by: _____ Date: 2-12-09

WHITE COPY Environmental Health YELLOW COPY (Final) Owner / Applicant PINK COPY (Initial) Owner / Applicant


207
221
221
134
186
TRACT 3
145
DUCK CREEK RD
PB 35-96
132
14x70'
100'
48'
Driveway
45'
297
156
141
TRACT 4
209
200
238
N
W
E
S
Permit #
154710
PIN #
4742434606
"NOT TO SCALE"