IREDELL COUNTY HEALTH DEPARTMENT

STATESVILLE 704-878-5305 MOORESVILLE 704-664-5281

IMPROVEMENT PERMIT / AUTHORIZATION TO CONSTRUCT / OPERATION PERMIT / EXISTING SYSTEM INSPECTION

PERMIT# 089868 PIN# 4742434886 DATE 6/28/2000

OWNER OR CONTRACTOR Lonnie Troutman PHONE: Business 873-5233 Home

ADDRESS 232 Davie Ave Statesville, NC 28677

LOCATION Hwy 115 S TL Murdock TL Duck Creek on right

SUBDIVISION Duck Creek Acres BLOCK / SECTION LOT 2 LOT AREA 1.0 Acre SITE CLASS IPS DESIGN FLOW 360 gpd L.T.A.R. .3

Septic Tank: 1000 Gallons; STB 1612 Date 8-29-00
Pump Tank: Gallons; PT Date
Pump Make: Model Serial No.
Nitrification Field: No Fields 1 Square Feet 1200' Linear Feet 400'
No Lines 3 at 133' Trench Width 36" Max Trench Bottom Depth 36" Gravel Depth 12"

[X] New System [ ] Repair System Type: (I) II, IV, V, VI
System Description: Gravity-Conventional
Repair System Description: Same
Maintenance Agreement Required: [ ] Yes [X] No
[ ] Slab [X] Crawl Space [ ] Basement w/plumbing [ ] Basement wo/plumbing

[X] House/Mod. Home No. Bedrooms 3
[ ] Mobile Home No. Bathrooms 2
[ ] Business No. Employees
[ ] Other


Water Supply: [X] Individual Shared [ ] Public [ ] Community

Comments/Conditions: Keep Septic System at least 10' from PL, 5' from MH & at least 10' from water line.

Comments/Conditions: SEPTIC TANK INSTALLED W/RISERS USING "POLY LOK" FILTER

INITIAL SITE SKETCH

Scale 1:60

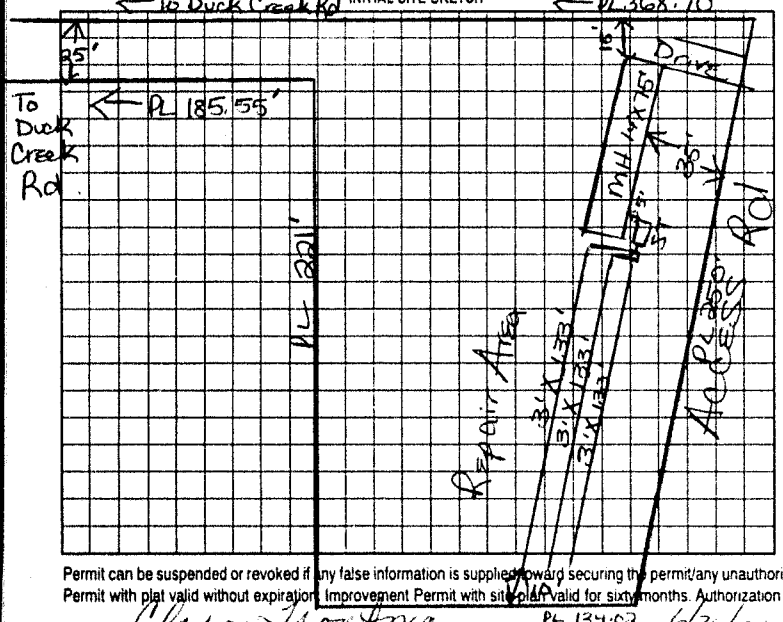

AS BUILT SKETCH

SYSTEM INSTALLED ACCORDING TO INITIAL SITE SKETCH

Permit can be suspended or revoked if any false information is supplied toward securing the permit/any unauthorized changes are made to the site/any unauthorized changes are made in the installation of the system. Improvement Permit with plat valid without expiration. Improvement Permit with site plan valid for sixty months. Authorization to Construct is valid for a period equal to that of Improvement Permit – not to exceed sixty months.

Signed: Clara Troutman date 6/30/00 Installed by: STEVE JORDAN

Improvement Permit by: Maina M. Dotson RS date 6/28/00 Operation Permit by: STEVE HEDRICK date 10-4-00

Authorization to Construct by: Maina M. Dotson RS date 6/28/00 Existing System Inspection by: date

HEALTH DEPT. COPY: WHITE OWNER COPY (FINAL): YELLOW OWNER COPY (INITIAL): PINK