IREDELL COUNTY HEALTH DEPARTMENT

STATESVILLE 704-878-5305 MOORESVILLE 704-664-5281

IMPROVEMENT PERMIT / AUTHORIZATION TO CONSTRUCT / OPERATION PERMIT / EXISTING SYSTEM INSPECTION

PERMIT# REPAIR PIN# 4742-43-9723 DATE MAY 4, 2007

OWNER OR APPLICANT DENNIS K. MURDOCK PHONE: Business Home

ADDRESS 547 MURDOCK ROAD TROUTMAN, NC 28166

LOCATION US 21 SOUTH, TL MURDOCK ROAD ON LEFT AT BOX # 547

SUBDIVISION BLOCK / SECTION LOT LOT AREA ~3 ACRES SITE CLASS PS DESIGN FLOW 360 L.T.A.R. 0.30 GPD/FT²

Septic Tank: EXISTING Gallons: STB Date

Pump Tank: Gallons: PT Date

Pump Make: Model ee-po Serial No.

Nitrification Field: No Fields 1 Square Feet 1200 Linear Feet 300

No Lines FOUR Trench Width 36" Max Trench Bottom Depth 36" Gravel Depth N/A ☐ Gravity ☐ Pressure

☐ New System ☑ Repair ☐ Expansion System Type: I II III IV V VI

System Description:

Repair System Description: 25% REDUCTION, GRAY

Maintenance Agreement Required: ☐ Yes ☑ No

☑ House/Mod. Home No. Bedrooms 3

☐ Mobile Home No. Persons

☐ Business No. Employees

☐ Other


☐ Slab ☑ Crawl Space ☐ Basement w/plumbing ☑ Basement wo/plumbing

Water Supply: ☑ Individual ☐ Public ☐ Community WELL


Comments:/Conditions: ① INSTALL 25% REDUCTION SYSTEM ON CONTOUR AS FLAGGED ② INSTALL NEW SANITARY TEE IN SEPTIC TANK IF NECESSARY ③ THIS PERMIT SERVES AS NOTICE of VIOLATION – TO BE REPAIRED BY JUNE 8, 2007

Comments:/Conditions: SYSTEM REPAIRED ACCORDING TO INITAL SITE SKETCH

INITIAL SITE SKETCH

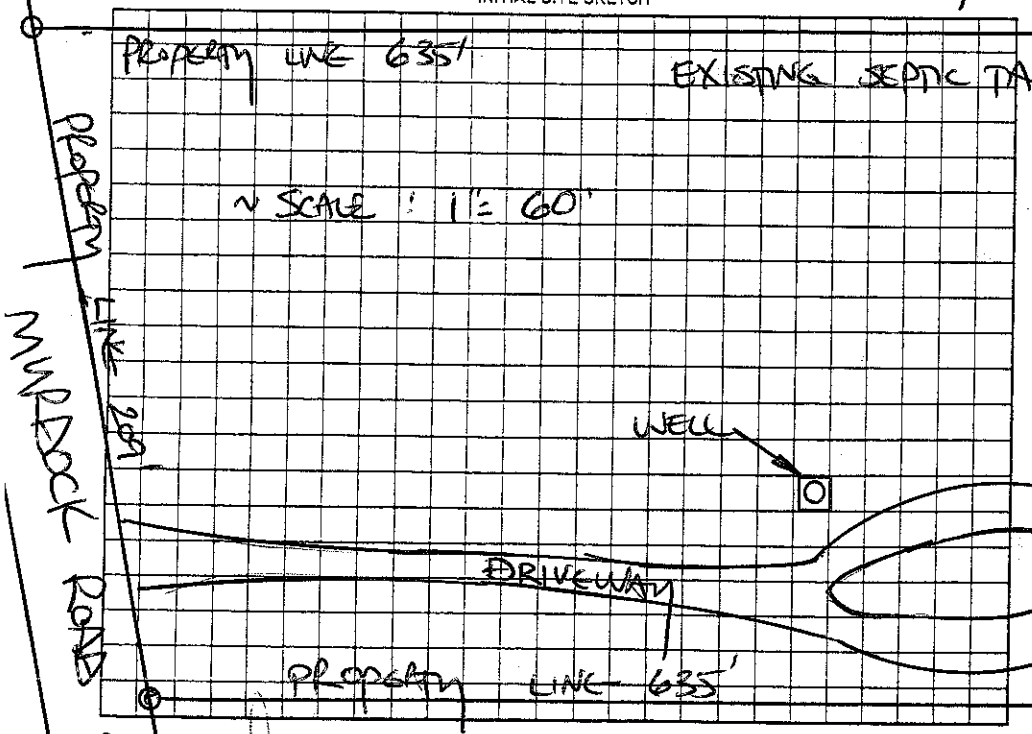

AS BUILT SKETCH

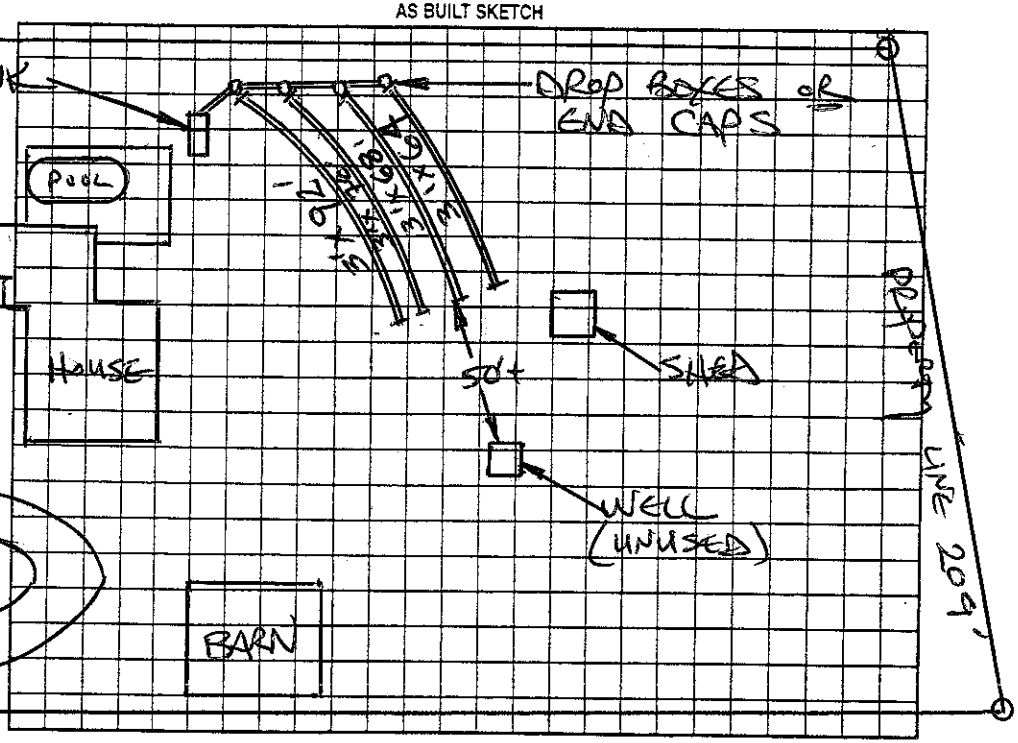

Permit can be suspended or revoked if any false information is supplied toward securing the permit/any unauthorized changes are made to the site/any unauthorized changes are made in the installation of the system. Improvement Permit with plat valid without expiration. ☐ Improvement Permit with site plan valid for sixty months ☑ Authorization to Construct is valid for a period equal to that of Improvement Permit – not to exceed sixty months.

Signed: date 5-4-07 Installed by: JAMES HUMER

Improvement Permit by: STEVE HENDRICK date 5-4-07 Operation Permit by: STEVE HENDRICK date 5-14-07

Authorization to Construct by: STEVE HENDRICK date 5-4-07 Existing System Inspection by: date

HEALTH DEPT. COPY: WHITE OWNER COPY (FINAL): YELLOW OWNER COPY (INITIAL): PINK