# IREDELL COUNTY HEALTH DEPARTMENT

STATESVILLE 704-878-5305 MOORESVILLE 704-664-5281

## IMPROVEMENT PERMIT / CERTIFICATE OF COMPLETION / OPERATION PERMIT / EXISTING SYSTEM INSPECTION

PROPERTY DESCRIPTION NO. 25879 X05919 DATE 1-17-97 TAX MAP NO. 4742-44-3869 Watershed: ☐ Yes ☐ No

OWNER OR CONTRACTOR Billy Smith PHONE: Business Home 663-1663

ADDRESS 117 Lawnhaven Rd Mooresville

LOCATION I-77 S TR Amity Hill TL Murdock TR Duck Creek 1/4mi Rt.

SUBDIVISION BLOCK / SECTION LOT LOT AREA 140' X 233' SITE CLASS. PS DESIGN FLOW 360 L.T.A.R. .125

Septic Tank: 1000 Gallons; STB 825 Date 5-12-97

Pump Tank: Gallons; PT Date

Pump Make: Model Serial No.

Nitrification Field: No Fields 1 Square Feet 1440 Linear Feet 480

No Lines 4 Trench Width 36" Max Trench Bottom Depth 36" Gravel Depth 12"

☐ New System ☐ Repair System Type: I, II, III, IV, V, VI

System Description: Conv. Gravity

Repair System Description: Gravity Chambers

Maintenance Agreement Required: ☐ Yes ☐ No

☑ House/Mod. Home ☐ Mobile Home ☐ Business ☐ Other

No. Bedrooms 3 No. Bathrooms 2 No. Employees


☐ Slab ☑ Crawl Space ☐ Basement w/plumbing ☐ Basement wo/plumbing

Water Supply: ☑ Individual ☐ Community ☐ Public


Comments:

Comments:

INITIAL SITE SKETCH

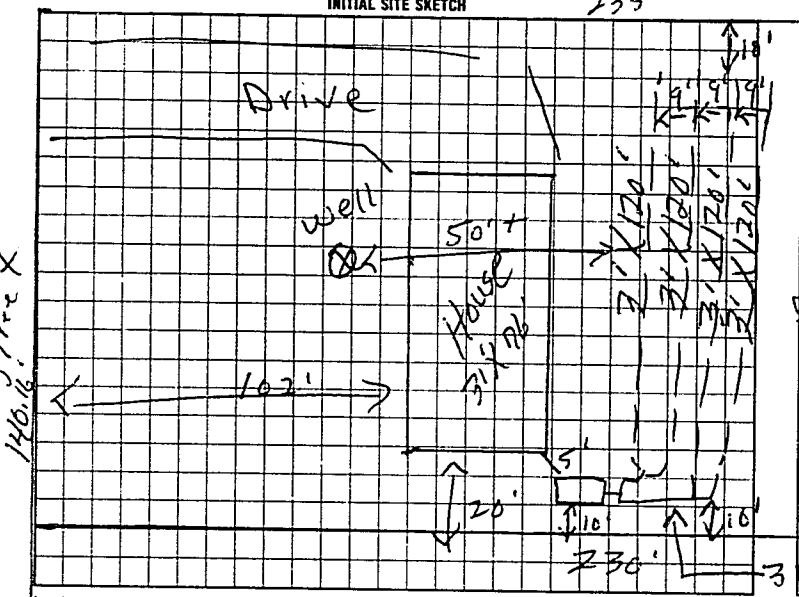


AS BUILT SKETCH

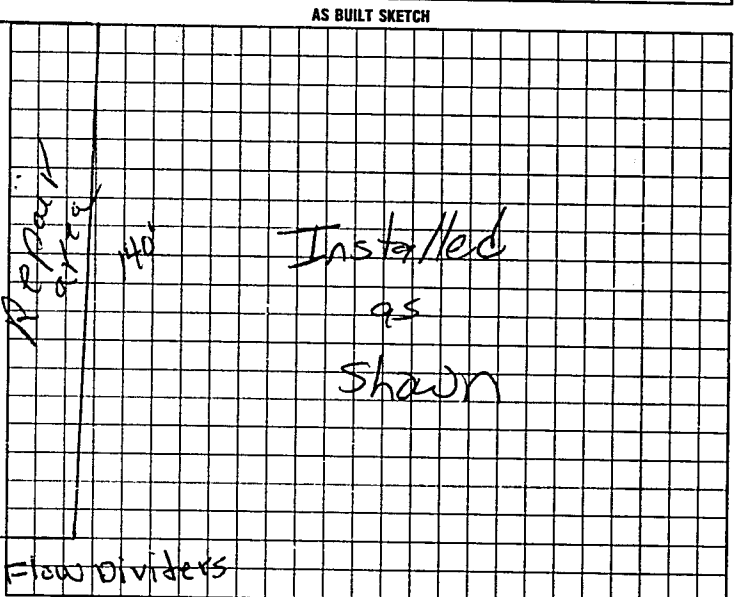


I understand that this permit can be suspended or revoked if any false information is supplied toward securing the permit/any unauthorized changes are made to the site/any unauthorized changes are made in the installation of the system. Improvement Permit is valid for 60 months from date of issuance.

Signed: X William L Smith

Improvement Permit by: C. Moore date 1-17-97

Authorization to Construct by: C. Moore date 1-17-97

Existing System Inspection by: C. Moore date 1-17-97

Installed by: Delbert Boston

Certificate of Completion by: date

Operation Permit by: Mat C Ortz date 7-22-97

TO CONSTR. HEALTH DEPT COPY WHITE INSPECTION COPY (FINAL) GREEN OWNER COPY (FINAL) YELLOW INSPECTION COPY (INITIAL) PINK OWNER COPY (INITIAL) BLUE

authorization to const. EXPIRES 60 MOS. FROM ISSUE

L59200