IREDELL COUNTY HEALTH DEPARTMENT

STATESVILLE 704-878-5305 MOORESVILLE 704-664-5281

IMPROVEMENT PERMIT / CERTIFICATE OF COMPLETION / OPERATION PERMIT / EXISTING SYSTEM INSPECTION

PROPERTY DESCRIPTION NO. 66110 DATE 6-3-97 TAX MAP NO. 4742480242 Watershed: ☐ Yes ☐ No

OWNER OR CONTRACTOR [redacted] Brian Ivey PHONE: Business _____ Home 528-5113

ADDRESS 459 moose club Rd Sta.

LOCATION I-77 S TR Amity Hill TL murdock Rd TR Duck Creek TR wintergreen 1/8mi Rt.

SUBDIVISION Smith Property BLOCK / SECTION _____ LOT 3 LOT AREA 1.02 acres SITE CLASS. PS DESIGN FLOW 360 L.T.A.R. .3

Septic Tank: 1000 Gallons; STB 794 Date 2-24-98

Pump Tank: _____ Gallons; PT _____ Date _____

Pump Make: _____ Model _____ Serial No. _____

Nitrification Field: No Fields 1 Square Feet 1780 Linear Feet 450

No Lines 5 Trench Width 36" Max Trench Bottom Depth 36" Gravel Depth 12"

☑ New System ☐ Repair System Type: I, II, III, IV, V, VI

System Description: conv. Gravity

Repair System Description: Pump to Chambers

Maintenance Agreement Required: ☐ Yes ☑ No

☑ House/Mod. Home No. Bedrooms 3

☐ Mobile Home No. Bathrooms 2

☐ Business No. Employees _____

☐ Other _____


☐ Slab ☑ Crawl Space ☐ Basement w/plumbing ☐ Basement wo/plumbing

Water Supply: ☑ Individual ☐ Community ☐ Public


Comments:

Comments: Installer offset 60' of drain line to system

INITIAL SITE SKETCH

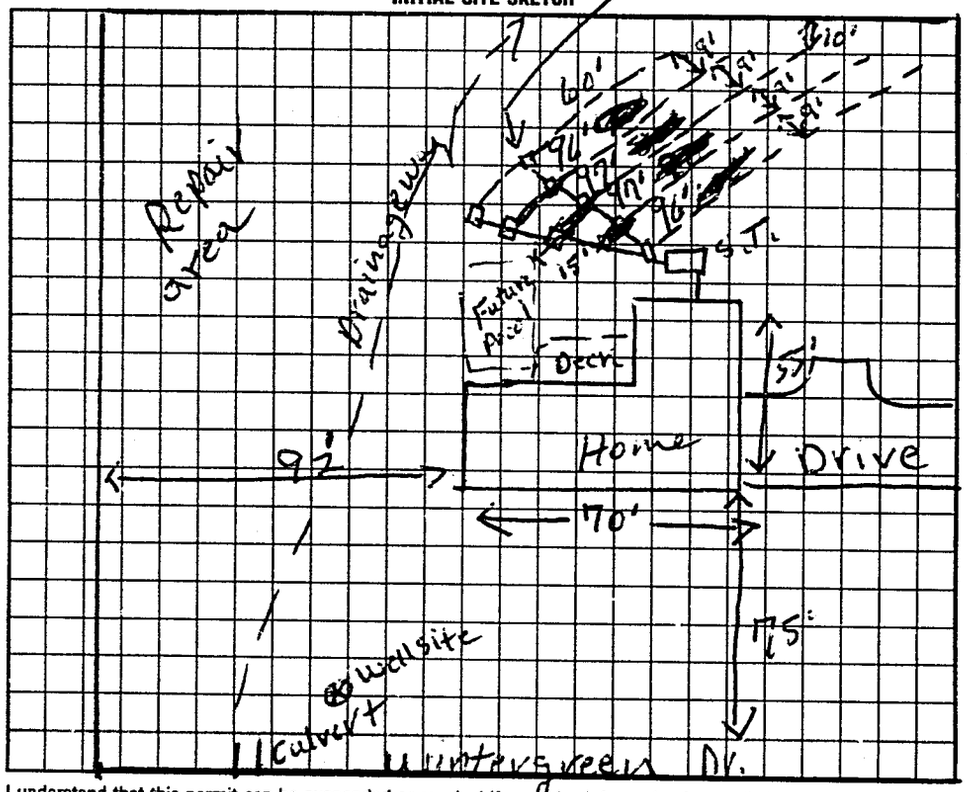

AS BUILT SKETCH

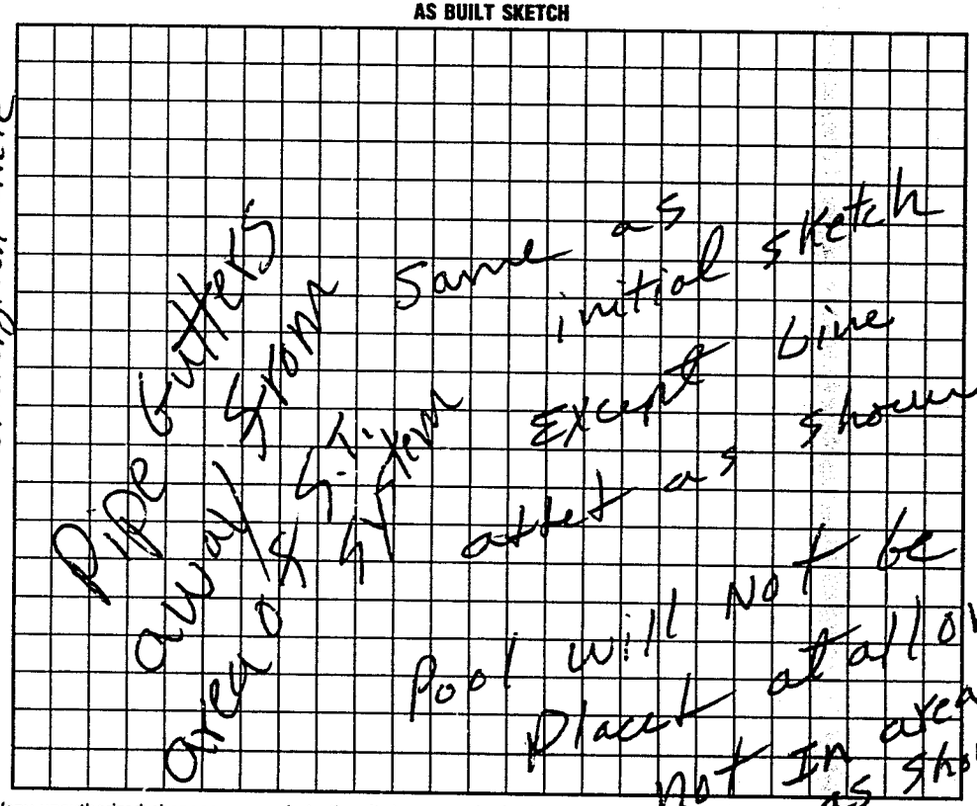

I understand that this permit can be suspended or revoked if any false information is supplied toward securing the permit/any unauthorized changes are made to the site/any unauthorized changes are made in the installation of the system. Improvement Permit is valid for 60 months from date of issuance.

Signed: [signature]

Improvement Permit by: R. C. Moore date 6-3-97

Authorization to Construct/Existing System Inspection by: R. C. Moore date 6-3-97

Installed by: Wes Lytton

Certificate of Completion by: _____ date _____

Operation Permit by: R. C. Moore date 3-25-98

HEALTH DEPT. COPY: WHITE INSPECTION COPY (FINAL): GREEN OWNER COPY (FINAL): YELLOW INSPECTION COPY (INITIAL): PINK OWNER COPY (INITIAL): GOLD

Authorization to Const. Expires 60 mos from issue

60 1200