IREDELL COUNTY HEALTH DEPARTMENT

STATESVILLE 704-878-5305 MOORESVILLE 704-664-5281

IMPROVEMENT PERMIT / AUTHORIZATION TO CONSTRUCT / OPERATION PERMIT / EXISTING SYSTEM INSPECTION

PERMIT# 100969 PIN# 4742-48-~~0052~~//~~1077~~//~~2092~~ 1060 DATE 2-6-03

OWNER OR CONTRACTOR DARRYL CORDWINE PHONE: Business Home 704-528-9007

ADDRESS P.O. BOX 1599 TROUTMAN NC 28166

LOCATION US 21S, TL MOOSE CLUB, TR DUCK CREEK, TL WINTERGREEN, BEAR RIGHT, LOTS ON RIGHT

SUBDIVISION OSBORNE SMITH BLOCK / SECTION LOT 8 LOT AREA 3.29 ACRES SITE CLASS PS' DESIGN FLOW 480' L.T.A.R. 0.30 GPD/FT²

Septic Tank: 1000 Gallons; STB 1007 Date 10-8-02

~~Pump~~ SEPTIC Tank: 1000 Gallons STB 1007 Date 11-1-02

Pump Make: Model Serial No.

Nitrification Field: No Fields 1 Square Feet ~~EQ. TO~~ 1600 Linear Feet 400

No Lines FOUR Trench Width 36" Max Trench Bottom Depth 36" Gravel Depth 12"

☑ New System ☐ Repair System Type: I, II, (III), IV, V, VI

System Description: 25% REDUCTION, GRAVITY

Repair System Description: 25% REDUCTION, PUMP

Maintenance Agreement Required: ☐ Yes ☒ No

~~☐~~ House/Mod. Home ☐ Mobile Home ☐ Business ☐ Other

No. Bedrooms 4 No. Bathrooms 4 No. Employees


☐ Slab ☐ Crawl Space ☑ Basement w/plumbing ☐ Basement wo/plumbing

Water Supply: ☑ Individual ☐ Public ☐ Community WELL

Comments:/Conditions: USE SECOND SEPTIC TANK AS SETTLING TANK FOR BASEMENT PLUMBING DELIVERED VIA LIFT (GRINDER) PUMP

Comments:/Conditions: SEPTIC TANKS WITH MARKERS INSTALLED USING "POLYLOK" FILTERS

INITIAL SITE SKETCH SCALE: 1"=50'

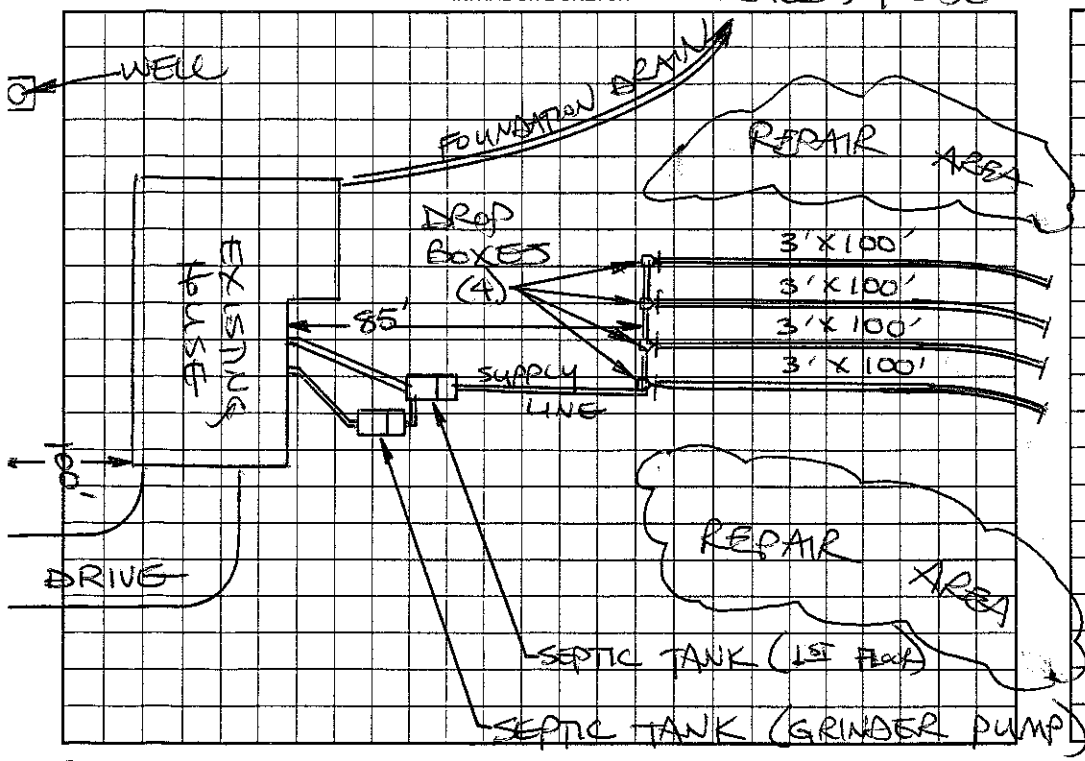

AS BUILT SKETCH

SYSTEM INSTALLED ACCORDING TO INITIAL SITE SKETCH

Permit can be suspended or revoked if any false information is supplied toward securing the permit/any unauthorized changes are made to the site/any unauthorized changes are made in the installation of the system. Improvement Permit with plat valid without expiration. Improvement Permit with site plan valid for sixty months. Authorization to Construct is valid for a period equal to that of Improvement Permit – not to exceed sixty months.

Signed: [signature] date 2-6-03 Installed by: IREDELL BACKHOE & SEPTIC

Improvement Permit by: STEVE HEDRICK date 2-6-03 Operation Permit by: STEVE HEDRICK date 2-12-03

Authorization to Construct by: STEVE HEDRICK date 2-6-03 Existing System Inspection by: date

HEALTH DEPT. COPY: WHITE OWNER COPY (FINAL): YELLOW OWNER COPY (INITIAL): PINK